


# RAY J. HARVIE ANNEXATION MAP

TO THE TOWN OF PARKER  
 LOCATED IN THE NORTHEAST QUARTER OF SECTION 24, TOWNSHIP 6 SOUTH, RANGE 66 WEST OF THE SIXTH PRINCIPAL MERIDIAN,  
 COUNTY OF DOUGLAS, STATE OF COLORADO

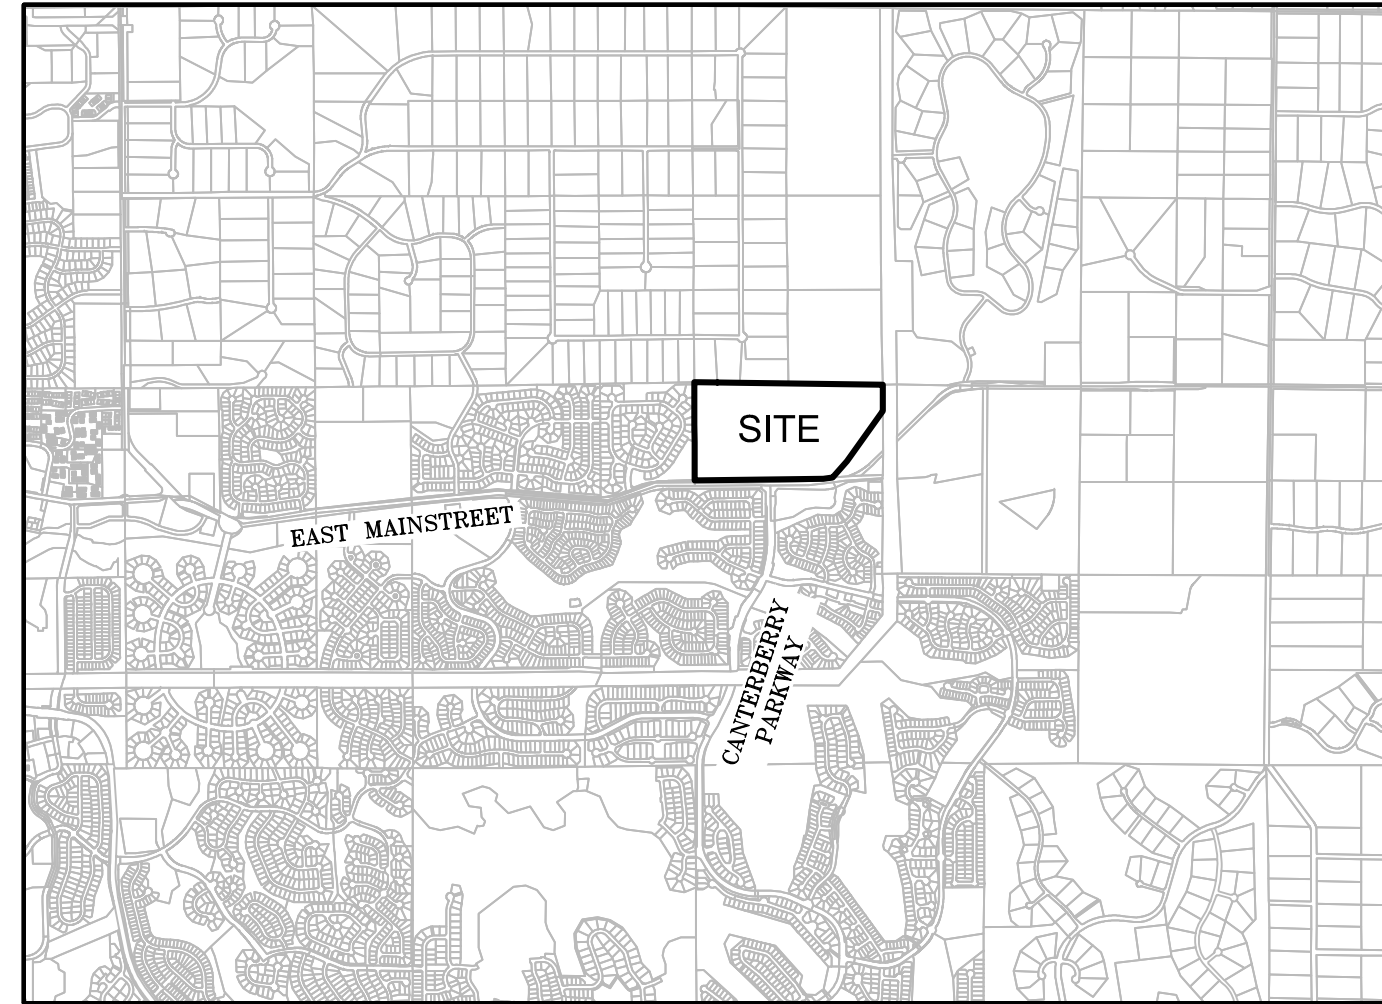

VICINITY MAP  
 SCALE: 1" = 2000'

### LEGAL DESCRIPTION

A PARCEL OF LAND RECORDED AT RECEPTION NO. 2017002715 AND RECEPTION NO. 2017002719 IN THE RECORDS OF THE DOUGLAS COUNTY CLERK AND RECORDERS OFFICE, LYING WITHIN THE NORTHEAST QUARTER OF SECTION 24, TOWNSHIP 6 SOUTH, RANGE 66 WEST OF THE SIXTH PRINCIPAL MERIDIAN, TOWN OF PARKER, COUNTY OF DOUGLAS, STATE OF COLORADO, ADDITIONALLY DESCRIBED AS FOLLOWS:

BEGINNING AT THE NORTH QUARTER CORNER OF SAID SECTION 24;

THENCE ALONG THE NORTHERLY LINE OF SAID NORTHEAST QUARTER SOUTH 89°14'29" EAST, A DISTANCE OF 2,585.51 FEET TO AN EXISTING FENCE LINE ON THE WESTERLY SIDE OF POPE ROAD;

THENCE SOUTHWESTERLY ALONG SAID EXISTING FENCE LINE THE FOLLOWING (12) COURSES:

1. SOUTH 09°27'07" WEST, A DISTANCE OF 21.10 FEET;
2. SOUTH 03°29'43" WEST, A DISTANCE OF 99.37 FEET;
3. SOUTH 05°34'46" WEST, A DISTANCE OF 105.18 FEET;
4. SOUTH 08°44'32" WEST, A DISTANCE OF 62.52 FEET;
5. SOUTH 12°39'26" WEST, A DISTANCE OF 15.09 FEET;
6. SOUTH 17°05'43" WEST, A DISTANCE OF 117.46 FEET;
7. SOUTH 20°20'39" WEST, A DISTANCE OF 71.14 FEET TO THE BEGINNING OF A TANGENT CURVE CONCAVE NORTHWESTERLY HAVING A RADIUS OF 250.00 FEET;
8. SOUTHWESTERLY ALONG SAID CURVE THROUGH A CENTRAL ANGLE OF 16°24'08", AN ARC LENGTH OF 71.57 FEET;
9. TANGENT TO SAID CURVE SOUTH 36°44'47" WEST, A DISTANCE OF 595.55 FEET;
10. SOUTH 43°42'09" WEST, A DISTANCE OF 198.89 FEET;
11. NORTH 48°34'31" WEST, A DISTANCE OF 19.32 FEET;
12. SOUTH 39°02'05" WEST, A DISTANCE OF 208.01 FEET TO THE NORTHERLY LINE OF EAST MAINSTREET RECORDED IN BOOK 1422 AT PAGE 526 IN SAID RECORDS.

THENCE ALONG SAID NORTHERLY LINE SOUTH 83°01'13" WEST, A DISTANCE OF 12.64 FEET TO THE NORTHERLY LINE OF EAST MAINSTREET RECORDED AT RECEPTION NO. 2003021410 IN SAID RECORDS;

THENCE ALONG SAID NORTHERLY LINE SOUTH 89°02'54" WEST, A DISTANCE OF 1802.41 FEET TO THE WESTERLY LINE OF THE SOUTH HALF OF THE NORTHEAST QUARTER OF SECTION 24;

THENCE ALONG SAID WESTERLY LINE NORTH 00°13'24" WEST, A DISTANCE OF 25.67 FEET TO THE NORTH SIXTEENTH CORNER OF SECTION 24;

THENCE ALONG THE WESTERLY LINE OF THE NORTH HALF OF SAID NORTHEAST QUARTER NORTH 00°13'38" WEST, A DISTANCE OF 1352.65 FEET TO THE POINT OF BEGINNING.

CONTAINING AN AREA OF 71.459 ACRES, (3,112,760 SQUARE FEET), MORE OR LESS.

### NOTES

1. BASIS OF BEARINGS: THE BEARINGS SHOWN HEREON ARE BASED UPON THE WEST LINE OF THE N1/2 OF THE NE 1/4 OF SECTION 24, TOWNSHIP 6 SOUTH, RANGE 66 WEST OF THE 6TH PRINCIPAL MERIDIAN, BEING MONUMENTED AS SHOWN HEREON, AND BEARING NORTH 00°13'38" WEST, GRID BEARINGS, COLORADO COORDINATE SYSTEM, CENTRAL ZONE, NAD 83.
2. DISTANCES ON THIS PLAT ARE GROUND DISTANCES EXPRESSED IN U.S. SURVEY FEET AND DECIMALS THEREOF. A U.S. SURVEY FOOT IS DEFINED AS EXACTLY 1200/3937 METERS.
3. THIS ANNEXATION MAP HAS BEEN PREPARED FROM RECORD INFORMATION AND DOES NOT REPRESENT A MONUMENTED LAND SURVEY.

### OWNER

TOWN OF PARKER  
 20120 EAST MAINSTREET  
 PARKER, CO 80134

Town's zip code is  
 80138

### CONTIGUITY

TOTAL PERIMETER = 7364.08'  
 CONTIGUOUS PERIMETER = 3193.37'  
 1/6 PERIMETER = 1227.35'  
 TOTAL AREA = 71.459 ACRES±

Please add  
 contiguous perimeter  
 percentage (i.e. 43%)

### SURVEYOR'S CERTIFICATE

I, DEAN E. CATES, A LICENSED PROFESSIONAL LAND SURVEYOR IN THE STATE OF COLORADO, DO HEREBY CERTIFY THAT THIS ANNEXATION MAP WAS PREPARED UNDER MY DIRECT SUPERVISION; THAT, TO THE BEST OF MY KNOWLEDGE, INFORMATION, AND BELIEF, THIS MAP ACCURATELY DELINEATES THE PARCEL OF LAND TO BE ANNEXED TO THE TOWN OF PARKER, COLORADO; AND THAT AT LEAST ONE SIXTH (1/6) OF THE BOUNDARY OF SAID PARCEL IS CONTIGUOUS TO THE PRESENT TOWN OF PARKER, COUNTY OF DOUGLAS, STATE OF COLORADO.



DEAN E. CATES  
 COLORADO LICENSED PROFESSIONAL LAND SURVEYOR No. 22561  
 FOR AND ON BEHALF OF AZTEC CONSULTANTS, INC.

NOTICE:  
 ACCORDING TO COLORADO LAW YOU MUST COMMENCE ANY LEGAL ACTION BASED UPON ANY DEFECT IN THIS SURVEY WITHIN THREE YEARS AFTER YOU FIRST DISCOVER SUCH DEFECT. IN NO EVENT, MAY ANY ACTION BASED UPON ANY DEFECT IN THIS SURVEY BE COMMENCED MORE THAN TEN YEARS FROM THE DATE OF THE CERTIFICATION SHOWN HEREON.

Please move to Notes  
 section

### ACCEPTANCE

ACCEPTED BY THE PARKER TOWN COUNCIL THIS \_\_\_\_\_ DAY OF \_\_\_\_\_, 20\_\_\_\_.

\_\_\_\_\_  
 MAYOR, TOWN OF PARKER

\_\_\_\_\_  
 ATTEST: TOWN CLERK

### CLERK AND RECORDER'S CERTIFICATE

STATE OF COLORADO )  
 ) SS  
 COUNTY OF DOUGLAS )

I HEREBY CERTIFY THAT THIS PLAT WAS FILED IN MY OFFICE ON THIS \_\_\_\_\_ DAY OF \_\_\_\_\_ 20\_\_\_\_ A.D., AT \_\_\_\_\_ A.M./P.M. AND WAS RECORDED AT

RECEPTION NO. \_\_\_\_\_

\_\_\_\_\_  
 COUNTY CLERK AND RECORDER

SCALE	1"=50'
DATE	04/03/2017
BY	
DATE	
REVISION DESCRIPTION	

300 East Mineral Ave., Suite 1  
 Littleton, Colorado, 80122  
 Phone: (303) 713-1898  
 Fax: (303) 713-1897  
 www.aztecconsultants.com

# AZTEC


CONSULTANTS, INC.

HARVIE ANNEXATION MAP  
 TOWN OF PARKER  
 DOUGLAS COUNTY, COLORADO  
 PREPARED FOR  
 THE TOWN OF PARKER  
 20120 EAST MAINSTREET, PARKER, CO 80138

# RAY J. HARVIE ANNEXATION MAP

TO THE TOWN OF PARKER

LOCATED IN THE NORTHEAST QUARTER OF SECTION 24, TOWNSHIP 6 SOUTH, RANGE 66 WEST OF THE SIXTH PRINCIPAL MERIDIAN,  
COUNTY OF DOUGLAS, STATE OF COLORADO

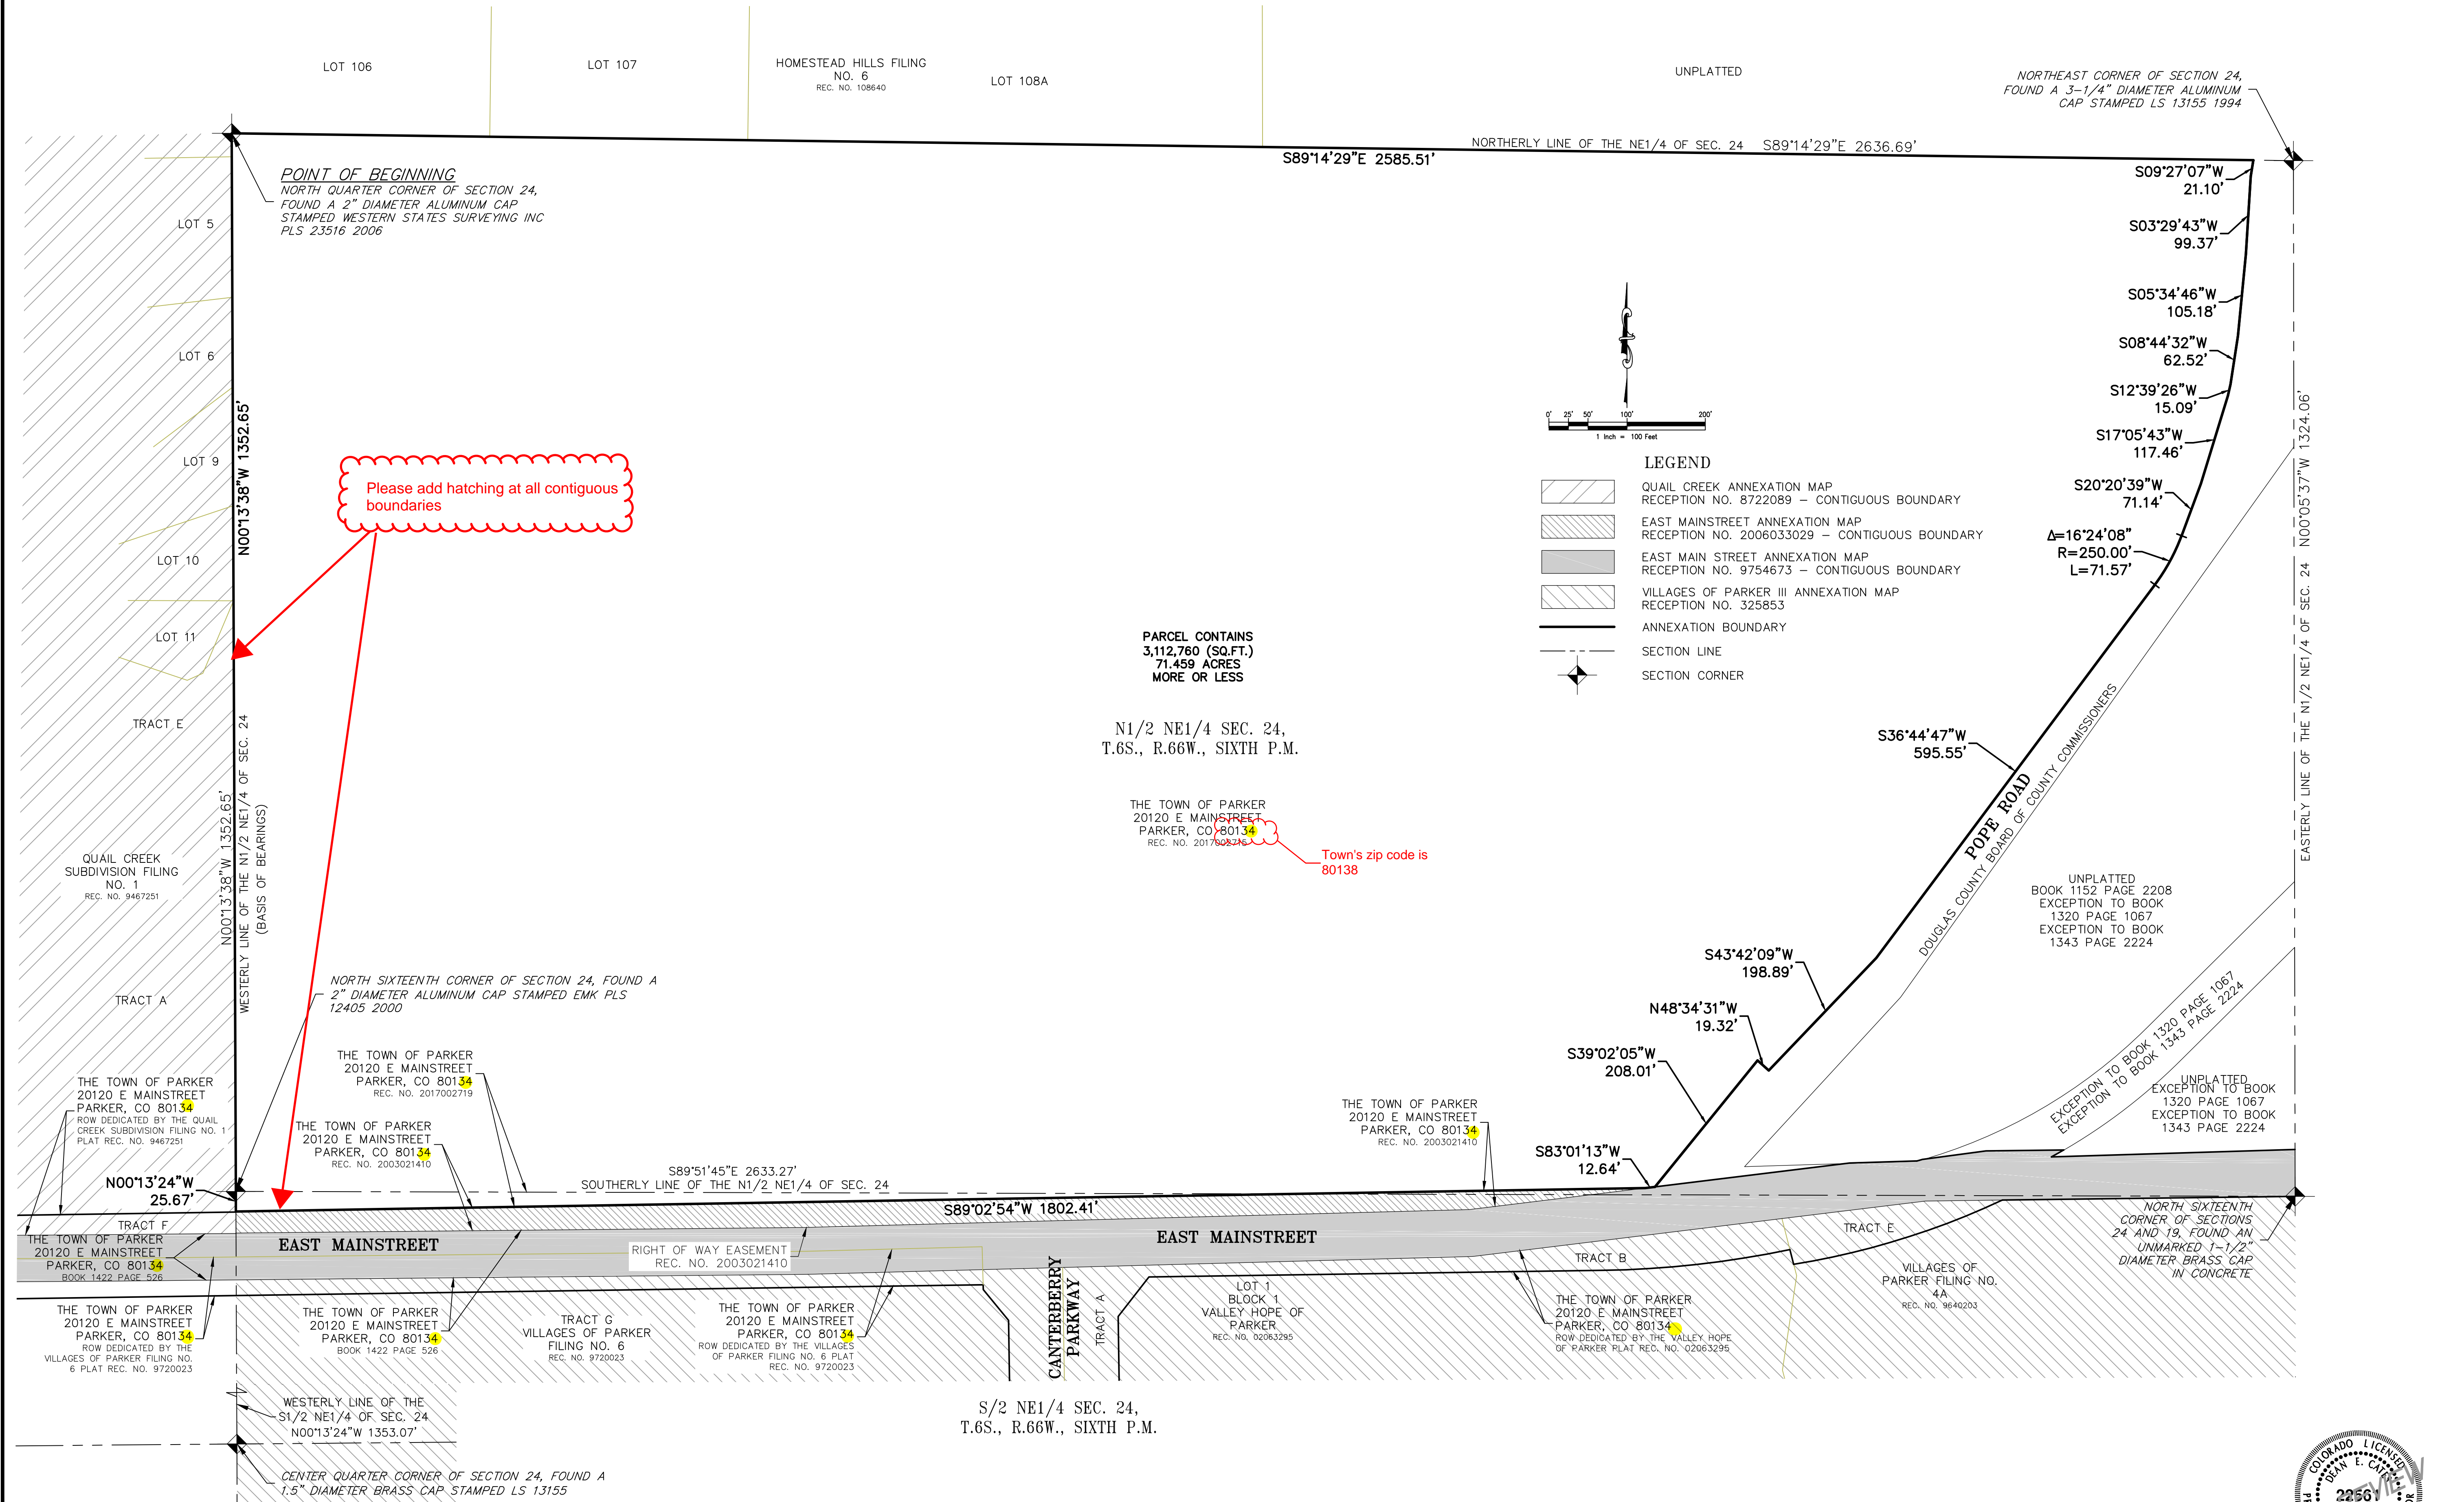

SCALE	1"=100'
DATE	04/08/2017
BY	
DATE	
REVISION DESCRIPTION	

**AZTEC**  
CONSULTANTS, INC.

300 East Mineral Ave., Suite 1  
Littleton, Colorado 80122  
Phone: (303) 713-1898  
Fax: (303) 713-1897  
www.aztecconsultants.com

**HARVIE ANNEXATION MAP**  
**TOWN OF PARKER**  
**DOUGLAS COUNTY, COLORADO**

PREPARED FOR  
THE TOWN OF PARKER  
20120 EAST MAINSTREET, PARKER, CO 80138

SHEET  
**2**  
OF 2 SHEETS

24917-03  
JOB NO.



FOR AND ON BEHALF OF  
AZTEC CONSULTANTS, INC.