
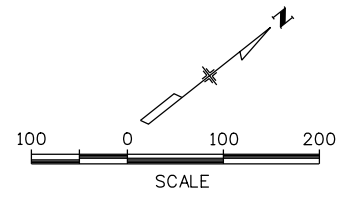


FILE NAME: I:\PROJECTS\6844873-E470-E-470\_CAD\_Support\E-470\_CAD\_Support\E-470\_V8\_Traffic\_ITS\Drawings\E-470\_Traffic\_Plans\E-470\_Plan\_TR-111.DGN  
 PLOT DATE: 9/4/2014

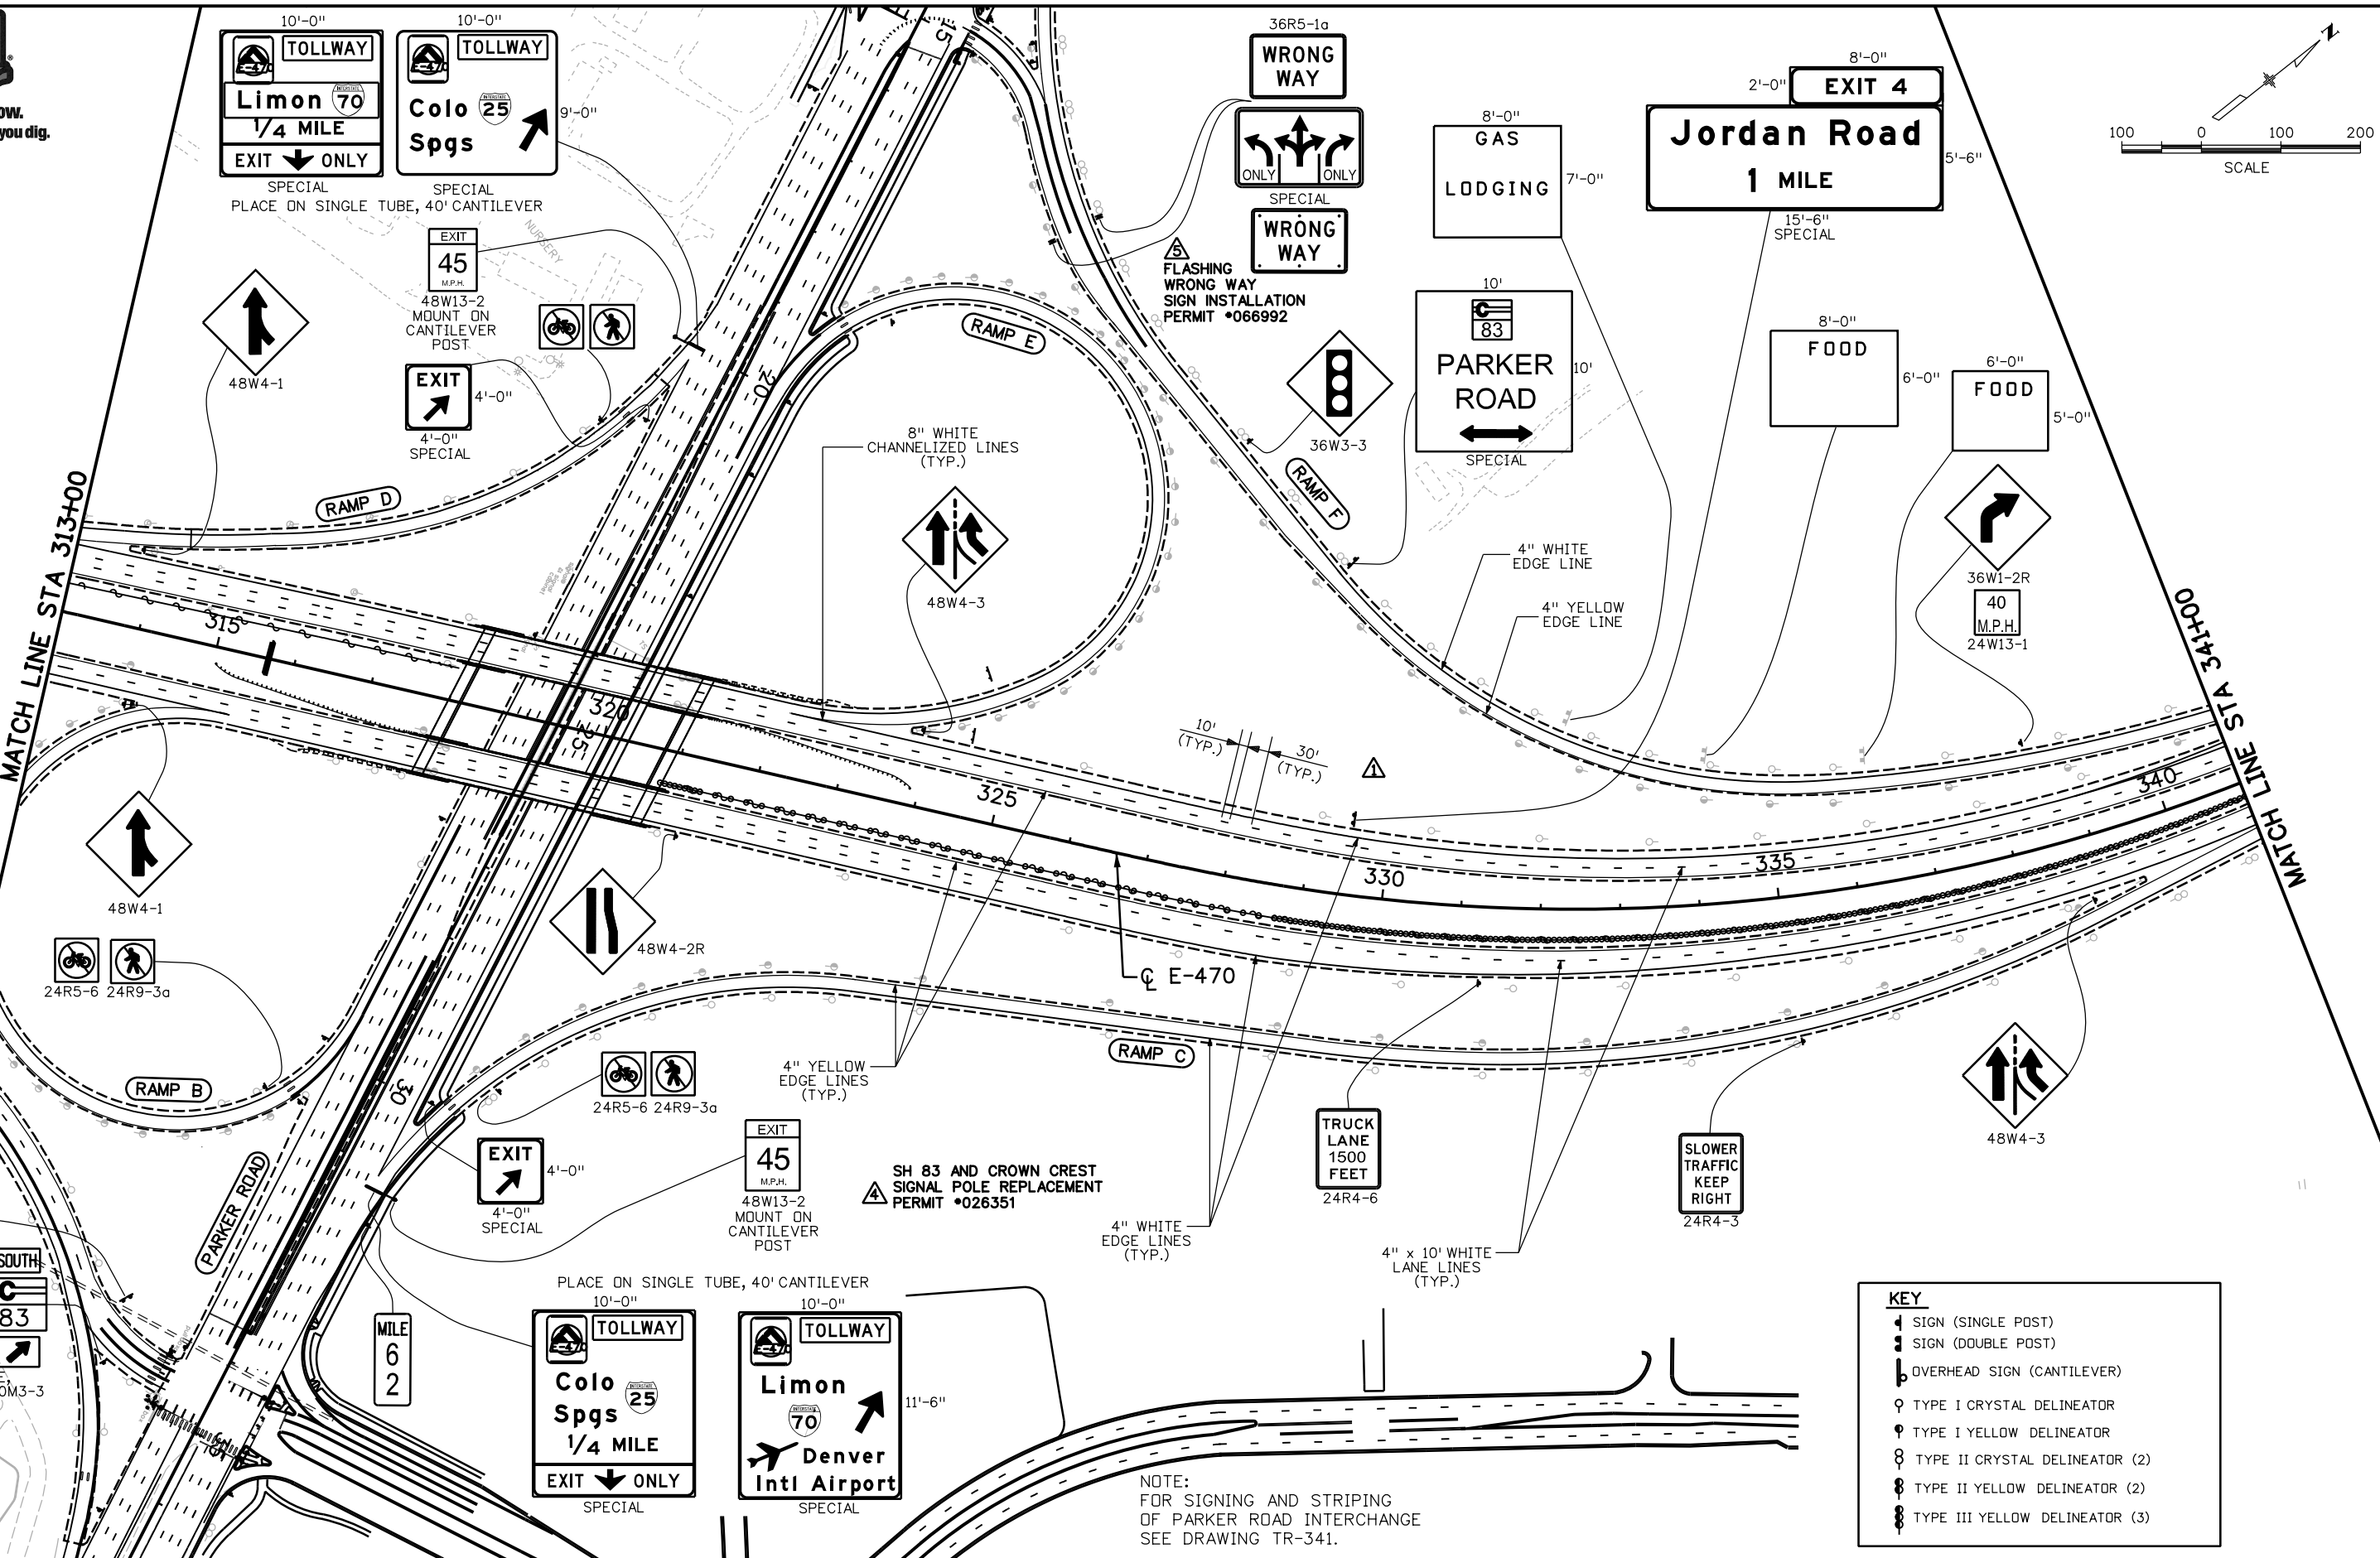

**KEY**

- ↑ SIGN (SINGLE POST)
- ↑↑ SIGN (DOUBLE POST)
- OVERHEAD SIGN (CANTILEVER)
- ⊙ TYPE I CRYSTAL DELINEATOR
- ⊙ TYPE I YELLOW DELINEATOR
- ⊙ TYPE II CRYSTAL DELINEATOR (2)
- ⊙ TYPE II YELLOW DELINEATOR (2)
- ⊙ TYPE III YELLOW DELINEATOR (3)

NOTE:  
 FOR SIGNING AND STRIPING  
 OF PARKER ROAD INTERCHANGE  
 SEE DRAWING TR-341.

**ISSUE RECORD**

NO.	BY	PURPOSE	DATE	NO.	BY	PURPOSE	DATE	NO.	BY	PURPOSE	DATE
-	SBS	REL FOR CONST.	9/25/96	S	E470	PERMIT #066992	7/4/13	-	-	-	-
1	DRW	MOVE SIGN	2/09/97	-	-	-	-	-	-	-	-
2	M6T	AS-BUILT	7/31/98	-	-	-	-	-	-	-	-
3	E470	V8 AS-BUILT CONVERSION	2/31/06	-	-	-	-	-	-	-	-
4	E470	PERMIT #026351	11/17/06	-	-	-	-	-	-	-	-



E-470 STA. 313+00 TO 341+00  
 SIGNING AND STRIPING PLAN

ISSUED DATE:	ORIGINAL E-470 CONTRACT NO.	SHEET NUMBER
STRUCTURE NUMBER:	A2-04-A	TR-111