



Development Review Division

Community Development Department: Town Hall / 20120 East Mainstreet Parker, CO 80138 Phone: 303.841.2332 Fax: 303.841.3223

MEMORANDUM

TO: Brynhildr Halsten, Galloway & Company
FROM: Ashley Chasez, Planner I
DATE: October 25, 2023
SUBJECT: Douglas 234 F6 AMD 1 L4 - Dunkin Donuts
Review Comments 02

Listed below are the Planning Division's comments related to your land use application, which must be responded to. If you wish to discuss a comment, please contact your Case Planner. Upon resubmittal, please sign and return this memo. A follow-up meeting with the reviewing agencies can be scheduled to provide additional guidance by contacting the Case Planner.

TOWN OF PARKER PLANNING DEPARTMENT CASE PLANNER: Ashley Chasez

EMAIL: achasez@parkeronline.org

PHONE: 303.805.3331

GENERAL PROJECT COMMENTS:

1. The Planning Division references certain sections of the Parker 2035 Master Plan, the Land Development Ordinance (LDO) and the Development Design Standards. Copies of these documents are available at:
[Parker 2035 Master Plan](#)
[Development Design Standards](#)
[Land Development Ordinance](#)
2. The Planning Division has made every effort to make this comment letter as comprehensive as possible. However, additional comments that have not been provided as part of this comment letter may be identified as part of future submittals, based on revisions to the project.
3. Please contact the referral agencies if you have questions regarding their review comment(s).
4. A redlined plan is included with this memorandum and is intended to supplement and clarify the review comments of this memorandum.
5. Final Plans submitted to the Building Department, Engineering Department and Parker Water and Sanitation District **must be exactly the same as the approved Site Plan set.**
6. The Town of Parker has implemented a naming convention for all applications. For all future documents that are uploaded to TRAKiT please ensure the submittal round is first, the name of the document is second and the name of the project is third. Staff will not refer the application out with this naming convention.
Example: "02" or "Second Submittal"

7. **Prairie Dog Management:** The Town's current land development ordinance section 13.10.250 - Prairie Dog Management requires applicants/developers to make a good faith effort to have any prairie dogs on site relocated. Documentation of this effort will be a condition of the land use application approval/site development and a certificate of compliance will be required prior to issuance of the grading permit. If relocation of the prairie dogs is not available, humane extermination may be considered. Prairie Dog management should begin as early as possible during the review process. Please coordinate with staff.
8. **Utility transformers:** Pursuant to section 13.10.090- Utilities of the Town of Parker Land Development Ordinance all on-site utilities serving a single use shall be placed underground. On-site utilities for the provision of service to nonresidential use(s) such as pedestals, transformers or other equipment may be placed above ground in a rear-yard or side-yard utility easement only. Transformers and other utility equipment associated with the application shall be shown on the approved Site Plan. Please work with staff to determine the correct placement for this equipment.

Site Plan and Project Details

1. Please see the attached redlines for additional information.

Comment Addressed: ☐ Yes ☐ No

Response:

OUTSIDE REFERRAL AGENCY COMMENTS

Please address all outside referral agency comments with a written response. The following agencies have provided comments for review:

- Town of Parker – Construction Plan (Environmental)
- Town of Parker – Construction Plan (Civil)
- Town of Parker – Drainage Report
- Town of Parker – Fire, Life & Safety
- Town of Parker – Traffic Impact Study
- Parker Water and Sanitation District
- CORE Electric
- Cherry Creek Basin Water Quality Authority

Attached to the Planning comments is a printout of all review comments on the project. These comments include all comments from the first submittal to the most recent. They are organized from oldest to most recent. Therefore, the comments from this referral can be found at the end of the document.

Comment(s) Addressed: ☐ Yes ☐ No

Response:

Staff Comments 02
SP22-041
Douglas 234 F6 AMD 1 L4 - Dunkin Donuts
10/25/2023

Property Owner

Date

Project Representative

Date

CONTACT LIST

DEVELOPER

FIRST CUP DUNKIN' DONUTS, LLC
106 S. KYRENE RD, SUITE 2
CHANDLER, AZ 85226
PHONE: 480.313.2724
CONTACT: BRIAN ZUREK

ARCHITECT

ETHOS ARCHITECTURE GROUP
8025 W. 25TH PLACE
LAKEWOOD, CO 80214
PHONE: 303.374.9896
CONTACT: JOHN SPONSELLER

ENGINEER

RICK ENGINEERING COMPANY
8678 CONCORD CENTER DR, UNIT 200
ENGLEWOOD, CO 80112
PHONE: 303.537.8020
CONTACT: TROY BALES

SURVEYOR

RICK ENGINEERING COMPANY
5690 WEBSTER ST.
ARVADA, CO 80002
PHONE: 303.403.2433
CONTACT: ROBERT HENNESSY

PARKER PUBLIC WORKS

20120 E. MAINSTREET
PARKER, CO. 80138
PHONE: 303.840.9546
STREETS — MIKE WAUGH
STORM WATER — JACOB JAMES

TOWN OF PARKER POLICE DEPARTMENT

19600 E. PARKER SQUARE DR.
PARKER, CO. 80134
PHONE: 303.841.9800

PARKER WATER AND SANITATION DISTRICT

18100 E. WOODMAN DR.
PARKER, CO. 80134
PHONE: 303.841.4627

FIRE & LIFE SAFETY

20120 E. MAINSTREET
PARKER, CO 80138
PHONE: 303.205.3169
CONTACT: RANDALL CAPRA

UTILITY NOTIFICATION COMPANY OF COLORADO

2801 SOUTH YOUNGFIELD ST, SUITE 301
GOLDEN, CO 80401
PHONE: 800.922.1987
LOCAL CALLS: (811)

XCEL ENERGY

5909 E. 38TH AVE.
DENVER, CO 80207
PHONE: 303.329.1618
CONTACT: MICHELLE O'NAN

COMCAST

6850 S. TUCSON WAY
ENGLEWOOD, CO 80112
PHONE: 720.490.3867
CONTACT: KEVIN YOUNG

LUMEN

9750 E. COSTILLA AVE.
ENGLEWOOD, CO 80220
PHONE: 303.792.6069
CONTACT: WILLIAM BENSON

COLORADO DEPARTMENT OF HEALTH

4210 E. 11TH AVE.
DENVER, CO
PHONE: 303.320.8333

INTERMOUNTAIN RURAL ELECTRIC ASSOCIATION

5496 NORTH US HWY 85
P.O BOX DRAWER A
SEDALIA, CO 80135
PHONE: 303.688.3100
CONTACT: JASON JENKS

MILE HIGH FLOOD CONTROL DISTRICT (MHFCD)

2480 W. 26TH AVE.
SUITE 156-B
DENVER, CO 80211
PHONE: 303.455.6277
CONTACT: MIKE SARMENTO

SITE BENCHMARK & BASIS OF BEARINGS

THE PRIMARY BENCHMARK USED TO DETERMINE THE BASIS OF ELEVATIONS FOR THIS MAP IS BY GPS OBSERVATION NAVD88. A SITE BENCHMARK HAS BEEN SET AT THE NORTHWEST CORNER OF A DRAIN INLET ON CHAMBERS ROAD, APPROXIMATELY 200'± NORTH OF HESS ROAD. ELEVATION = 6075.31

THE BASIS OF BEARINGS IS THE SOUTH LINE OF THE SOUTHEAST QUARTER OF SECTION 29 TOWNSHIP 6 SOUTH, RANGE 66 WEST, 6TH PRINCIPAL MERIDIAN, BEARING SOUTH 89°15'13" WEST AS SHOWN ON FINAL PLAT DOUGLAS 234 FILING NO. 1.

SHEET INDEX	
NO.	TITLE
1	COVER SHEET
2	EXISTING CONDITIONS & DEMOLITION PLAN
3	SITE PLAN
4	PRELIMINARY UTILITY PLAN
5	FIRE TRUCK ACCESS PLAN
6	LANDSCAPE PLAN & DETAILS
7	LANDSCAPE PLAN & DETAILS
8	LANDSCAPE IRRIGATION & DETAILS
9	LANDSCAPE IRRIGATION & DETAILS
10	LANDSCAPE IRRIGATION & DETAILS
11	LANDSCAPE IRRIGATION & DETAILS
12	PHOTOMETRIC PLAN
13	PHOTOMETRIC DETAILS
14	BUILDING ELEVATIONS
15	BUILDING ELEVATIONS

FLOOD PLAIN NOTE


BY SCALED MAP LOCATION AND GRPAHIC PLOTTING ONLY, THIS PROPERTY LIES IN ZONE X OF THE FLOOD INSURANCE RATE MAP, COMMUNITY PANEL NUMBER 08035C0181G AND DATED MARCH 16, 2016 — SUBJECT PROPERTY IS NOT IN A SPECIAL FLOOD HAZARD AREA.

LEGAL DESCRIPTION

LOT 4, DOUGLAS 234, FILING NO. 6, AMENDMENT 1

SITE PLAN FOR
DUNKIN' DONUTS
DOUGLAS 234, FILING NO. 6,
AMENDMENT 1, LOT 4

A PORTION OF THE SOUTHWEST QUARTER OF THE SOUTHEAST QUARTER OF SECTION 29,
TOWNSHIP 6 SOUTH, RANGE 66 WEST, 6TH PRINCIPAL MERIDIAN,
TOWN OF PARKER, COUNTY OF DOUGLAS, STATE OF COLORADO
0.901 ACRES, 1 COMMERCIAL LOT

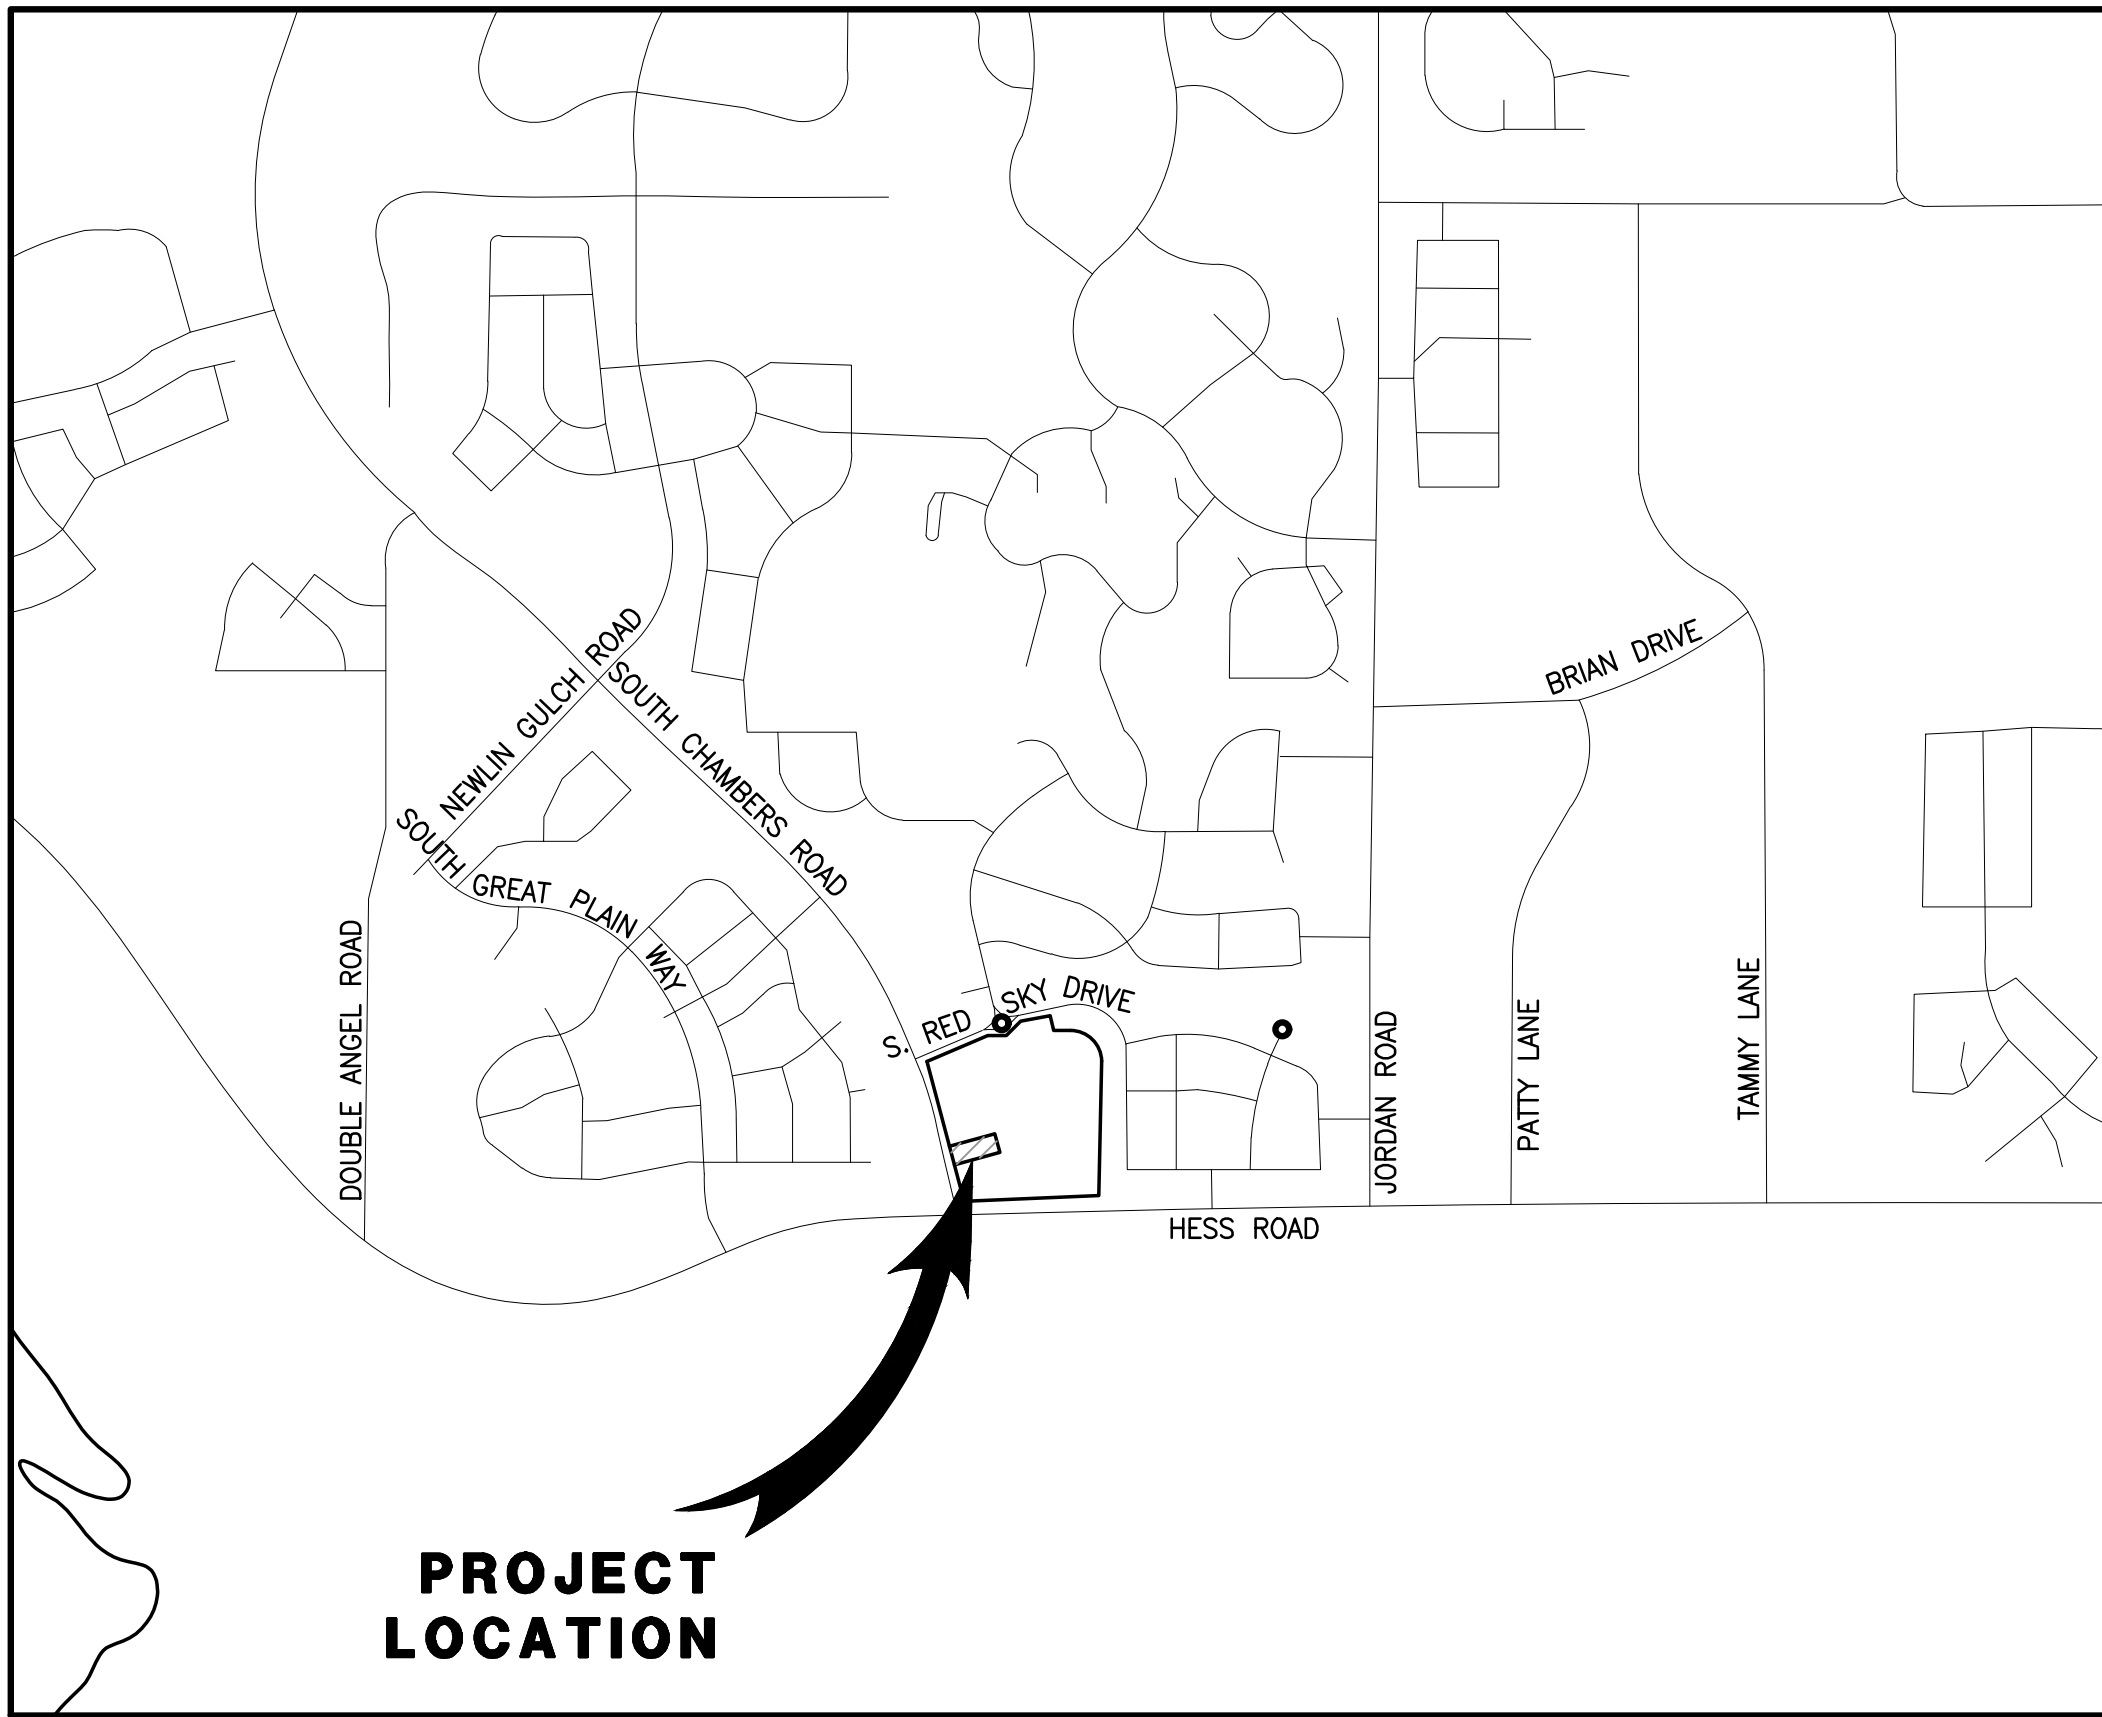

VICINITY MAP

SCALE 1"= 1000'

1000 500 0 1000
GRAPHIC SCALE: 1"=1000'

SETBACKS		
COMMERCIAL DEVELOPMENT STANDARDS	REQUIRED SETBACKS	PROVIDED SETBACK
FRONT	10'	143.91'
SIDE	8'	47.59'/62.32'
REAR	0'	64.40'

DEVELOPMENT STANDARDS		
COMMERCIAL DEVELOPMENT STANDARDS	TOWN OF PARKER LAND DEVELOPMENT CODE REQ.	PROVIDED
MINIMUM LANDSCAPE AREA	0.14 AC (15%)	0.305 ACRES (34%)
MAXIMUM BUILDING HEIGHT	35 FEET	1 STORY/ 22'-10"
MINIMUM OFF-STREET PARKING	18 (PER NLA)	18 ON-SITE SPACES (2 ADA SPACES)
MAXIMUM FLOOR AREA RATIO (FAR)	0.35	0.05

LEGEND

	EXISTING	PROPOSED
PROPERTY BOUNDARY	---	---
PROPERTY LINE	---	---
RIGHT-OF-WAY	---	---
CENTERLINE	---	---
CURB	---	---
CURB & GUTTER	---	---
EASEMENT	---	---
CONTOURS	---	---
WATER LINE	W	W
SANITARY SEWER LINE	S	S
STORM DRAIN LINE	---	---
GAS LINE	G	---
ELECTRIC LINE	E	---
TYPICAL LATERALS	---	XX
SANITARY SEWER MANHOLE	S	S
STORM DRAIN MANHOLE	D	D
STORM DRAIN INLET	---	---
FIRE HYDRANT	---	---
AC PAVING	---	---
CONCRETE	---	---
LANDSCAPE	---	---

ABBREVIATIONS

BLDG	BUILDING
CL	CENTERLINE
DIA.	DIAMETER
DIST.	DISTRICT
E	EASTING
EG	EXISTING GRADE
ESMT	EASEMENT
EX.	EXISTING
FG	FINISHED GRADE
FL	FLOW LINE
FS	FINISHED SURFACE
INV	INVERT
MIN.	MINIMUM
N	NORTHING
NLA	NET LEASABLE AREA
NO.	NUMBER
PL	PROPERTY LINE
PROP.	PROPOSED
PVC	POLYVINYL CHLORIDE PIPE
RCP	REINFORCED CONCRETE PIPE
R.O.W.	RIGHT OF WAY
REC.	RECEPTION
REQ.	REQUIRED
SAN	SANITARY SEWER
SF	SQUARE FOOT
STD	STANDARD

SITE DATA

PROPERTY ACREAGE	0.901 ACRES (39,244 SF)
PERVIOUS AREA	0.305 ACRES
IMPERVIOUS AREA	0.596 ACRES
MAXIMUM IMPERVIOUS AREA	0.766 ACRES, 85% OF TOTAL LAND AREA
BUILDING DENSITY	1,959 SF (BLDG) = 4.99% 39,244 SF (LOT)
MAX BUILDING DENSITY	NONE
PARKING AREA	3,083 SF
PARKING REQUIRED	18 SPACES/12 SPACES (1 PER 100 NLA/1 PER EACH 3 PERSONS OF RATED CAPACITY)
PARKING PROVIDED	18 ON-SITE SPACES (2 ADA SPACES)
BICYCLE PARKING REQUIRED	4
BICYCLE PARKING PROVIDED	4

LAND USE DATA

EXISTING ZONING	PLANNED DEVELOPMENT
GROSS SITE AREA	0.901 ACRES
NUMBER OF BUILDINGS	1 BUILDING
BUILDING GROSS FLOOR AREA	1,959 SF
NET LEASABLE AREA	1,811 SF
BUILDING OCCUPANCY	35 PEOPLE

SEAL:

8678 CONCORD CENTER DR, UNIT 200
ENGLEWOOD, CO 80112
rickengineering.com
303.537.8020

RICK
ENGINEERING COMPANY

San Diego - Riverside - Sacramento - Orange - Tucson - Phoenix - Las Vegas - Denver

PROJECT NO:
8/28/2023

2243
DRAWN/DESIGNED BY:
KA/JS

DATE:
8/28/2023

CHECKED BY:

SITE PLAN PREPARED FOR:
DOUGLAS 234, FILING NO. 6,
AMENDMENT 1, LOT 4
DOUGLAS COUNTY, COLORADO

COVER SHEET

811
Know what's below.
Call before you dig.


DRAWING NO.
1

2ND SUBMITTAL

C:\RICK\Projects\002000\2243_DunkinDonuts\Civil\PlanSets\Site Plan\2243-C-DEM001.dwg - plotted by: kalazard ON 2023-08-24 @ 08:32 - ctbrec_rcs.ctb - © 2022 Rick Engineering Company

SITE PLAN FOR
DUNKIN' DONUTS
DOUGLAS 234, FILING NO. 6,
AMENDMENT 1, LOT 4

A PORTION OF THE SOUTHWEST QUARTER OF THE SOUTHEAST QUARTER OF SECTION 29,
TOWNSHIP 6 SOUTH, RANGE 66 WEST, 6TH PRINCIPAL MERIDIAN,
TOWN OF PARKER, COUNTY OF DOUGLAS, STATE OF COLORADO
0.901 ACRES, 1 COMMERCIAL LOT

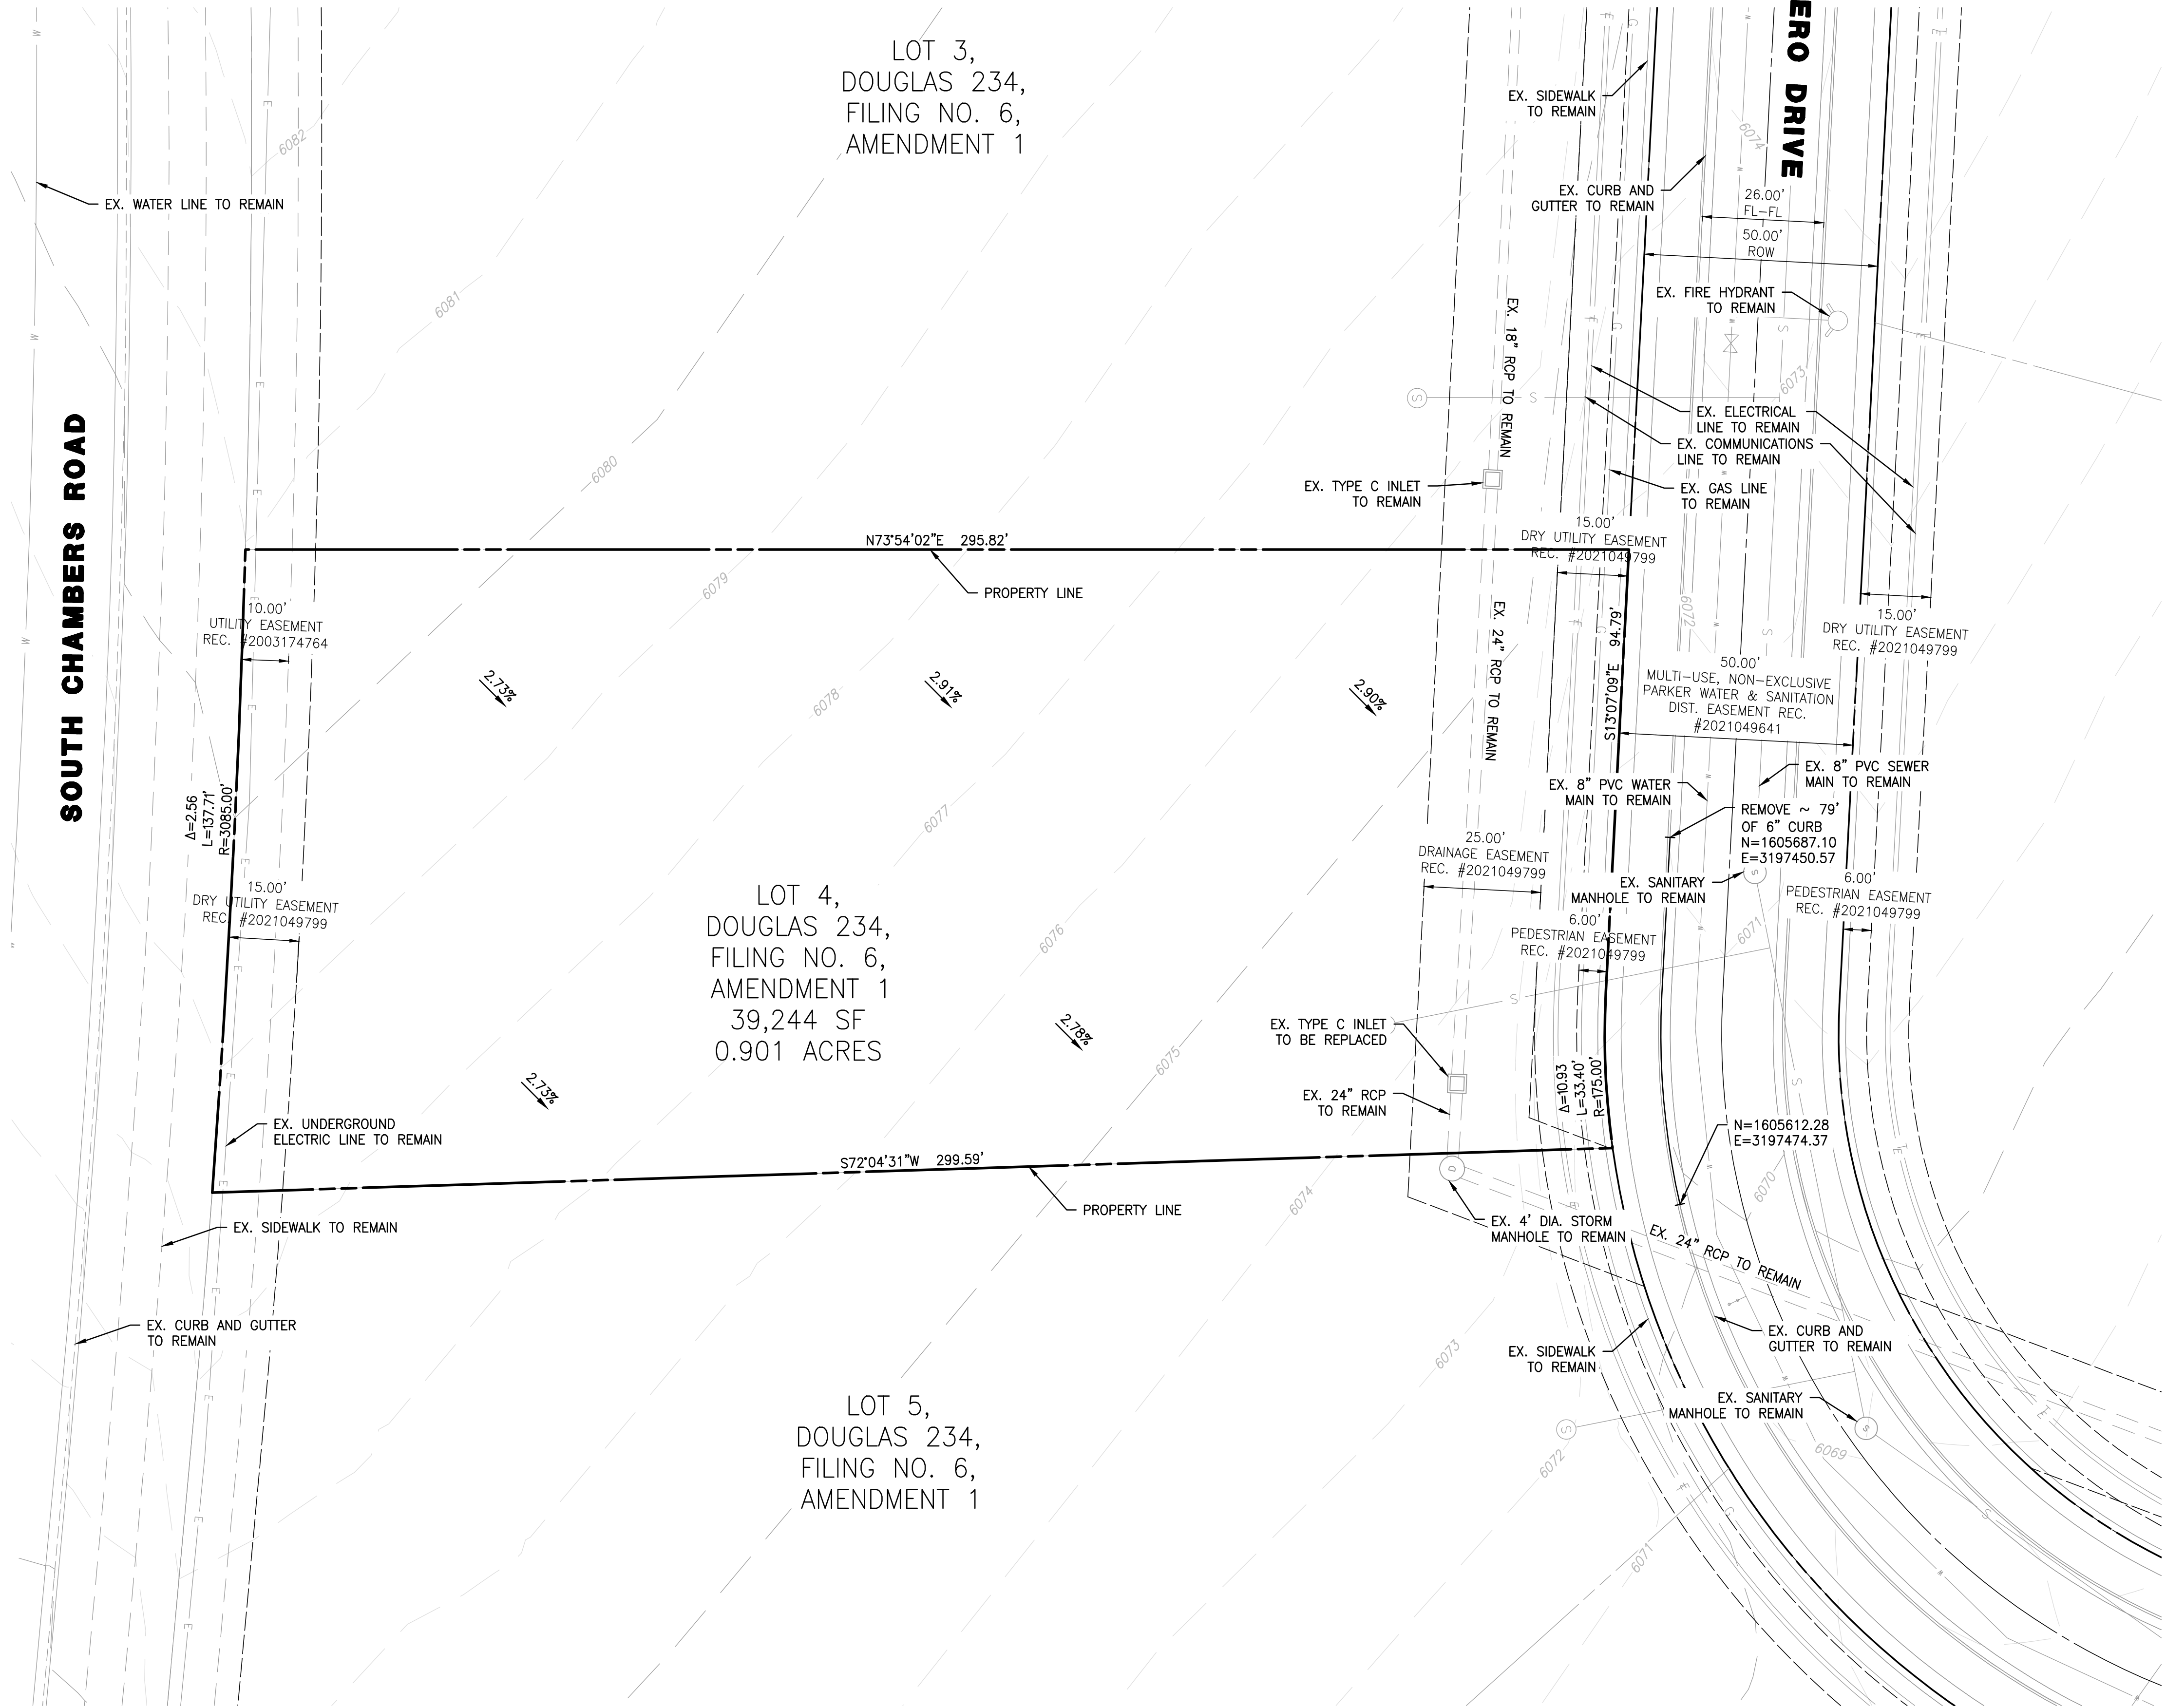

NOTES

1. ALL EXISTING UTILITIES ARE TO REMAIN UNLESS OTHERWISE NOTED.
2. ALL EXISTING IMPROVEMENTS TO BE PROTECTED IN PLACE, UNLESS SPECIFICALLY CALLED AS "TO BE REMOVED".

SITE PLAN PREPARED FOR:

**DOUGLAS 234, FILING NO. 6,
AMENDMENT 1, LOT 4**

DOUGLAS COUNTY, COLORADO

EXISTING CONDITIONS & DEMOLITION PLAN




DRAWING NO.

2

SEAL:

8678 CONCORD CENTER DR, UNIT 200
ENGLEWOOD, CO 80112
303.537.8020

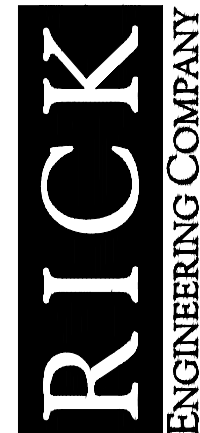

rickengineering.com

San Diego - Riverside - San Luis Obispo - Sacramento - Orange - Tucson - Phoenix - Las Vegas - Denver

PROJECT NO:

DATE:

2243 DRAWN/DESIGNED BY:

8/24/2023 CHECKED BY:

KA/JS

JS

NO.

BY

DATE

REVISION

2ND SUBMITTAL

A PORTION OF THE SOUTHWEST QUARTER OF THE SOUTHEAST QUARTER OF SECTION 29,
TOWNSHIP 6 SOUTH, RANGE 66 WEST, 6TH PRINCIPAL MERIDIAN,
TOWN OF PARKER, COUNTY OF DOUGLAS, STATE OF COLORADO
0.901 ACRES, 1 COMMERCIAL LOT

Will this line be painted onto the asphalt? All drive through lanes must maintain a width of 11ft.

Add crosswalk stripes

Correct the legend to — match what is shown on the plan

- 1 PROPOSED VERTICAL CURB AND GUTTER
- 2 PROPOSED CURB TYPE 2 (SECTION B) 6" BARRIER
- 3 PROPOSED MIDBLOCK CURB RAMP
- 4 PROPOSED TRASH ENCLOSURE PROPOSED
- 5 BIKE PARKING (4 SPACES)
- 6 PROPOSED SIDEWALK
- 7 PROPOSED MONUMENT SIGN (ALL SIGNS ARE REVIEWED UNDER SEPARATE PERMIT)
- 8 3' GUTTER TYPE 2
- 9 TIE INTO EXISTING
- 10 4" WIDE, WHITE PARKING SPACE MARKING
- 11 WHITE CROSSWALK MARKINGS
- 12 DIRECTIONAL ARROW
- 13 4" WIDE, WHITE, SOLID DIAGONAL MARKINGS AT 5' SPACING ANGLED AT 30 DEGREES
- 14 INTERNATIONAL SYMBOL OF ACCESSIBILITY PARKING SPACE MARKING
- 15 "DO NOT ENTER" PAVEMENT LEGEND
- 16 "NO PARKING" PAVEMENT LEGEND
- 17 R1-1 SIGN
- 18 "HANDICAP PARKING ONLY" SIGN AND "VAN ACCESSIBLE" SIGN
- 19 SINGLE VEHICLE CLEARANCE BAR
- 20 DIGITAL PREVIEW BOARD
- 21 DIGITAL MENU BOARD
- 22 ORDER CANOPY
- 23 DIRECTIONAL SIGN
- 24 PROPOSED 18" CONCRETE LANDING
- 25 PROPOSED 8' CROSS PAN
- 26 PROPOSED DIRECTIONAL CURB RAMP
- 27 PROPOSED LIGHTING

2243	DRAWN/DESIGNED BY:
9/25/2007	CHECKED BY:

3

SITE PLAN FOR
DUNKIN' DONUTS
DOUGLAS 234, FILING NO. 6,
AMENDMENT 1, LOT 4


A PORTION OF THE SOUTHWEST QUARTER OF THE SOUTHEAST QUARTER OF SECTION 29,
TOWNSHIP 6 SOUTH, RANGE 66 WEST, 6TH PRINCIPAL MERIDIAN,
TOWN OF PARKER, COUNTY OF DOUGLAS, STATE OF COLORADO
0.901 ACRES, 1 COMMERCIAL LOT

LOT 3,
DOUGLAS 234,
FILING NO. 6,
AMENDMENT 1

LOT 5,
DOUGLAS 234,
FILING NO. 6,
AMENDMENT 1

LEGEND

PROPERTY LINE	---
EASEMENT	- - - -
EX. WATER LINE	— W —
EX. SANITARY SEWER LINE	— S —
EX. STORM DRAIN LINE	— G —
EX. GAS LINE	— G —
EX. ELECTRIC LINE	— E —
EX. COMMUNICATIONS LINE	— T —
WATER LINE	— W —
SANITARY SEWER LINE	— S —
STORM DRAIN LINE	— G —
TYPICAL LATERALS	— X —

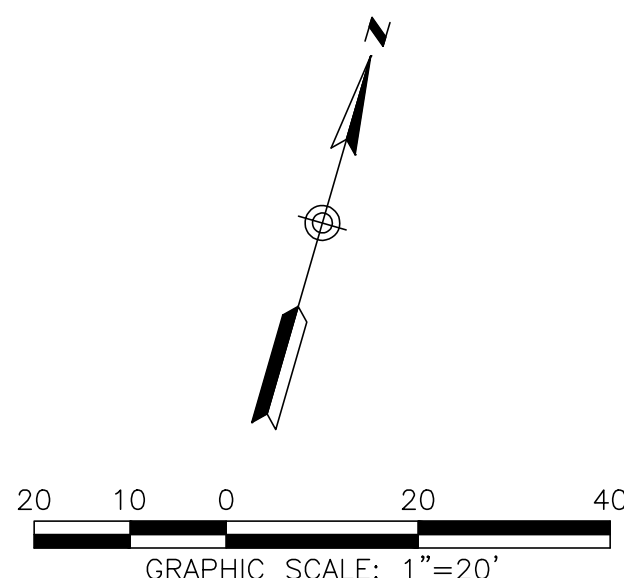

SITE PLAN PREPARED FOR:

**DOUGLAS 234, FILING NO. 6,
AMENDMENT 1, LOT 4**

DOUGLAS COUNTY, COLORADO

PRELIMINARY UTILITY PLAN

SEAL:

RICK
ENGINEERING COMPANY
8678 CONCORD CENTER DR, UNIT 200
ENGLEWOOD, CO 80112
rickengineering.com
303.537.8020
San Diego - Riverside - Sacramento - Orange - Tucson - Phoenix - Las Vegas - Denver

PROJECT NO: 2243
DATE: 8/24/2023
DRAWN/DESIGNED BY: KA/JS
CHECKED BY: JS

NO.	BY	DATE	REVISION





DRAWING NO.
4


2ND SUBMITTAL

C:\RICK\Projects\02000\2243_DunkinDonuts\Civil\PlanSets\Site Plan\2243-C-AUTOTURN01.dwg - plotted by: kalazard ON 2023-08-24 @ 16:47 - ctb:rec_ncs.ctb - ©2022 Rick Engineering Company

SOUTH CHAMBERS ROAD

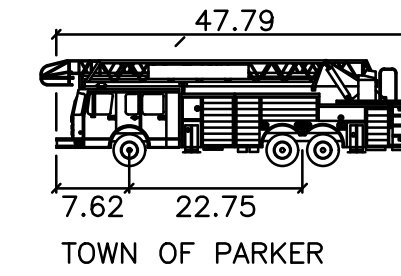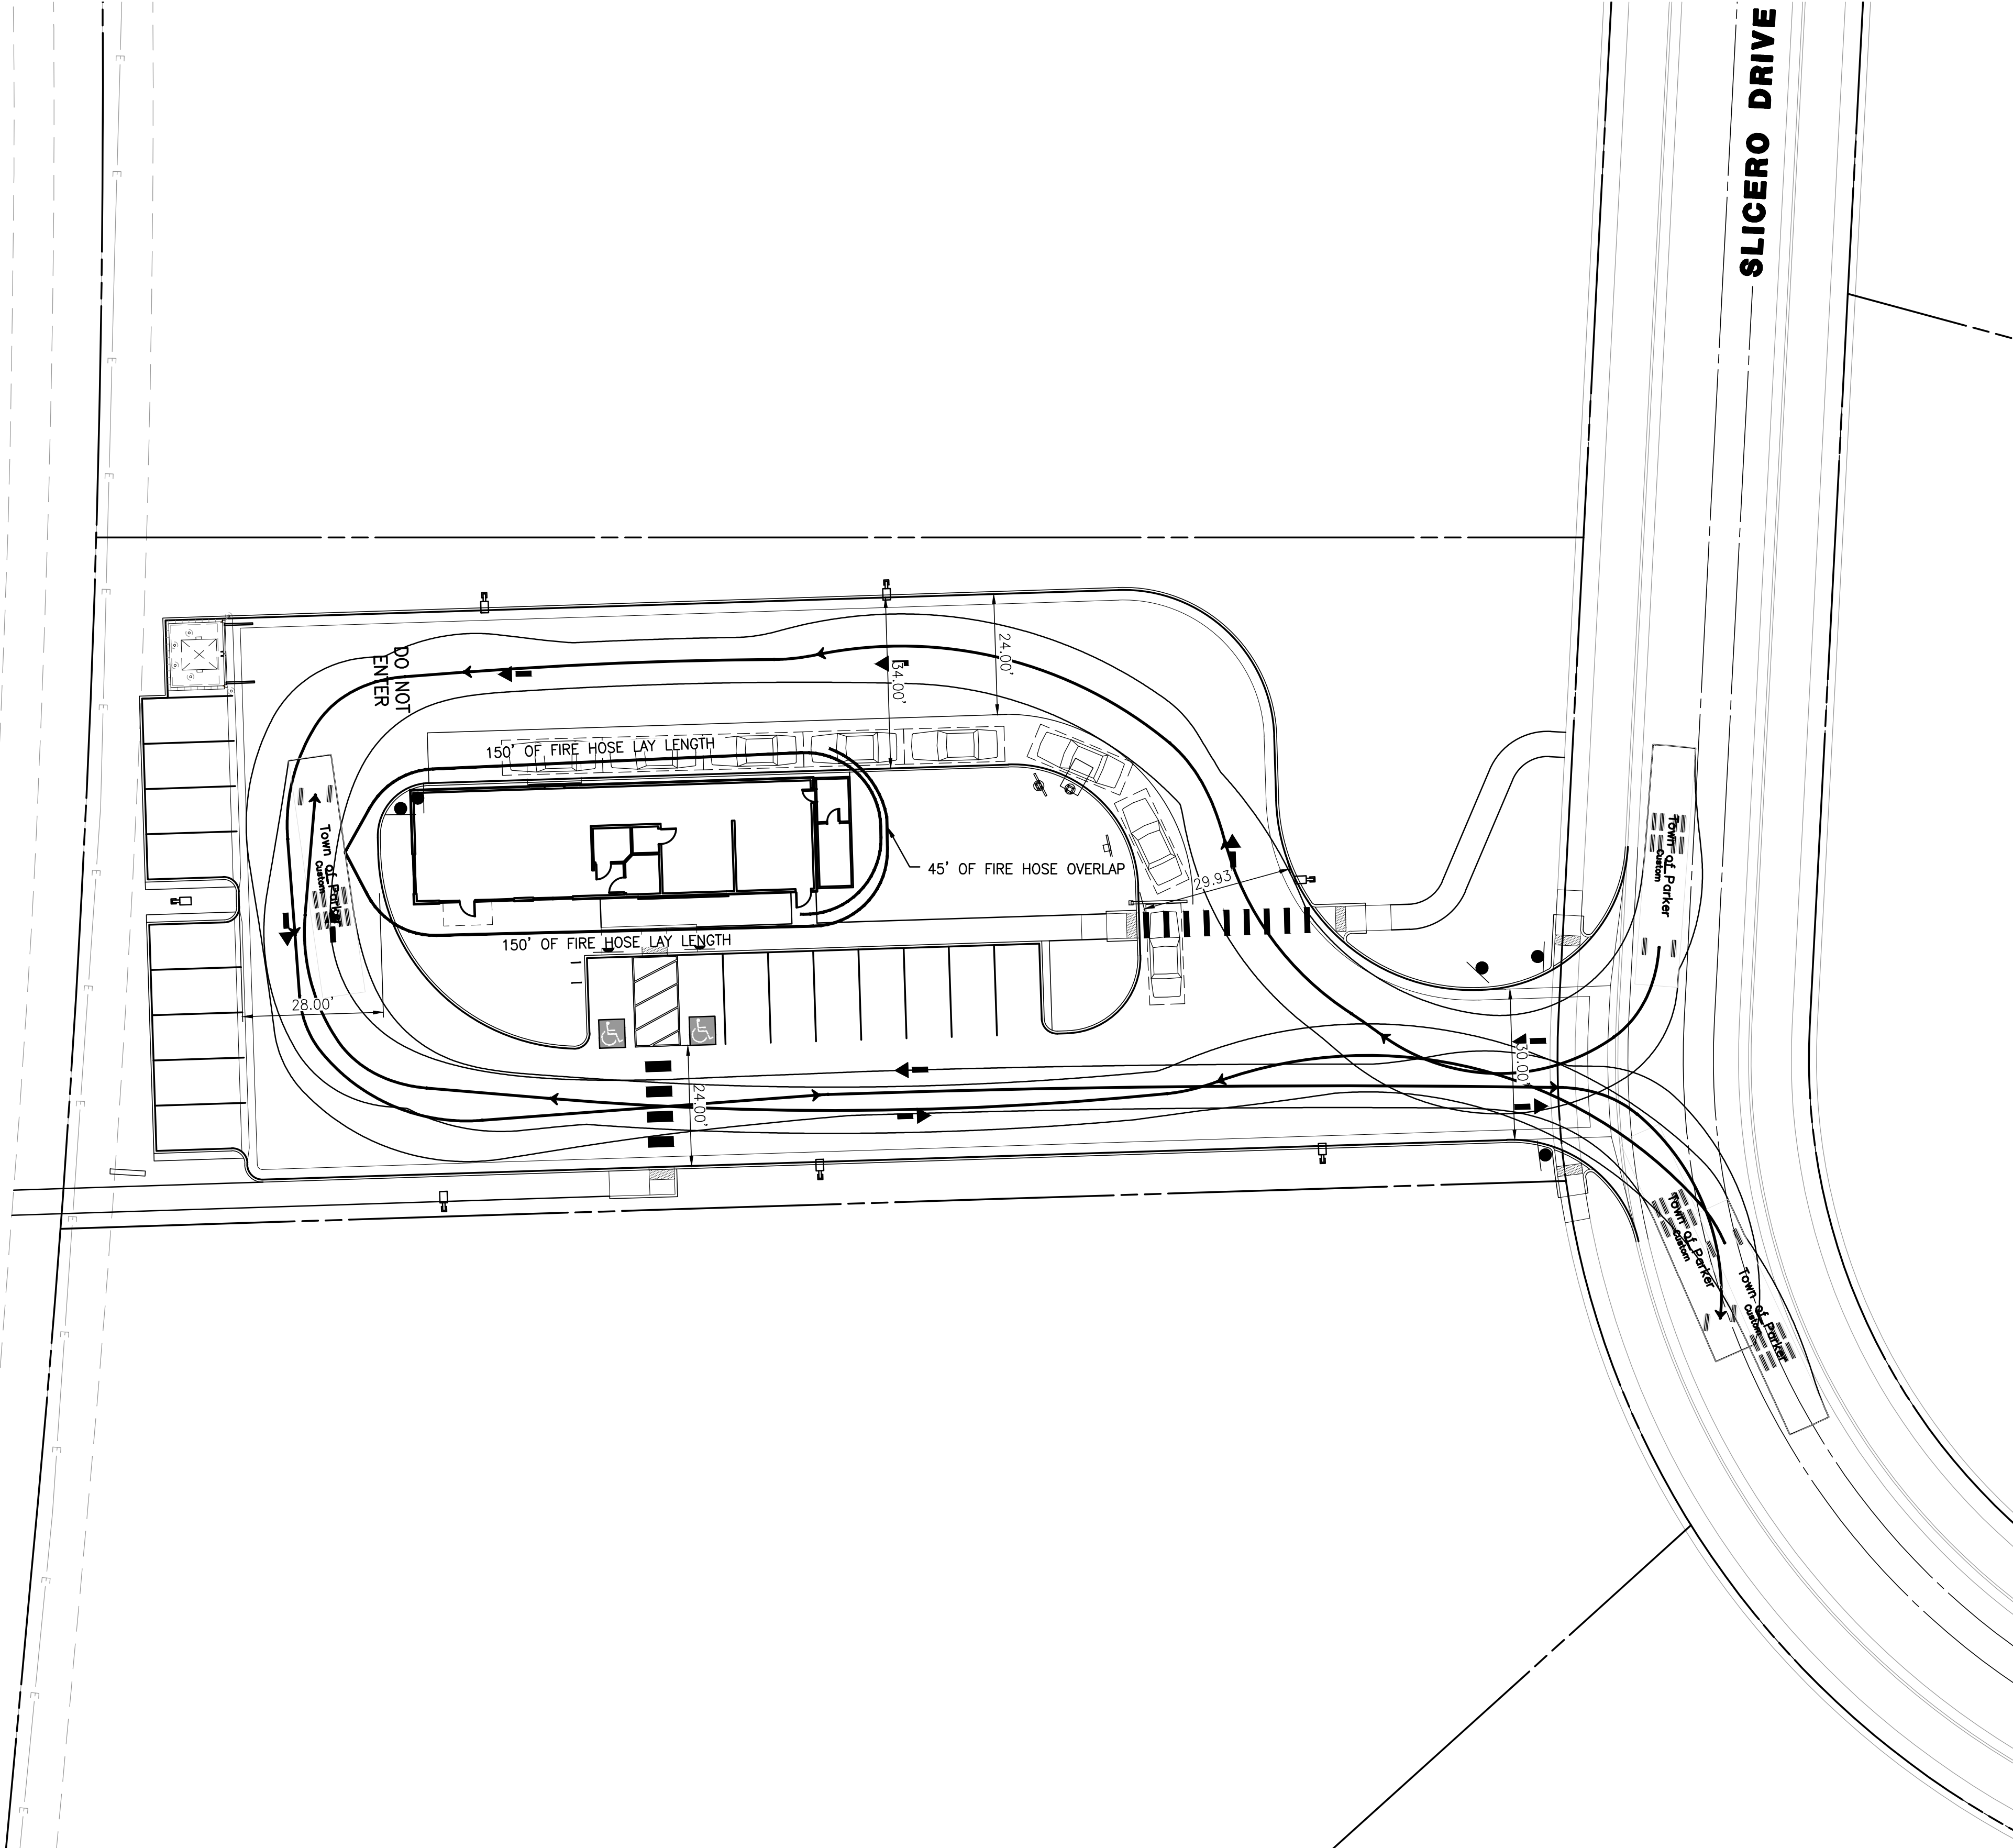SLICERO DRIVE

LENGTH: 47.79'
WIDTH: 8.50'
HEIGHT: 10.75'
MIN GROUND CLEARANCE: 1.55'
TRACK WIDTH : 6.92'
LOCK TO LOCK TIME : 5.0sec
WALL TO WALL TURNING RADIUS : 46.67'

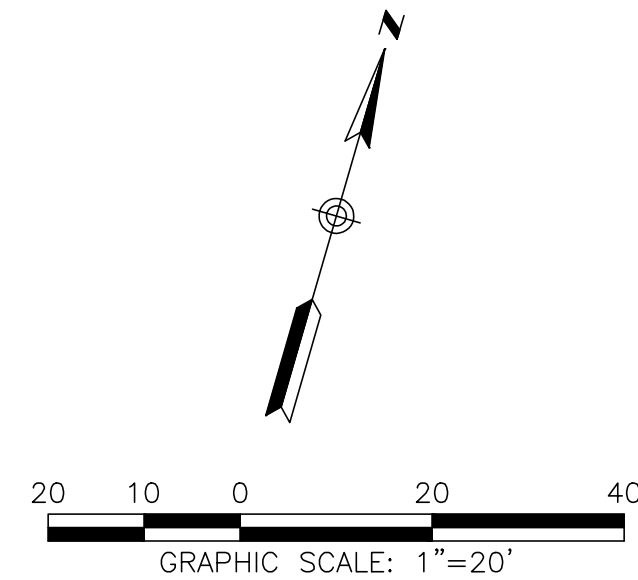

SITE PLAN PREPARED FOR:

**DOUGLAS 234, FILING NO. 6,
AMENDMENT 1, LOT 4**

DOUGLAS COUNTY, COLORADO

FIRE TRUCK ACCESS PLAN



Know what's **below**.
Call before you dig.

DRAWING NO.

5

SEAL:

8678 CONCORD CENTER DR, UNIT 200
ENGLEWOOD, CO 80112

rickengineering.com

City - Las Vegas - Denver

KA/JS

WN/DESIGNED BY:

2243	DRA
------	-----

NO:

PROJECT

2ND SUBMITTAL

A PORTION OF THE SOUTHWEST QUARTER OF THE SOUTHEAST QUARTER OF SECTION 29,
TOWNSHIP 6 SOUTH, RANGE 66 WEST, 6TH PRINCIPAL MERIDIAN,
TOWN OF PARKER, COUNTY OF DOUGLAS, STATE OF COLORADO
0.901 ACRES, 1 COMMERCIAL LOT

GENERAL LANDSCAPE REQUIREMENTS					
VEGETATION REQUIRED BASED ON LOT PERMEABLE AREA (ROW, STREETSCAPE & PARKING LOT REQUIREMENTS NOT INCLUDED)					
	CALCULATION	# REQUIRED	# PROVIDED	EVERGREEN REQ. AT 25%-50%	# EVERGREEN PROVIDED
ONE (1) TREE / 1,500 SF OF PERMEABLE AREA	13,160 SF / 1,500 SF	9	15	3 - 5	8
FIVE (5) SHRUBS / 1,500 SF OF PERMEABLE AREA	13,160 SF / 1,500 SF x 5	44	355	11 - 22	120
75% MATURE VEGETATIVE GROUND COVER	13,160 SF x .75	9,870 SF	9,900 SF	NA	NA

1. THE CONTRACTOR SHALL FOLLOW THE LANDSCAPE PLANS AND SPECIFICATIONS AS CLOSELY AS POSSIBLE. ANY SUBSTITUTION OR ALTERATION SHALL NOT BE ALLOWED WITHOUT APPROVAL OF THE OWNER'S REPRESENTATIVE. OVERALL PLANT QUANTITY AND QUALITY SHALL BE CONSISTENT WITH THE PLANS.
2. THE CONTRACTOR IS RESPONSIBLE FOR VERIFYING ALL PLANT QUANTITIES.
3. THE OWNER'S REPRESENTATIVE RESERVES THE RIGHT TO INSPECT AND TAG ALL PLANT MATERIAL PRIOR TO SHIPPING TO THE SITE. IN ALL CASES, THE OWNER'S REPRESENTATIVE MAY REJECT PLANT MATERIAL AT THE SITE IF MATERIAL IS DAMAGED, DISEASED, OR DECLINING IN HEALTH AT THE TIME OF ONSITE INSPECTIONS OR IF THE PLANT MATERIAL DOES NOT MEET THE MINIMUM SPECIFIED STANDARD IDENTIFIED ON THE PLANS AND IN THE SPECIFICATIONS. THE CONTRACTOR SHALL COORDINATE WITH THE OWNER'S REPRESENTATIVE FOR INSPECTION AND APPROVAL OF ALL MATERIALS AND PRODUCTS PRIOR TO INSTALLATION.
4. THE CONTRACTOR SHALL WARRANTY ALL CONTRACTED WORK AND MATERIALS FOR A PERIOD OF ONE YEAR AFTER SUBSTANTIAL COMPLETION HAS BEEN ISSUED BY THE OWNER'S REPRESENTATIVE FOR THE ENTIRE PROJECT UNLESS OTHERWISE SPECIFIED IN THE CONTRACT DOCUMENTS OR SPECIFICATIONS.
5. ALL WEEDS TO BE REMOVED AND DISPOSED OF.
6. TREES SHALL NOT BE LOCATED IN DRAINAGE SWALES, DRAINAGE AREAS, OR UTILITY EASEMENTS. CONTACT OWNER'S REPRESENTATIVE FOR RELOCATION OF PLANTS IN QUESTIONABLE AREAS PRIOR TO INSTALLATION.
7. ALL ROCK MULCH PLANTER BEDS TO HAVE 1 ½" RIVER ROCK AT A MINIMUM 3" DEPTH OVER MIRAFI WEED BARRIER FABRIC AND SHALL BE REGULARLY REPLENISHED.
8. ALL PLANTING SHALL BE MAINTAINED IN A HEALTH AND ATTRACTIVE MANNER AS DETERMINED BY THE TOWN. MAINTENANCE SHALL BE CONDUCTED BY THE PROPERTY OWNER OF RECORD, THE PROPERTY EXPERT OWNER'S AGENT OR TENANT WHICH HAS ASSUMED LANDSCAPE MAINTENANCE RESPONSIBILITY.

1. EXCAVATE PLANTING HOLES WITH SLOPING SIDES. MAKE EXCAVATIONS AT LEAST THREE TIMES AS WIDE AS THE ROOT BALL DIAMETER AND NO DEEPER THAN THE DISTANCE FROM THE TOP MOST ROOTS IN THE ROOT BALL TO THE BOTTOM OF THE ROOT BALL TO ALLOW FOR SETTLING. DO NOT DISTURB SOIL AT BOTTOM OF PLANTING HOLES, BUT DO SCORE THE SIDES OF THE PLANTING HOLE. THE PLANTING AREA SHALL BE LOOSENED AND AERATED AT LEAST THREE TIMES THE DIAMETER OF THE ROOT BALL. BACKFILL SHALL CONSIST OF EXISTING ON SITE TOPSOIL – NO AMENDMENTS SHALL BE USED UNLESS OTHERWISE SPECIFIED.
2. TREES SHALL BE PLANTED WITH THE ROOT COLLAR/FLARE VISIBLE ABOVE GRADE AND TWO OR MORE STRUCTURAL ROOTS LOCATED WITHIN THE TOP 1" TO 2" OF THE ROOT BALL/FINISHED GRADE MEASURED 3" TO 4" FROM TRUNK. THIS INCLUDES TREES THAT ARE SET ON SLOPES (SEE SLOPE PLANTING DETAIL). TREES THAT DO NOT HAVE A VISIBLE ROOT COLLAR SHALL BE REJECTED. DO NOT COVER THE ROOT BALL WITH SOIL.
3. WHEN ROOT BALL WILL REMAIN INTACT, CUT OFF BOTTOM 1/4 OF WIRE BASKET BEFORE PLACING TREE IN HOLE, CUT OFF REMAINDER OF BASKET AFTER TREE IS SET IN HOLE, REMOVE BASKET COMPLETELY. AT A MINIMUM, THE TOP 2/3 OF THE BURLAP AND BASKET SHALL BE REMOVED FROM THE ROOT BALL ON ALL TREES. REMOVE ALL NYLON TIES, TWINE, ROPE AND BURLAP. REMOVE UNNECESSARY PACKING MATERIAL.
4. FORM SOIL INTO A 3" TO 5" TALL WATERING RING (SAUCER) AROUND PLANTING AREA. THIS IS NOT NECESSARY IN IRRIGATED TURF AREAS. APPLY 2" TO 4" DEPTH OF SPECIFIED MULCH OVER PLANTING AREA AND INSIDE SAUCERS, AWAY FROM TRUNK.
5. STAKING AND GUYING OF TREES IS OPTIONAL IN MOST PLANTING SITUATIONS. IN AREAS OF EXTREME WINDS, OR ON STEEP SLOPES, STAKING MAY BE REQUIRED TO STABILIZE TREES. STAKING AND GUYING MUST BE REMOVED WITHIN 1 YEAR OF PLANTING DATE.
6. TREE WRAP IS NOT TO BE USED ON ANY NEW PLANTINGS, EXCEPT IN LATE FALL PLANTING SITUATIONS, AND ONLY THEN AFTER CONSULTATION WITH THE TOWN ARBORIST.
7. RESETTING OF IMPROPERLY PLANTED TREES WILL ONLY BE ALLOWED IF IT IS DETERMINED THAT DOING SO WILL IN NO WAY COMPROMISE THE ROOT BALL, AND SHALL ONLY BE DONE WITH APPROVAL OF THE TOWN ARBORIST.

* TEN (10) SHRUBS MAY BE SUBSTITUTED FOR ONE (1) TREE

VEGETATION REQUIREMENTS BASED ON LARGEST PARKING ISLAND AREA

	CALCULATION	# REQUIRED	# PARKING ISLANDS	# PROVIDED
ONE (1) TREE / INCREMENTAL 162 SF	267 SF / 162 SF	1 / ISLAND	1	0
FIVE (5) SHRUBS / INCREMENTAL 162 SF	267 SF / 162 SF x 5	5 / ISLAND	1	13
THREE (3) ORNAMENTAL GRASSES SUBSTITUTED FOR ONE (1) SHRUB	2 SHRUBS x 3 GRASSES	3 / SHRUB	1	19








A PORTION OF THE SOUTHWEST QUARTER OF THE SOUTHEAST QUARTER OF SECTION 36,
TOWNSHIP 6 SOUTH, RANGE 66 WEST, 6TH PRINCIPAL MERIDIAN,
TOWN OF PARKER, COUNTY OF DOUGLAS, STATE OF COLORADO
0.901 ACRES, 1 COMMERCIAL LOT

Diagram illustrating the correct method for planting a tree, showing the root ball, soil, mulch, and support structures.

Annotations:

- USE 3 GUY ASSEMBLIES FOR EVERGREENS AND TREES OVER 3" CAL.
- ROOT COLLAR VISIBLE TOP MOST ROOTS WITHIN 1"-2" OF EXISTING/ FINAL GRADE
- 2"-4" OF ORGANIC MULCH APPLIED OVER PLANTING AREA AND AWAY FROM TRUNK
- EXISTING GRADE
- BACKFILL WITH UNAMENDED TOPSOIL FROM HOLE
- BURLAP, ROPE, AND WIRE REMOVED FROM TOP 2/3 OF ROOT BALL AT MINIMUM
- ROOTBALL SITTING DIRECTLY ON TOP OF UNDISTURBED SOIL
- PRUNE ALL DEAD OR DAMAGED WOOD AFTER PLANTING
- USE GROMMETTED TREE STRAPS AT END OF WIRE
- 12 GAUGE GALVANIZED WIRE
- 24" x 3/4" P.V.C. MARKERS (TYPICAL) OVER WIRES.
- TREATED WOOD POST
- USE 2 GUY ASSEMBLIES FOR TREES UNDER 3".
- SLOPE SIDED HOLE IS 3 TIMES AS WIDE AS THE ROOT BALL DIA.

SCALE: N.T.S.

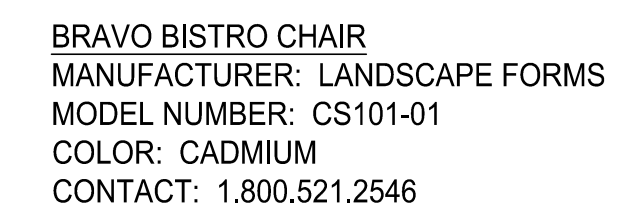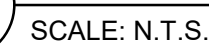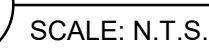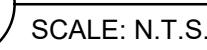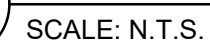

A PORTION OF THE SOUTHWEST QUARTER OF THE SOUTHEAST QUARTER OF SECTION 29,
TOWNSHIP 6 SOUTH, RANGE 66 WEST, 6TH PRINCIPAL MERIDIAN,
TOWN OF PARKER, COUNTY OF DOUGLAS, STATE OF COLORADO
0.901 ACRES, 1 COMMERCIAL LOT

A PORTION OF THE SOUTHWEST QUARTER OF THE SOUTHEAST QUARTER OF SECTION 29,
TOWNSHIP 6 SOUTH, RANGE 66 WEST, 6TH PRINCIPAL MERIDIAN,
TOWN OF PARKER, COUNTY OF DOUGLAS, STATE OF COLORADO
0.901 ACRES, 1 COMMERCIAL LOT

IRRIGATION – GENERAL

ALL WORK SHALL CONFORM TO TOWN OF PARKER STANDARDS AND SPECIFICATIONS AND WITH THE ACCEPTED PLANS. REFER TO THESE STANDARDS FOR ADDITIONAL INFORMATION AS NEEDED. A COPY OF THESE SPECIFICATIONS SHALL BE AVAILABLE ON THE WORK SITE AT ALL TIMES.

THIS SYSTEM DESIGN ASSUMES A STATIC PRESSURE OF 70 PSI AT THE POINT OF CONNECTION. CONTRACTOR RESPONSIBLE FOR VERIFYING PRESSURE AND FLOW. CONTRACTOR RESPONSIBLE FOR COORDINATION OF ELECTRICAL INSTALLATION OF CONTROLLER.

INSTALL CONTROLLER ON PEDESTAL AT APPROXIMATE LOCATION SHOWN ON PLANS,
COORDINATE LOCATION WITH OWNER.

INSTALL ALL ELECTRICAL IN ACCORDANCE WITH NATIONAL ELECTRICAL CODE AND ALL APPLICABLE LOCAL CODES.

DO NOT PROCEED WITH THE INSTALLATION OF THE IRRIGATION SYSTEM WHEN IT IS OBVIOUS IN THE FIELD THAT OBSTRUCTIONS OR GRADE DIFFERENCES EXIST THAT WILL AFFECT THE EFFICIENCY OF THE IRRIGATION SYSTEM. CONTACT OWNERS REPRESENTATIVE FOR CLARIFICATION. IF DISCREPANCIES IN NOTES, DETAILS OR SPECIFICATIONS EXIST CONTACT OWNER'S REPRESENTATIVE TO CLARIFY.

DRAWINGS ARE DIAGRAMMATIC, IRRIGATION SYSTEM IS TO BE INSTALLED IN LANDSCAPE AREAS.

CONTRACTOR RESPONSIBLE FOR INSTALLATION OF ALL IRRIGATION SLEEVING.
COORDINATE ALL SLEEVE INSTALLATION WITH OTHER TRADES.

ALL DRIP LINES TO BE INSTALLED BELOW GRADE AND BROUGHT TO THE BASE OF PLANTS.

THE CONTRACTOR SHALL CERTIFY THAT THE GRADE IS WITHIN PLUS OR MINUS ONE-TENTH (1/10TH) OF THE FINAL GRADING PLAN PRIOR TO COMMENCEMENT OF ANY LANDSCAPE OR IRRIGATION WORK. THE CONTRACTOR SHALL BE RESPONSIBLE FOR ALL PERMITS, FEES, AND LICENSES ASSOCIATED WITH THE WORK AS SHOWN ON THE PLANS.

THE CONTRACTOR SHALL BE RESPONSIBLE FOR UTILITY LOCATIONS PRIOR TO ANY EXCAVATION

ANY REVISION TO THE IRRIGATION PLAN SHALL BE REVIEWED AND APPROVED BY THE TOWN OF PARKER PRIOR TO IMPLEMENTATION.

THE CONTRACTOR SHALL HAVE ACCEPTED SET OF PLANS AND MUST HAVE HELD A PRE-CONSTRUCTION MEETING WITH OWNERS REPRESENTATIVE PRIOR TO COMMENCEMENT OF ANY AND ALL WORK.

THE CONTRACTOR SHALL WARRANTY THE WORKMANSHIP AND IRRIGATION SYSTEM FOR A PERIOD OF TWO YEARS.

DO NOT DISTURB PAVING, LIGHTING, LANDSCAPE OR IRRIGATION THAT EXISTS ADJACENT TO THE SITE UNLESS OTHERWISE NOTED ON PLANS.

THE CONTRACTOR SHALL IDENTIFY, VERIFY AND PROTECT CONTROL POINT. CONTRACTOR SHALL VERIFY LOCATION OF CONTROL POINT WEEKLY AND THE ORIGINAL CONDITION OF CONTROL POINT PIN SHALL BE MAINTAINED THROUGHOUT ENTIRE PROJECT. LOCATION AND G.P.S. COORDINATES OF THE CONTROL POINT SHALL BE IDENTIFIED ON ALL PLANS AND AS-BUILTS.

THE IRRIGATION SYSTEM SHALL BE INSTALLED AFTER SOIL PREPARATION AND PRIOR TO PLANT MATERIALS.

IRRIGATION – INSPECTIONS

CONTRACTOR SHALL BE RESPONSIBLE FOR THE SCHEDULING AND COORDINATION OF ALL REQUIRED INSPECTIONS WITH OWNERS REPRESENTATIVE AND THE TOWN OF PARKER. REFER TO TOWN OF PARKER STANDARDS AND SPECIFICATIONS FOR ALL REQUIRED INSPECTIONS.

THE IRRIGATION SYSTEM SHALL PASS A MAINLINE PRESSURE TEST AND COVERAGE TEST AND A WATERING SCHEDULE WITH RUN TIMES AND APPLICATION RATES SHALL BE SUBMITTED PRIOR TO SODDING, SEEDING, OR PLANTING.

CONTRACTOR SHALL SCHEDULE PRESSURE TEST AT COMPLETION OF MAINLINE, MAINLINE SHALL HOLD AT SEVENTY (70) P.S.I. FOR TWO (2) HOURS.

IRRIGATION – AS-BUILTS

APPROVED CONSTRUCTION DRAWINGS SHALL BE ON SITE AND UPDATED DAILY WITH AS-BUILT MARKUPS. CONTRACTOR SHALL MAKE AS-BUILTS AVAILABLE ON SITE TO TOWN STAFF AND OWNERS REPRESENTATIVE FOR REVIEW AND INSPECTION IMMEDIATELY UPON REQUEST.

RECORD ALL CHANGES WHICH ARE MADE FROM THE CONTRACT DRAWINGS. RECORD ALL REQUIRED INFORMATION ON AS-BUILT DRAWINGS. DO NOT USE THESE PRINTS FOR ANY OTHER PURPOSE.

IRRIGATION MATERIAL LEGEND

SYMBOL	MANUFACT.	MODEL NO. / DESCRIPTION	
	HUNTER	HYDRAWISE X2-1400, IRRIGATION CONTROLLER 'A' 14 STATION CONTROLLER, 13 STATIONS USED	A/9
	P.O.C 'A'	METER, P.O.C. 'A' - 1" POTABLE TAP. STATIC WATER PRESSURE IS ASSUMED TO BE 70 PSI, CONTRACTOR TO FIELD VERIFY AND NOTIFY LANDSCAPE ARCHITECT IMMEDIATELY IF DIFFERENT	B/9
	FEBCO	BACKFLOW PREVENTION ASSEMBLY 825-YA SPARKERS W/MODEL 650 WYE STRAINER SIZE OF P.O.C. (1"). IN STRONG BOX ENCLOSURE. ALL PIPING BETWEEN METER AND BACKFLOW DEVICE SHALL BE 1/2" COPPER OR RED BRASS.	B & C/9
	RAINBIRD	BRASS MASTER VALVE, EFB-CP-PRS-D, SIZE OF P.O.C. NORMALLY CLOSED WITH PRESSURE REGULATING MODULE. MASTER VALVE SHALL BE INSTALLED IN A 'JUMBO' SIZE VALVE BOX WITH LOCKING COVER AND 'MCV' HEAT BRANDED ON COVER	B & D/9
	HUNTER	RAIN-CLIK FLOW SENSOR. INSTALL PER MANUFACTURER'S RECOMMENDATIONS.	B/9, B/10
	RAINBIRD	QUICK COUPLER VALVE 44RC WITH LOCKING RUBBER COVER. INSTALLED IN 10" ROUND VALVE BOX WITH 'QCV' HEAT BRANDED ON COVER INSTALL QCV ON A 1" STUB-OUT OFF MAINLINE.	D/10
	RAINBIRD	PEB, REMOTE CONTROL VALVE. BOX WITH LOCKING VALVE COVER AND 'RCV' HEAT BRANDED ON COVER.	A/11
	RAINBIRD	CXZ-150-PRB-COM, 1" REMOTE CONTROL DRIP VALVE KIT. BOX WITH LOCKING VALVE COVER AND 'RCV' HEAT BRANDED ON COVER.	C/11
	AS APPROVED	MAINLINE, CLASS 200 PVC SOLVENT WELD FITTINGS	H/10
	AS APPROVED	LATERAL LINE, CLASS 200 PVC SOLVENT WELD FITTINGS	H/10
	AS APPROVED	HUNTER HDL-CV DRIP TUBING WITH EMITTERS TO BASE OF PLANTS	E/9
	AS APPROVED	SLEEVING, SCH. 40 PVC PIPE, MINIMUM 4" DIAMETER FOR PIPING, LARGER WHERE APPROPRIATE. A SEPARATE 2" SLEEVE, FOR WIRE UNDER ALL PAVED SURFACES.	D, H/11
	RAINBIRD	SHRUBS - POINT SOURCE DRIP ZONE, XERIBUG DRIP EMITTERS ON A STAKE CONNECTED TO POLY DRIP TUBING PER DETAIL.	E/9
NOT SHOWN	AS APPROVED	WIRE SPLICES ALLOWED ONLY WHERE RUNS EXCEED 2500'. PULL BOXES FOR WIRE SPLICES. PULL BOXES SHALL BE 12" RECTANGULAR WITH LOCKING LID.	I/10
NOT SHOWN	NETAFIM	DRIP END FLUSH, NETAFIM TL050MFV-1, INSTALL ON PVC EXHAUST MANIFOLD WITHIN VALVE BOX AT LOWEST ELEVATION AND ALL END RUN(S) IN SYSTEM. INSTALL MIN. TYP AS REQUIRED.	

IRRIGATION MATERIAL LEGEND (HEADS):




SYMBOL		MANF.	MODEL NO. / DESCRIPTION	GPM	PRECIP	PSI	RADIUS FT.	DETAIL
Q	H F							
③	⑩	HUNTER	PROS-04-PRS30-8A 4" HIGH POP-UP W/ 8A BROWN NOZZLE	.44, .88, 1.76	3.06	30	8	B/11
⑥	⑩	HUNTER	PROS-04-PRS30-10A 4" HIGH POP-UP W/ 10A RED NOZZLE	.50, 1.00, 2.00	2.22	30	10	B/11

LATERAL PIPE SIZING CHART:

CLASS 200 PIPE	GPM
3/4"	0-10
1"	11-16
1-1/4"	17-26
1-1/2"	27-36
2"	37-55
2-1/2"	56-80

SLEEVING SCHEDULE

PIPE SIZE	SLEEVE SIZE
1/2"	2"
3/4"	2"
1"	2"
1-1/4"	3"
1-1/2"	3"
2"	4"
2-1/2"	6"
3"	6"

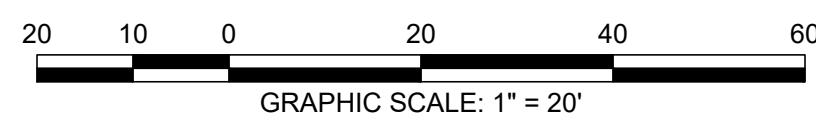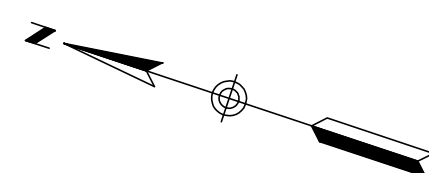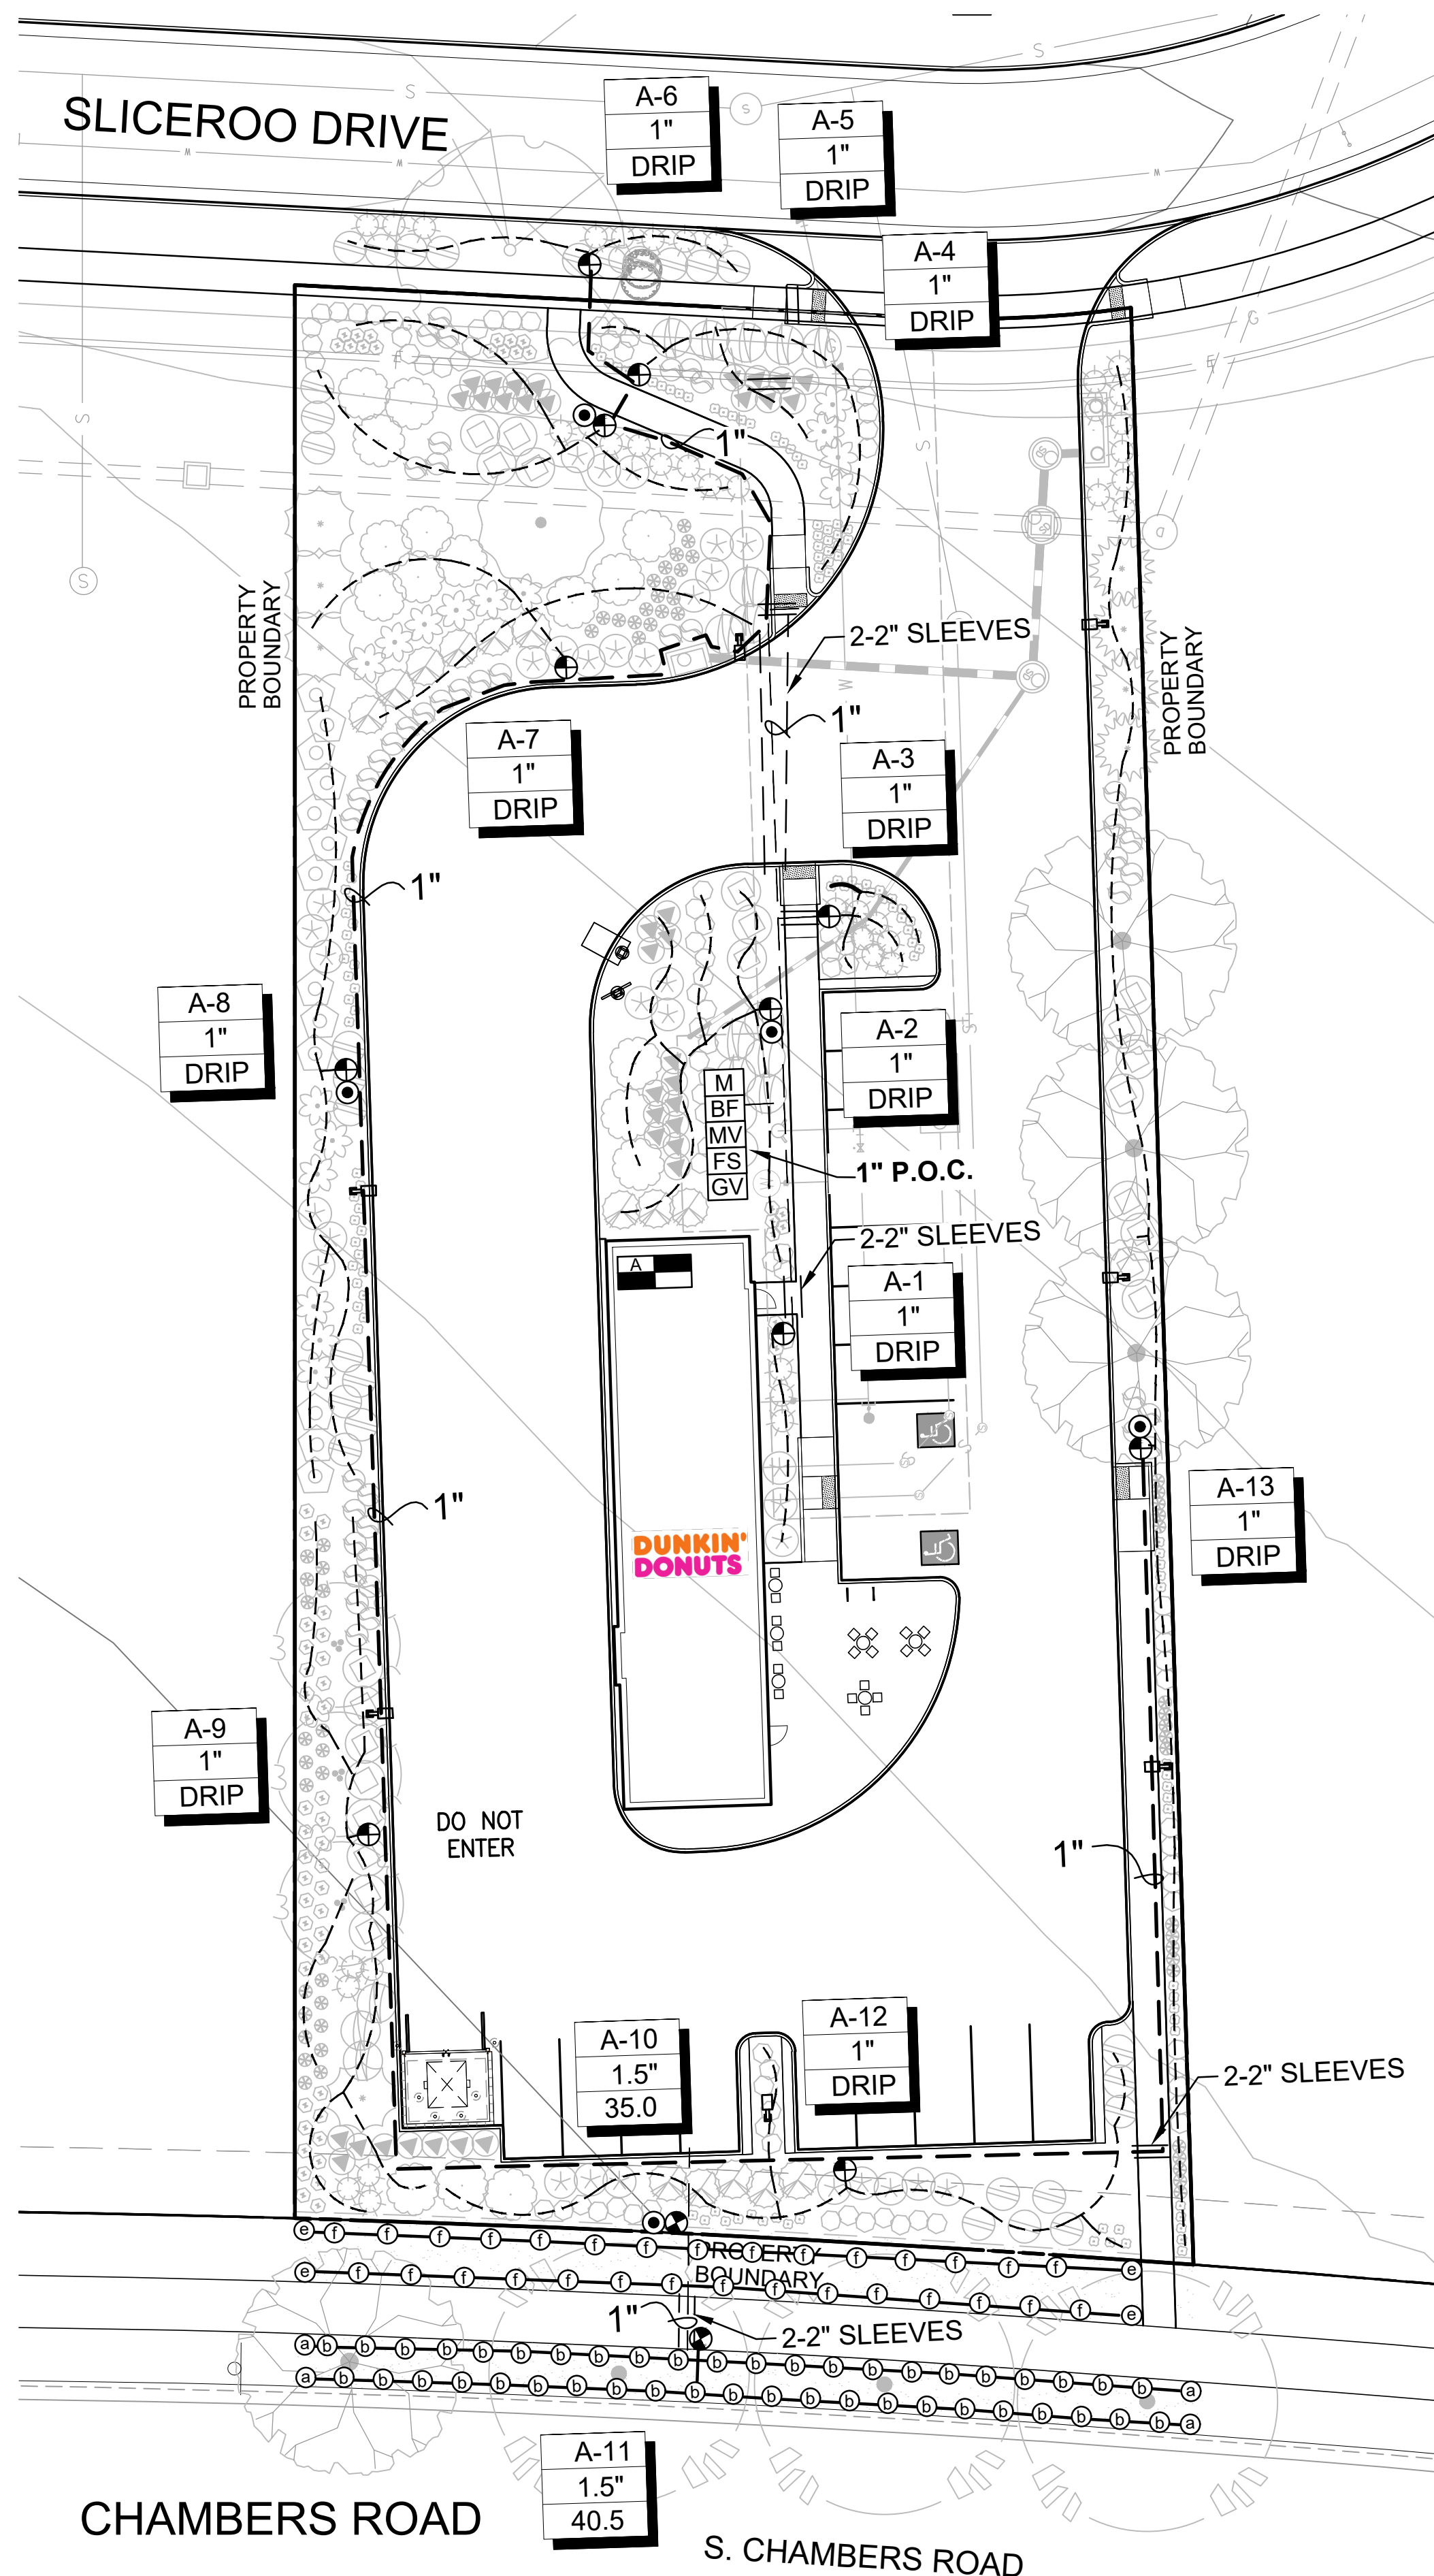

SITE PLAN PREPARED FOR:

DOUGLAS 234, FILING NO. 6,
AMENDMENT 1, LOT 4

DOUGLAS COUNTY, COLORADO

LANDSCAPE IRRIGATION & DETAILS



DRAWING NO.

8

2ND SUBMITTAL

SITE PLAN FOR
DUNKIN' DONUTS
DOUGLAS 234, FILING NO. 6,
AMENDMENT 1, LOT 4

A PORTION OF THE SOUTHWEST QUARTER OF THE SOUTHEAST QUARTER OF SECTION 29,
TOWNSHIP 6 SOUTH, RANGE 66 WEST, 6TH PRINCIPAL MERIDIAN,
TOWN OF PARKER, COUNTY OF DOUGLAS, STATE OF COLORADO
0.901 ACRES, 1 COMMERCIAL LOT



Landscape/Irrigation Worksheet

Project Name: Dunkin' Donuts

Landscape/Irrigation Tap address (physical location of tap) 12211 Sliceroo Drive, Parker, CO

Landscape Area	High Water TURF (6,000sf = 1 SFE)	Low Water Native Grass and Spray Shrubs & Perennials (10,000sf = 1 SFE)	Drip Irrigated area (20,000sf = 1 SFE)	Sub-Total of (calculated) Areas		PWSD one SFE per 6000	SFE Requirement (Sub-Total Calculation divided by 6000 = requirement)
				Non-Irrigated area			
Area #1	2,330 sf x 1 = 2,330	0 sf x .6 = 0	13,830 sf x .3 = 4,149	0 sf x 0 = 0	6,479 sf	6,000	1.079 SFE's


Worksheet Completed by: Kim Nelson
Company: RICK Engineering
Address: 5690 Webster St., Arvada, CO 80002
Phone #: 303-423-6036

Owner/Developer: First Cup Dunkin' Donuts, LLC
Attn: Brian Zurek
Billing Address: 106 S. Kyrene Rd, Ste 2, Chandler, AZ 85226
Phone #: 480-313-2724


ET Controller (with Rain Sensor)

Manufacturer	Hunter
Model number	Hydrawise X2-1400

Tap Size Requirements:
0 - 1 SFE's requires a 3/4-inch tap
1.1 - 2.0 SFE's requires a 1-inch tap
2.1 - 4.0 SFE's requires a 1 1/2-inch tap
4.1 - 7.0 SFE's requires a 2-inch tap
7.1 - 16.0 SFE's requires a 3-inch tap

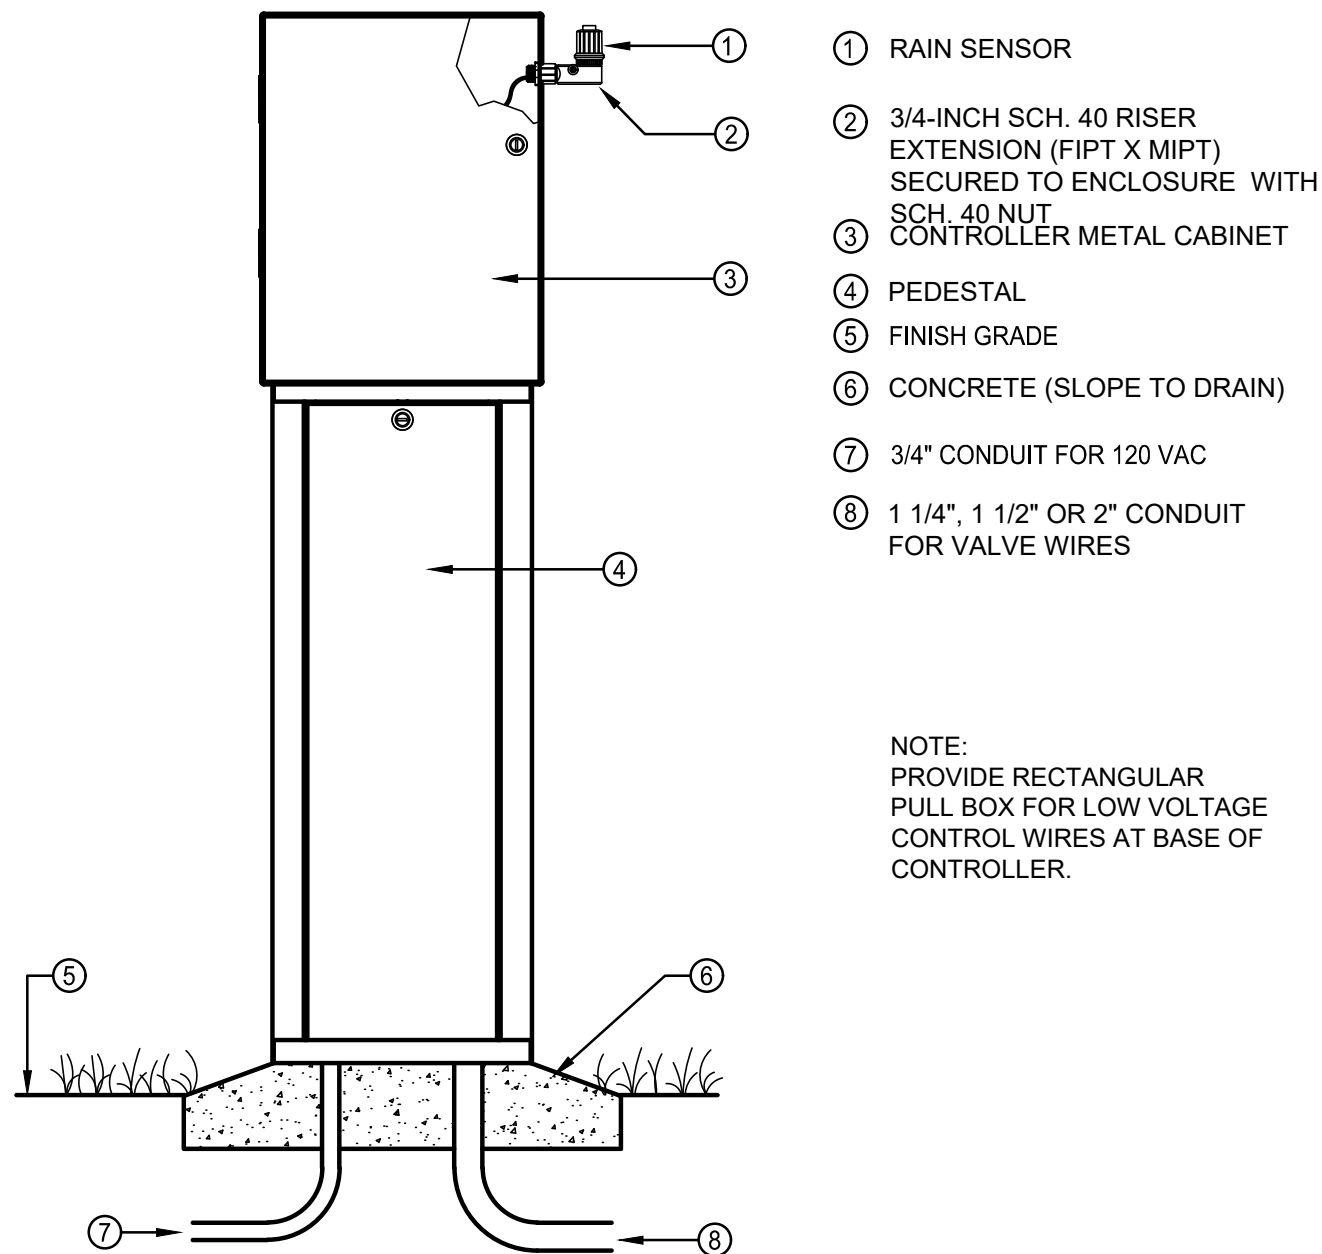


A CONTROLLER PEDESTAL MOUNT
SCALE: N.T.S.

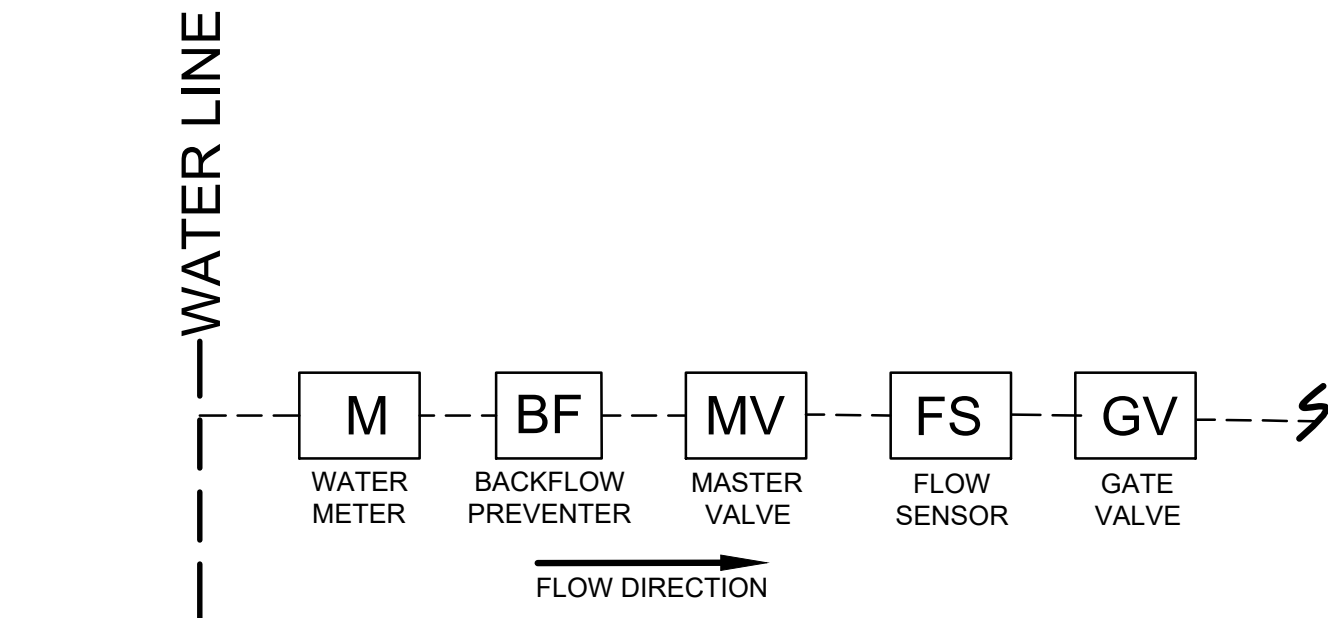


B POINT OF CONNECTION (P.O.C.)
SCALE: N.T.S.


- NOTE:
- CONCRETE PAD PENETRATIONS TO BE 1" LARGER THAN TUBING DIAMETER.
 - REFER TO ENCLOSURE DETAIL FOR CONCRETE PAD DIMENSIONS.
 - DIAMETER OF FITTINGS, NIPPLE AND TUBING SHALL EQUAL DIAMETER OF BACKFLOW PREVENTER UNLESS OTHERWISE NOTED.

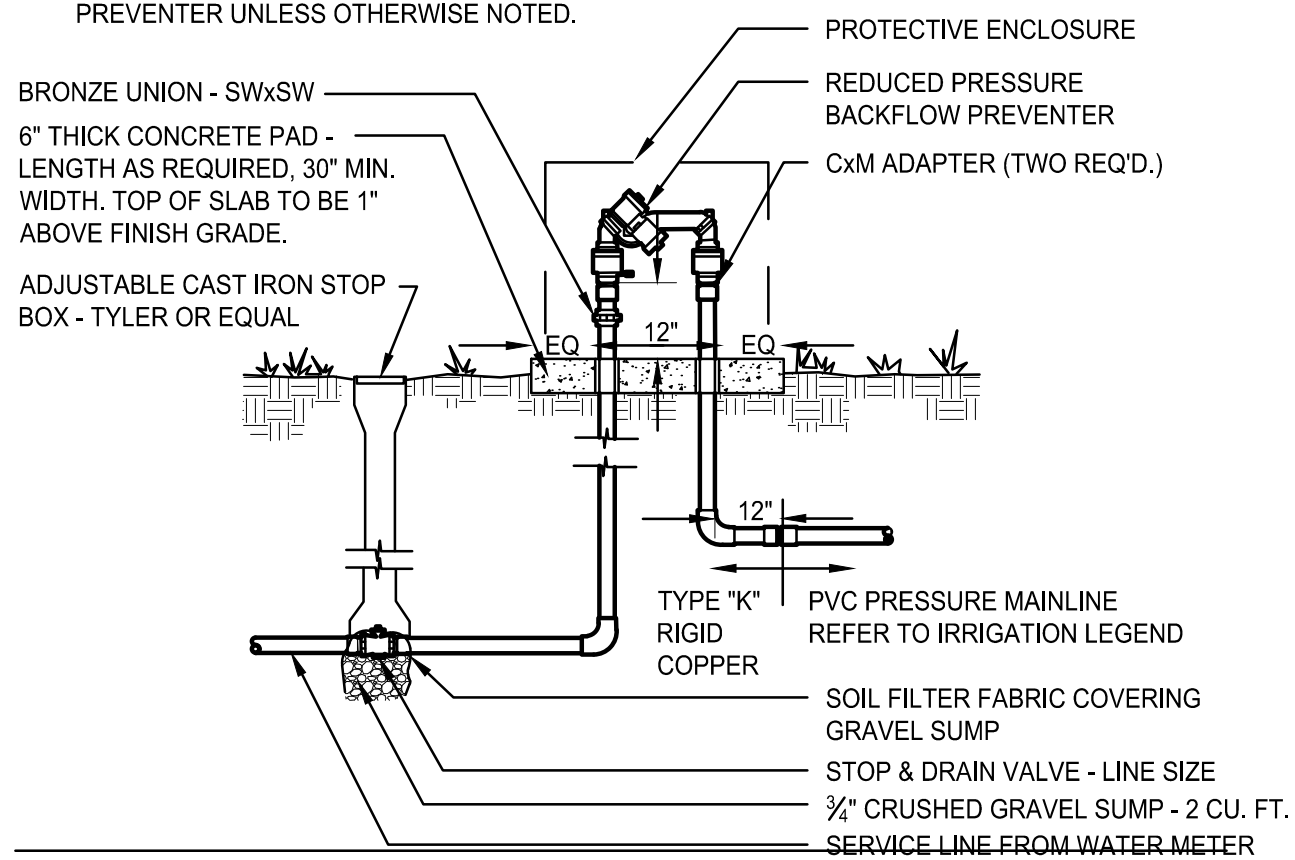

C BACKFLOW PREVENTER
SCALE: N.T.S.

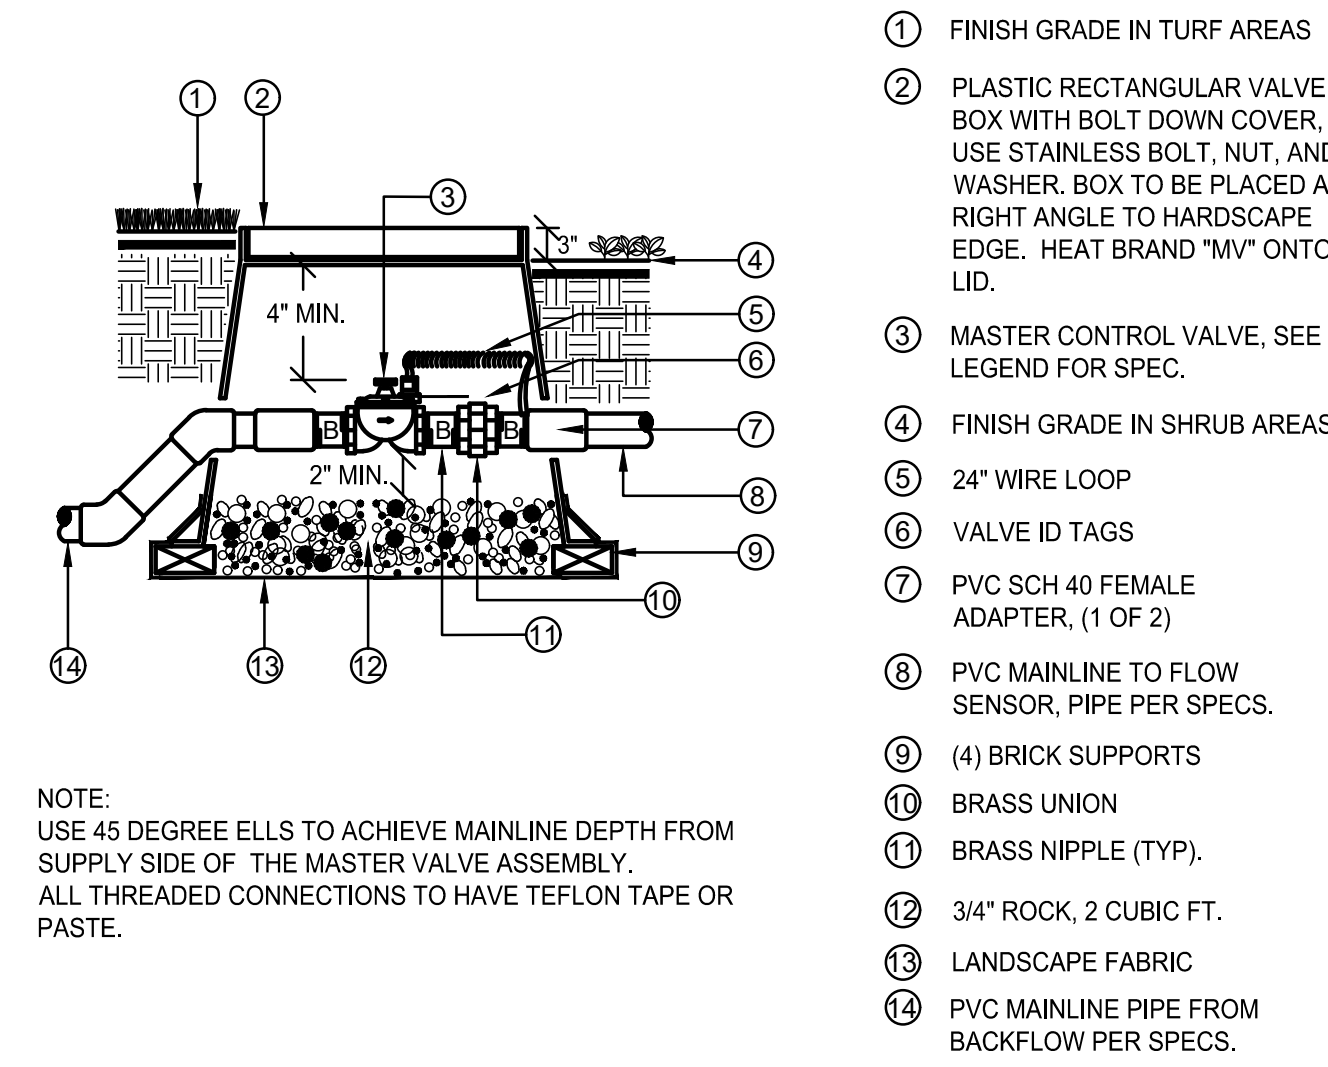

D MASTER VALVE
SCALE: N.T.S.

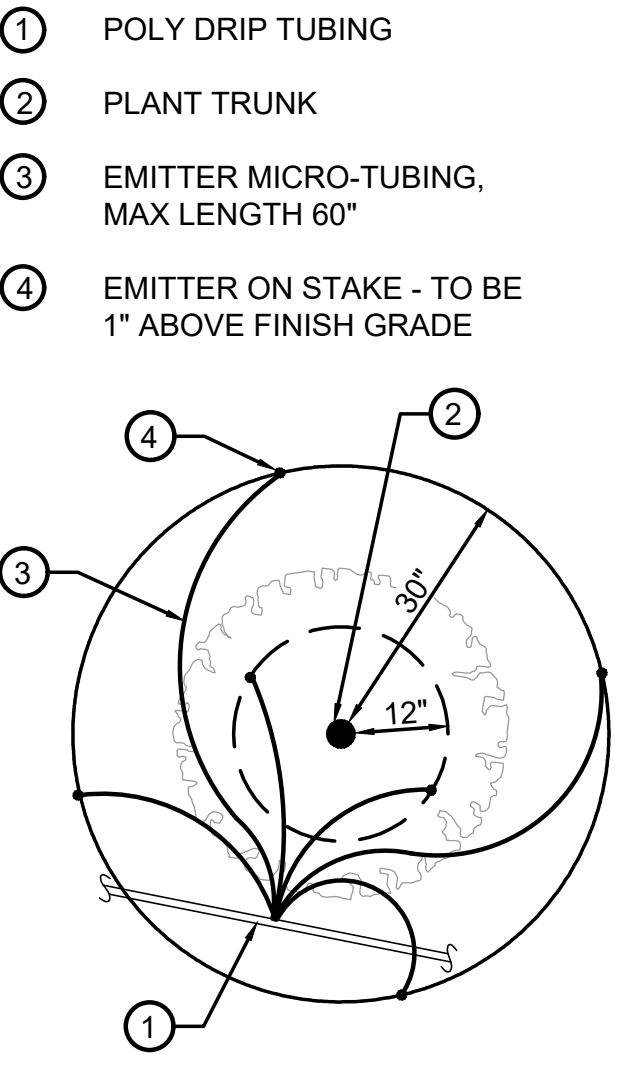

E DRIP EMITTER
SCALE: N.T.S.

PLANT SIZE	EMITTER FLOW RATE	EMITTER QTY. AT MULCHED BED LOCATIONS	EMITTER QTY. AT NATIVE SEED LOCATIONS
1-2 GALLON MATERIAL	0.5 GPH	ONE EACH	ONE EACH
5 GALLON MATERIAL	0.5 GPH	TWO EACH	TWO EACH
1-1/2" CALIPER TREE	1 GPH	THREE EACH	FOUR EACH
2" CALIPER TREE	1 GPH	FOUR EACH	SIX EACH
2-1/2" CALIPER TREE	1 GPH	SIX EACH	EIGHT EACH
3" CALIPER TREE	1 GPH	EIGHT EACH	TEN EACH
3-1/2" CALIPER TREE	1 GPH	NINE EACH	ELEVEN EACH
4" CALIPER TREE	1 GPH	TEN EACH	TWELVE EACH
6 FT. CONIFEROUS TREE	1 GPH	FOUR EACH	SIX EACH
8 FT. CONIFEROUS TREE	1 GPH	SIX EACH	NINE EACH
10 FT. CONIFEROUS TREE	1 GPH	EIGHT EACH	TWELVE EACH
12 FT. CONIFEROUS TREE	1 GPH	TEN EACH	FOURTEEN EACH

SEAL:

8678 CONCORD CENTER DR, UNIT 200
ENGLEWOOD, CO 80112
rickengineering.com
303.537.8020

RICK
ENGINEERING COMPANY

PROJECT NO: 2243
DATE: 9/5/2023

DRAWN/DESIGNED BY: KN/TM
CHECKED BY: KN

SITE PLAN PREPARED FOR:

DOUGLAS 234, FILING NO. 6,
AMENDMENT 1, LOT 4
DOUGLAS COUNTY, COLORADO

LANDSCAPE IRRIGATION & DETAILS




DRAWING NO. 9

2ND SUBMITTAL

SITE PLAN FOR
DUNKIN' DONUTS
DOUGLAS 234, FILING NO. 6,
AMENDMENT 1, LOT 4

A PORTION OF THE SOUTHWEST QUARTER OF THE SOUTHEAST QUARTER OF SECTION 29,
TOWNSHIP 6 SOUTH, RANGE 66 WEST, 6TH PRINCIPAL MERIDIAN,
TOWN OF PARKER, COUNTY OF DOUGLAS, STATE OF COLORADO
0.901 ACRES, 1 COMMERCIAL LOT

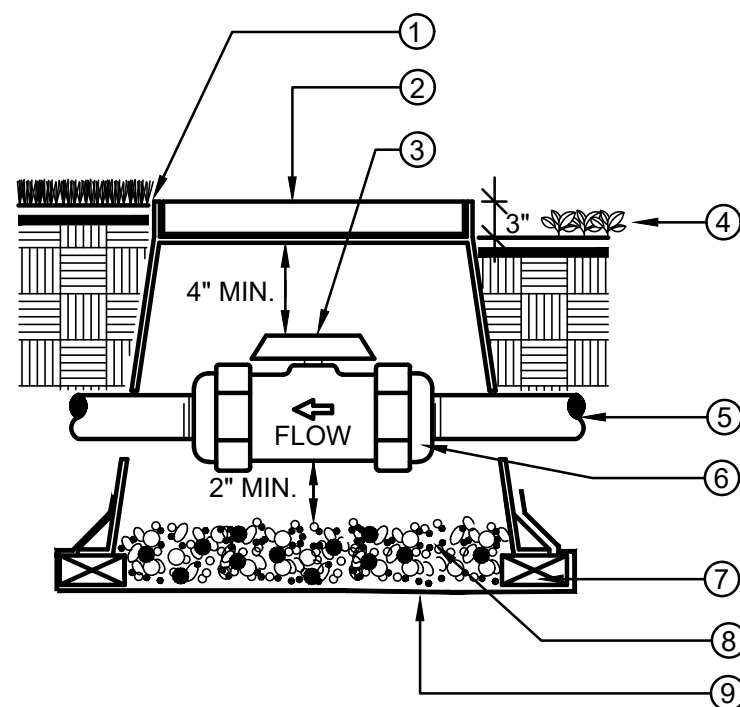


- 1 FINISH GRADE IN TURF AREAS
- 2 PLASTIC RECTANGULAR VALVE BOX WITH BOLT DOWN COVER. USE STAINLESS BOLT, NUT, AND WASHER. BOX TO BE PLACED AT RIGHT ANGLE TO HARDSCAPE EDGE. HEAT BRAND "BV" ONTO LID.
- 3 PVC BALL VALVE. SEE LEGEND FOR SPECIFICATION
- 4 FINISH GRADE IN SHRUB AREAS
- 5 MAINLINE, DEPTH AS PER SPECS.
- 6 DUAL UNION CONNECTIONS AS PART OF BALL VALVE, THREADED IF SPECIFIED IN LEGEND
- 7 (4) BRICK SUPPORTS
- 8 3/4" ROCK, 2 CUBIC FT.
- 9 LANDSCAPE FABRIC

NOTE:
BOX TO BE INSTALLED TO ALLOW FOR PROPER OPERATION OF BALL VALVE HANDLE. INSTALL AT RIGHT ANGLE TO HARDSCAPE EDGE.

INSTALL VALVE BOX EXTENSIONS AS REQUIRED TO ACHIEVE PROPER VALVE INSTALLATION AT MAINLINE DEPTH.

ALL THREADED CONNECTIONS SHALL HAVE TEFLON TAPE OR PASTE.


A BALL VALVE, TRU-ION
SCALE: N.T.S.

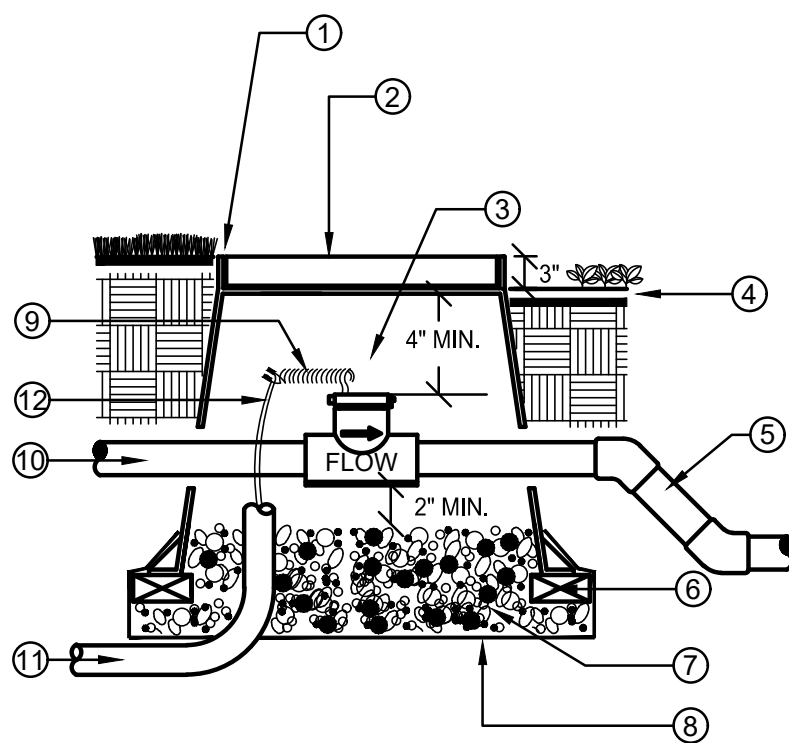

- 1 FLUSH W/ FINISH GRADE IN TURF AREAS TYP.
- 2 CONCRETE RECTANGULAR VALVE BOX WITH CAST IRON LOCKING LID. BOX TO BE PLACED AT RIGHT ANGLE TO HARDSCAPE EDGE. PAINT "FS" ONTO LID.
- 3 FLOW SENSOR. SEE LEGEND FOR SPECIFICATION
- 4 FINISH GRADE IN SHRUB MULCH AREAS
- 5 PVC MAINLINE TO SYSTEM, PIPE PER SPECIFICATION
- 6 (4) BRICK SUPPORTS
- 7 3/4" ROCK, 2 CUBIC FEET
- 8 LANDSCAPE FABRIC
- 9 24" WIRE LOOP
- 10 PVC MAINLINE FROM MASTER VALVE
- 11 1" ELECTRICAL CONDUIT TO CONTROLLER
- 12 SHIELDED CABLE


NOTE:
NO FITTINGS 10x PIPE O.D. UPSTREAM OF SENSOR, NO FITTINGS 5x PIPE O.D. DOWNSTREAM OF SENSOR.
INSTALL FLOW SENSOR PER THE MANUFACTURER'S RECOMMENDATIONS. ROUTE WIRES THROUGH CONDUIT TO IRRIGATION CONTROLLER.
USE 45 DEGREE ELLS TO ACHIEVE MAINLINE DEPTH ON THE DOWNSTREAM SIDE OF THE FLOW SENSOR.

B FLOW SENSOR
SCALE: N.T.S.

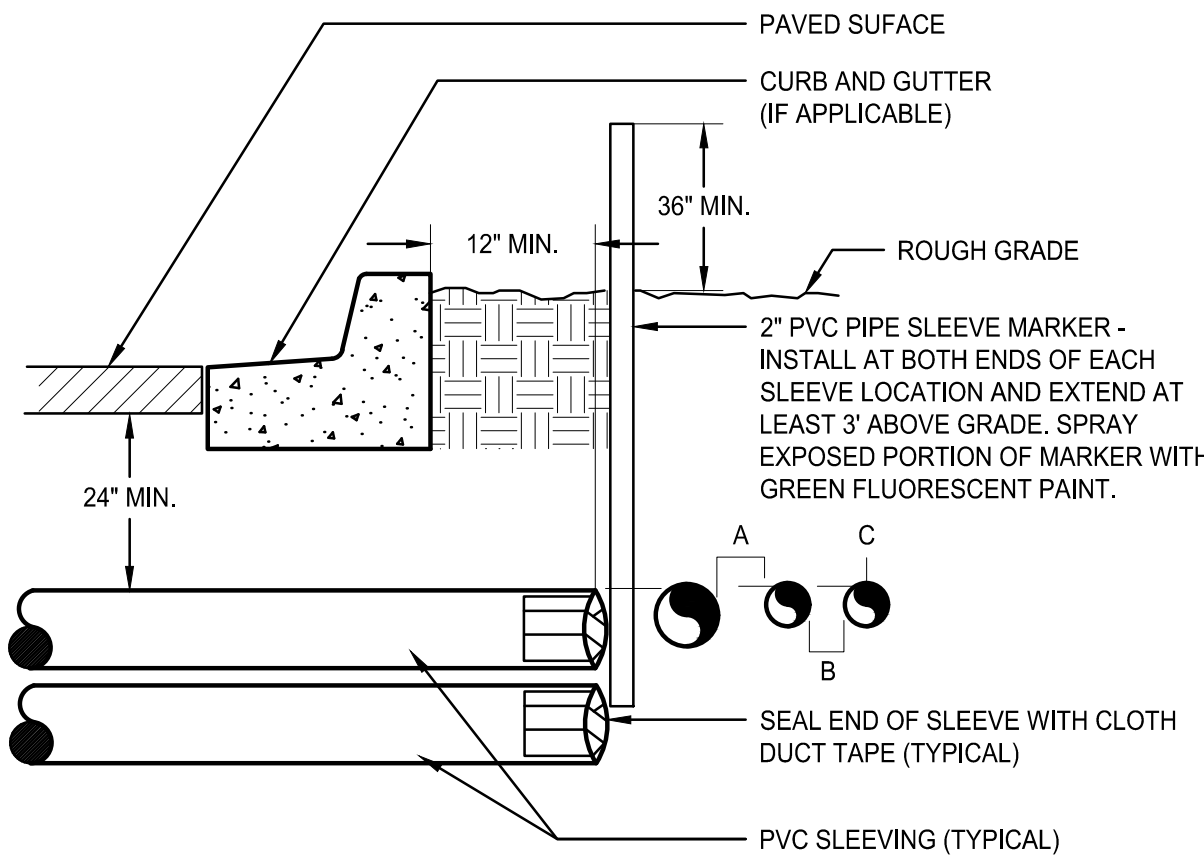

- NOTE:
- ALL SLEEVE MATERIAL PER IRRIGATION SCHEDULE. SIZE AS NOTED ON PLAN.
 - INSTALL SLEEVES IN SIDE-BY-SIDE CONFIGURATION WHERE MULTIPLE SLEEVES ARE TO BE INSTALLED. SPACE SLEEVES 4" TO 6" APART. DO NOT STACK SLEEVES VERTICALLY.
 - CONTRACTOR TO COORDINATE WITH FLATWORK INSTALLER TO BRAND A "V" IN SIDEWALK OR CURB AT BOTH ENDS OF SLEEVE CROSSING.


C IRRIGATION SLEEVING
SCALE: N.T.S.

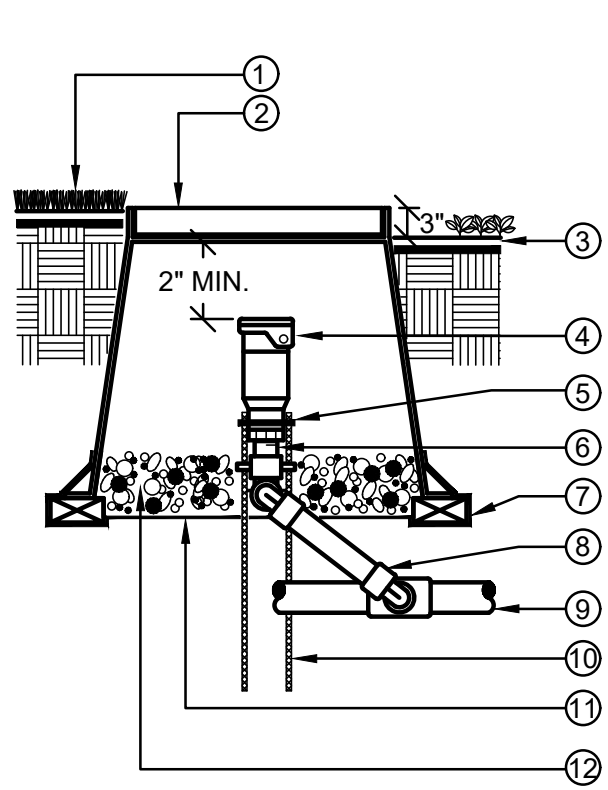

- 1 FINISH GRADE IN TURF AREAS
- 2 PLASTIC ROUND VALVE BOX WITH BOLT DOWN COVER, USE STAINLESS BOLT NUT AND WASHER. HEAT BRAND "QCV" ONTO LID.
- 3 FINISH GRADE IN SHRUB AREAS
- 4 QUICK COUPLER VALVE WITH ACME THREAD. SEE LEGEND FOR SPEC.
- 5 STAINLESS STEEL CLAMP
- 6 BRASS NIPPLE (LENGTH AS REQUIRED)
- 7 (4) BRICK SUPPORTS
- 8 SCH. 80 TRIPLE SWING JOINT ASSEMBLY WITH DOUBLE O-RING SEAL
- 9 MAINLINE, SEE SPECS.
- 10 #4 x 36" REBAR STAKES, (1 of 2)
- 11 LANDSCAPE FABRIC
- 12 3/4" ROCK, 1 CUBIC FT.


NOTE:
ALL THREADED CONNECTIONS TO HAVE TEFLON TAPE OR PASTE.
QUICK COUPLER VALVE KEY MUST SWIVEL FREELY WHEN INSERTED INTO LUG TRACK.

D QUICK COUPLER VALVE
SCALE: N.T.S.

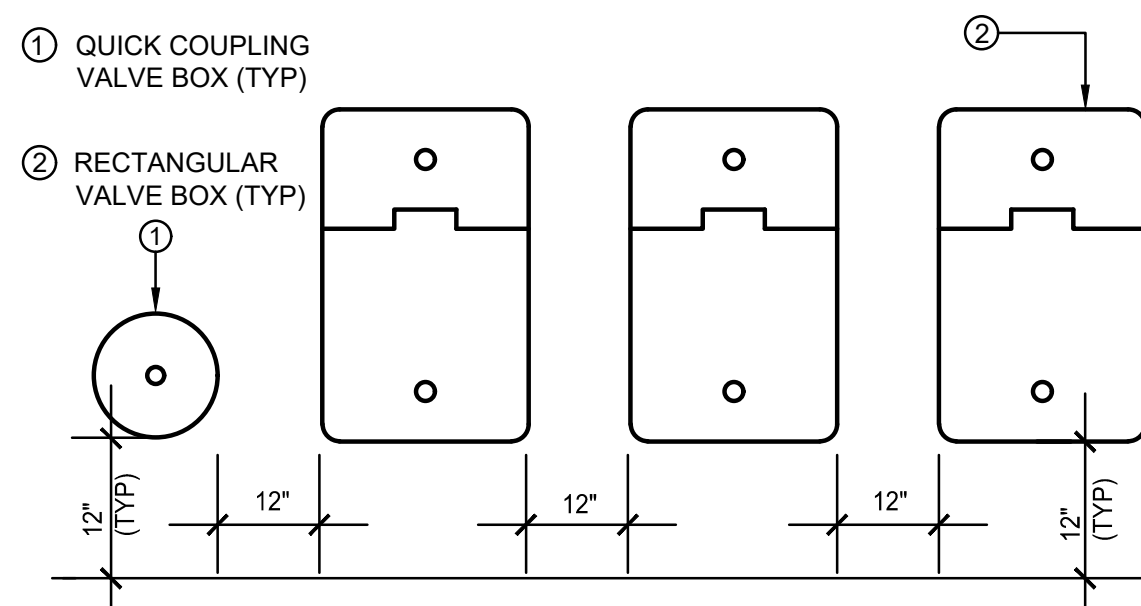


- NOTES:
- VALVE BOXES SHALL BE LABELED BY HOT IRON BRANDING OR ALUMINUM ASPHALT BASED WATERPROOF PAINT.
 - CONTROL VALVES SHALL BE INSTALLED TO ALLOW ORDERLY ARRANGEMENT OF VALVE BOXES.
 - LOCATE VALVE ASSEMBLIES IN SHRUB OR GROUND COVER AREAS WHEN POSSIBLE.
 - LOCATION OF VALVE ASSEMBLIES SHALL BE STAKED FOR APPROVAL BY LANDSCAPE ARCHITECT PRIOR TO INSTALLATION.
 - CENTER VALVE BOXES OVER VALVE ASSEMBLY TO FACILITATE ACCESS AND MAINTENANCE.
 - SET VALVE BOXES AT EQUAL ELEVATIONS WITH TOPS AT FINISH GRADE IN TURF AREAS OR 3" ABOVE FINISH GRADE IN SHRUB/GROUND COVER AREAS.
 - VALVE BOXES SHALL BE SET PARALLEL TO EACH OTHER AND PERPENDICULAR TO EDGE OF AREA.
 - DO NOT DEFORM OR COLLAPSE VALVE BOX BY EXCESSIVE SOIL COMPACTING AROUND BOX.
 - ON RECYCLED SYSTEMS ALL VALVE BOXES AND QUICK COUPLER VALVES SHALL BE CLEARLY COLORED PURPLE.

E VALVE BOX LAYOUT
SCALE: N.T.S.

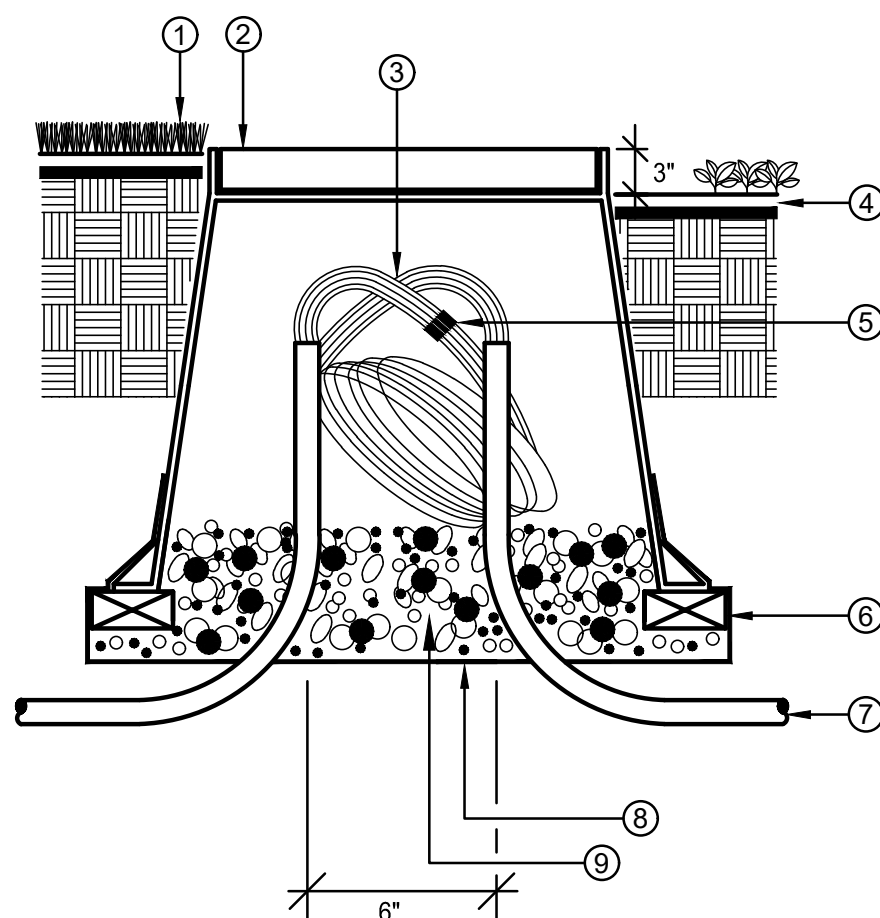


- 1 FINISHED GRADE IN TURF AREAS
- 2 10" ROUND PLASTIC VALVE BOX WITH BOLT DOWN COVER, USE STAINLESS BOLT, NUT, AND WASHER. HEAT BRAND "PB" ONTO LID.
- 3 24" WIRE EXPANSION LOOP (TYP).
- 4 FINISH GRADE IN SHRUB AREAS
- 5 WATER PROOF WIRE CONNECTORS
- 6 (4) BRICK SUPPORTS
- 7 PVC ELECTRICAL SWEEP (IF INSTALLED IN CONDUIT)
- 8 LANDSCAPE FABRIC
- 9 3/4" ROCK, 1 CUBIC FT.

F ROUND PULL BOX
SCALE: N.T.S.

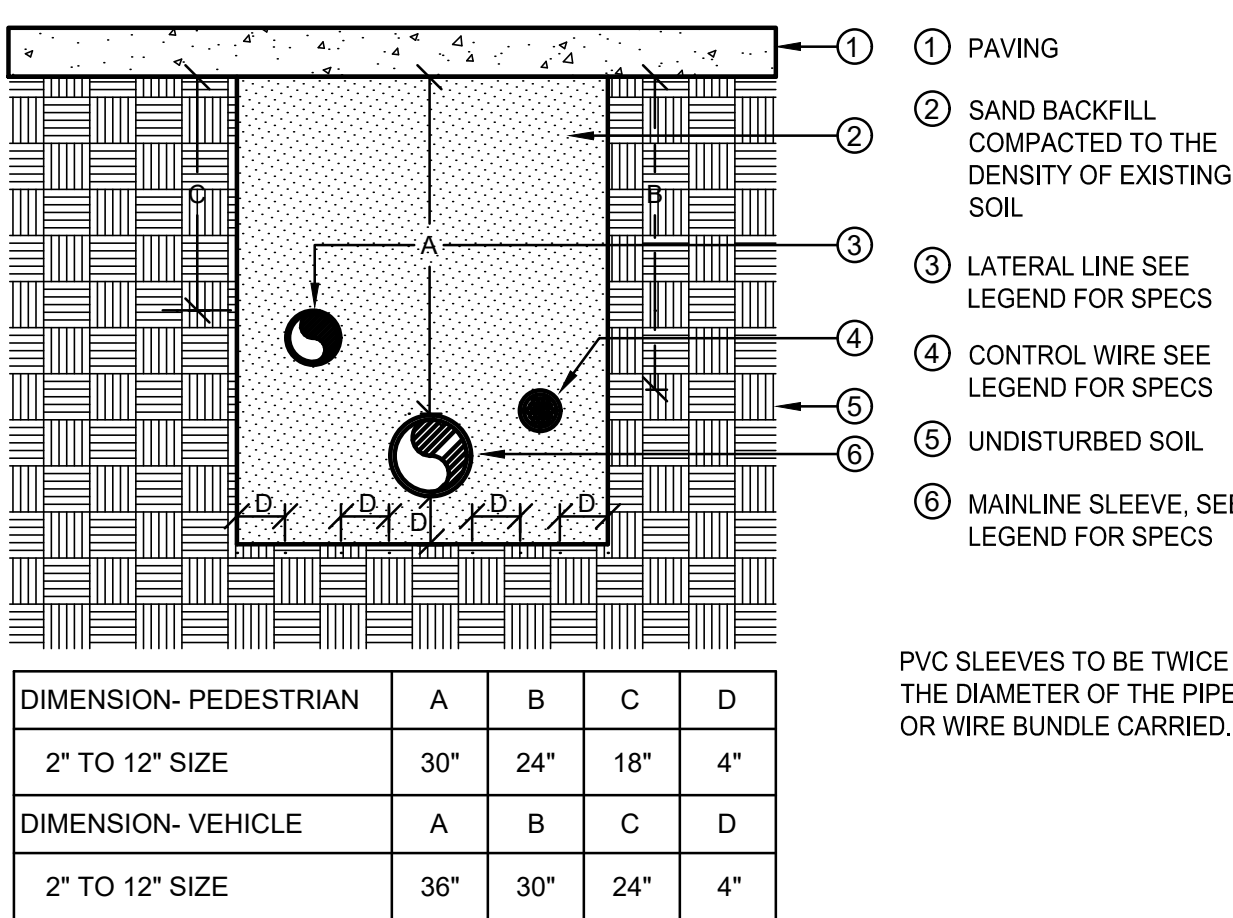


PVC SLEEVES TO BE TWICE THE DIAMETER OF THE PIPE OR WIRE BUNDLE CARRIED.

G SLEEVE INSTALLATION
SCALE: N.T.S.

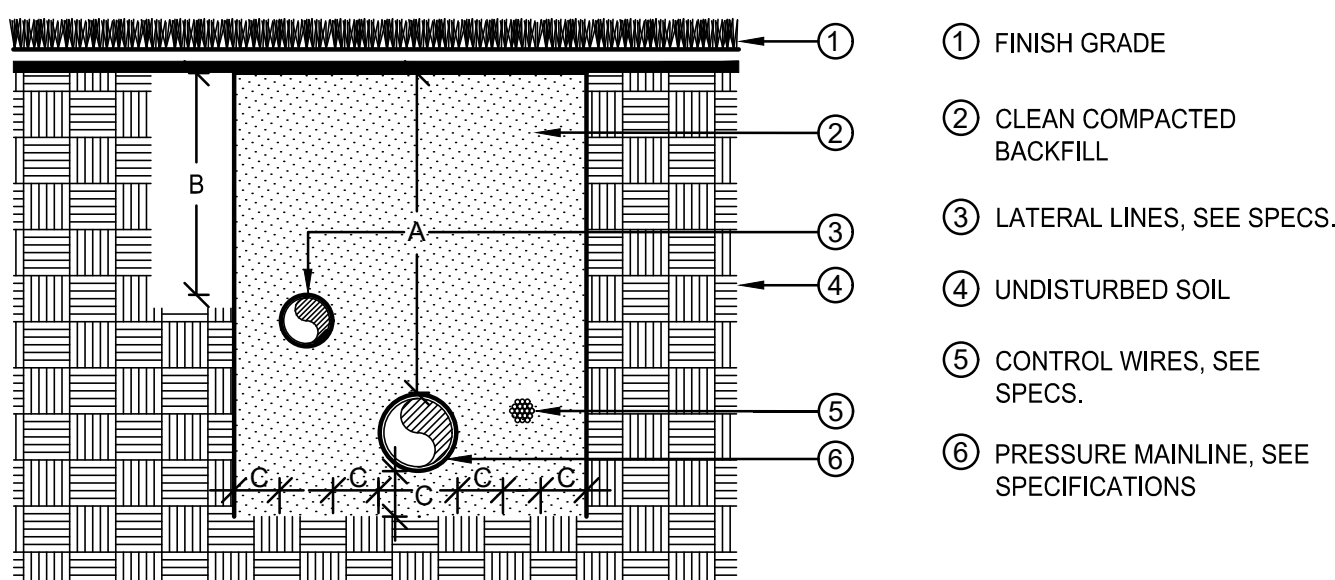

DIMENSION	A	B	C
1/2" TO 2-1/2" IN SIZE	24"	18"	4"
3" IN SIZE	24"		4"
4" AND LARGER	36"		4"

H PIPE INSTALLATION
SCALE: N.T.S.

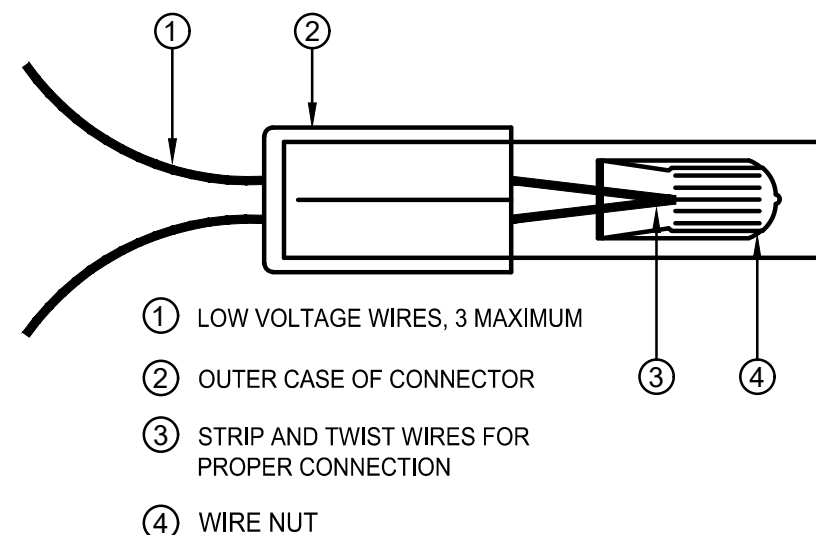

NOTE:
INSPECT, TEST, AND VERIFY PROPER SYSTEM CONNECTION BEFORE INSERTION INTO SEALANT CARTRIDGE. DO NOT REUSE SEALANT CARTRIDGES.

I WIRE CONNECTIONS
SCALE: N.T.S.

SEAL:

8678 CONCORD CENTER DR, UNIT 200
ENGLEWOOD, CO 80112
303.537.8020
rickengineering.com

RICK
ENGINEERING COMPANY

San Diego - Riverside - Sacramento - Orange - Tucson - Phoenix - Las Vegas - Denver

PROJECT NO: 2243
DATE: 9/5/2023
DRAWN/DESIGNED BY: KN/TM
CHECKED BY: KN

SITE PLAN PREPARED FOR:

DOUGLAS 234, FILING NO. 6,
AMENDMENT 1, LOT 4
DOUGLAS COUNTY, COLORADO


LANDSCAPE IRRIGATION & DETAILS



DRAWING NO.
10

2ND SUBMITTAL


A PORTION OF THE SOUTHWEST QUARTER OF THE SOUTHEAST QUARTER OF SECTION 29,
TOWNSHIP 6 SOUTH, RANGE 66 WEST, 6TH PRINCIPAL MERIDIAN,
TOWN OF PARKER, COUNTY OF DOUGLAS, STATE OF COLORADO
0.901 ACRES, 1 COMMERCIAL LOT

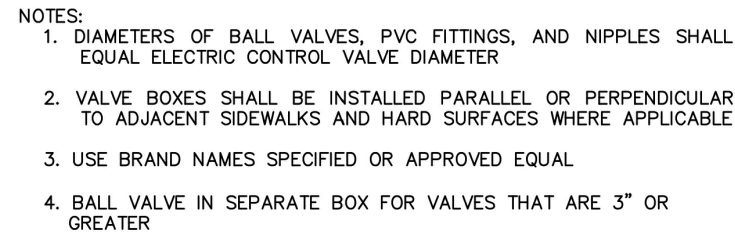

- ① INSTALL SPRINKLER HEAD
FLUSH WITH FINISH
GRADE IN TURF AREAS
- ② POP-UP SPRINKLER HEAD,
SPRAY OR ROTOR SEE
LEGEND FOR
SPECIFICATION
- ③ INSTALL SPRINKLER HEAD
1/2" BELOW FINISH GRADE
IN SHRUB AND X
COVERS AREAS
- ④ UNDISTURBED SOIL
- ⑤ TRIPLE SWING JOINT
ASSEMBLY
- ⑥ SCH 40 PVC 6x6xT FEE
TING LATERAL X
SPRINKLER INLET SIZE
- ⑦ LATERAL LINE, SEE
SPECIFICATIONS FOR TYPE
AND DEPTH REQUIRED

WHERE INSTALLED AT TREES, INSTALL BUBBLERS 3' FROM TRUNK TO ENSURE PROPER WATERING AS TREE GROWS

C DRIP CONTROL ZONE KIT
SCALE: N.T.S.

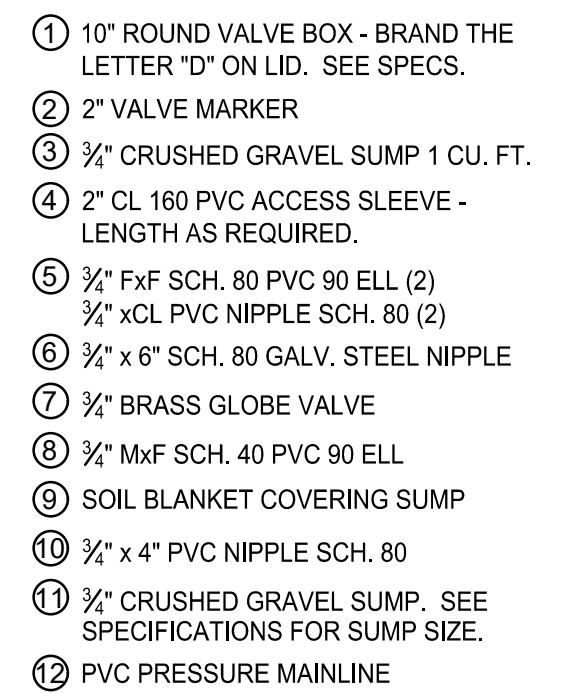

NOTE: APPLY TEFLON TAPE TO ALL MALE
THREADED PVC FITTINGS AND ALL NIPPLES.

SITE PLAN PREPARED FOR:

**DOUGLAS 234, FILING NO. 6,
AMENDMENT 1, LOT 4**

DOUGLAS COUNTY, COLORADO

LANDSCAPE IRRIGATION & DETAILS



DRAWING NO.

11

2ND SUBMITTAL

SEAL:

SEAL:

8678 CONCORD CENTER DR, UNIT 200
ENGLEWOOD, CO 80112
303.537.8020

rickengineering.com

KN/TM



2243	DRAWN/DESIGNED BY:
------	--------------------

PROJECT NO:

**DOUGLAS 234, FILING NO. 6,
AMENDMENT 1, LOT 4**

NOTES:

THIS PLAN IS FOR RELATIVE LAYOUT AND SCOPE OF WORK PURPOSES ONLY. REFER TO SITE PLAN PREPARED BY LOCAL CONSULTANT FOR RELATIONSHIP OF THESE LUMINAIRES AND THEIR LOCATIONS TO EXISTING STRUCTURES AND REFERENCE.

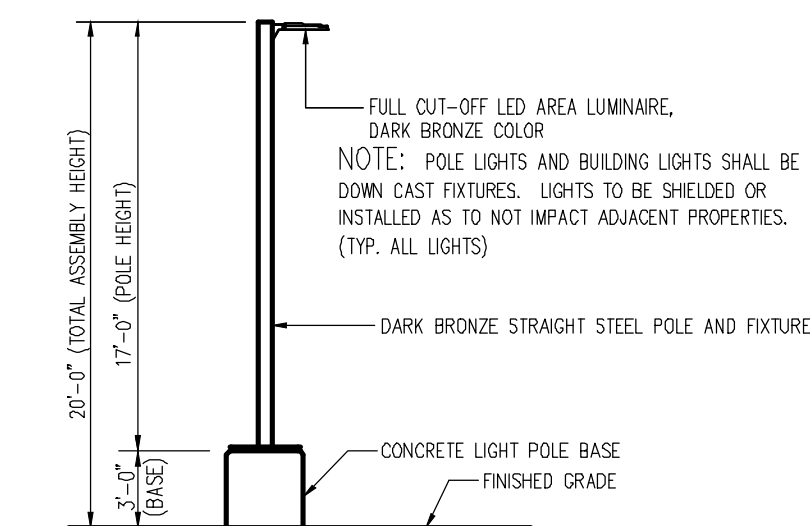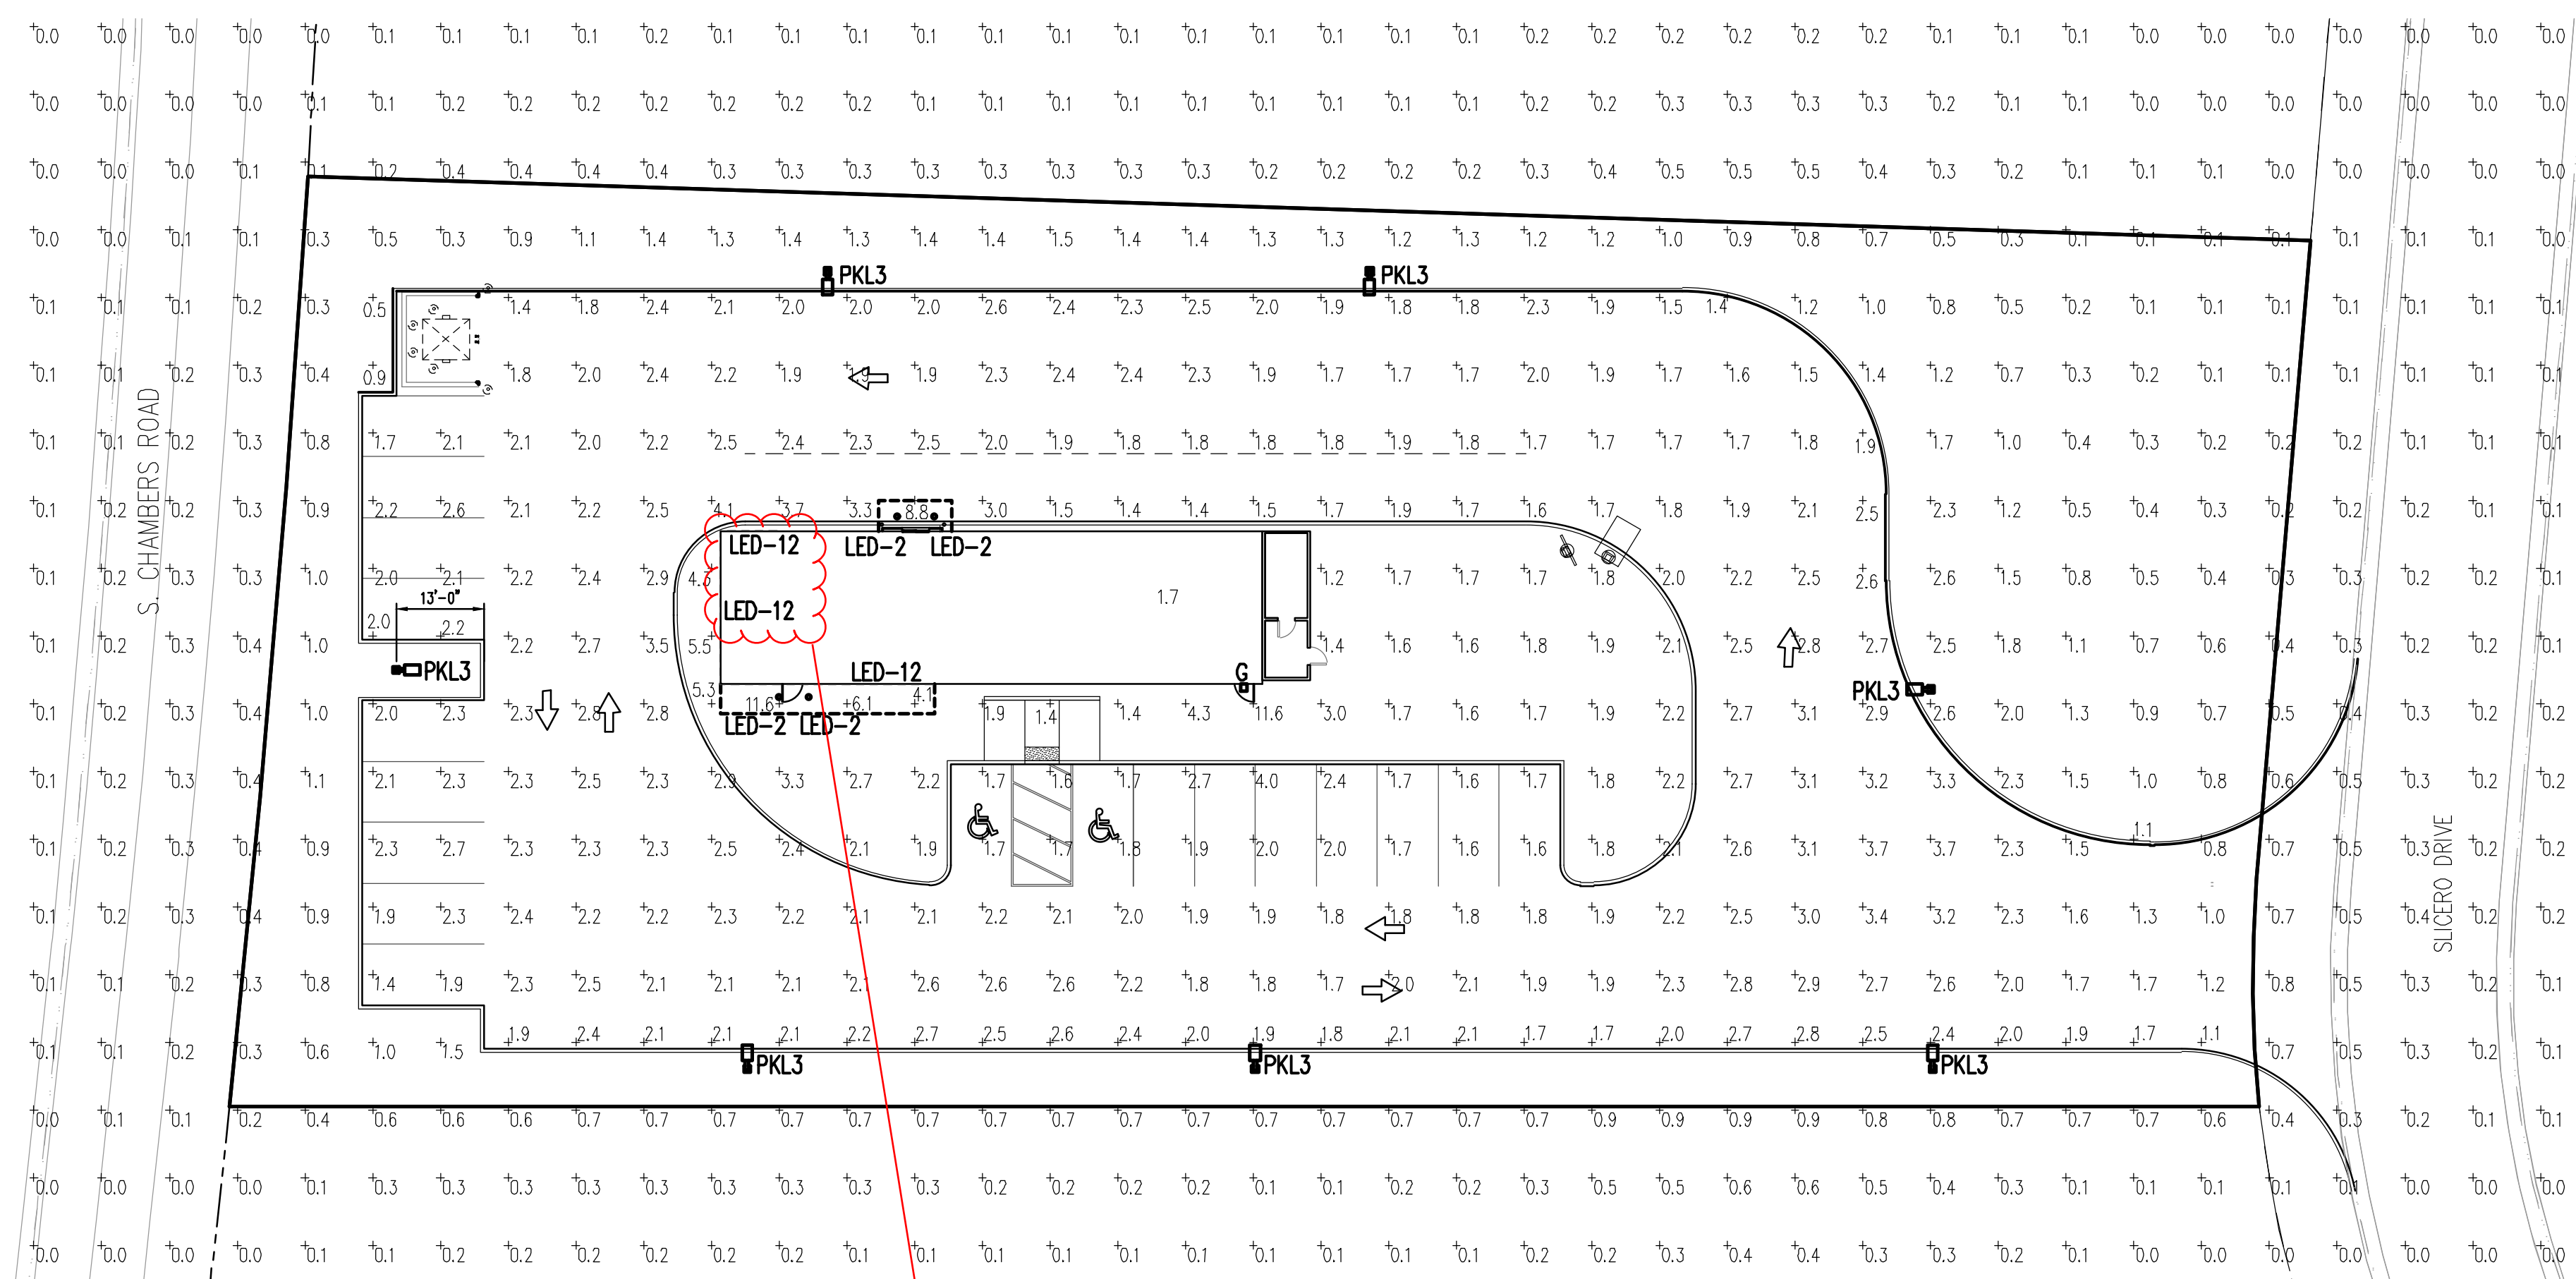

2 AREA LIGHT DETAIL
SCALE: NOT TO SCALE

1 PHOTOMETRIC SITE PLAN
SCALE: 1"=20'-0"

CALCULATION SUMMARY						
LABEL	UNITS	AVG	MAX	MIN	AVG/MIN	MAX/MIN
ILLUMINATED AREAS	FC	2.38	11.6	1.4	1.70:1	8.29:1

LUMINAIRE SCHEDULE									
MARK	SYMBOL	QTY	LAMP	HEIGHT	LLF	LUMENS	WATT	MODEL #	DESCRIPTION
PKL3		7	LED	20'-0" POLE	1.0	11,933	96	PRV-C25-0-UNV-74-SA-SB-HSS	COOPER LIGHTING, PREVAL SITE LUMINAIRE, C25 LIGHT ENGINE, 4000K, TYPE VI DISTRIBUTION, STANDARD ARM, BRONZE COLOR WITH REAR SHIELD
LED-2		1	LED	9'-0" WALL	1.0	2,135	118.2	X102XB	COOPER LIGHTING, CROSSROUT WALL LUMINAIRE, 18 WATTS, 5000K, BRONZE COLOR
LED-3		4	LED	10'-8" RECESSED	1.0	814	118.8	DRH-D-4/DRD2M-10-9-40/DRD21R-4-5-W	ATTAINED/DMF LIGHTING, 4" ROUND CANOPY DOWNLIGHT, 4000K, WHITE FINISH
LED-4		1	LED	10'-0" RECESSED	1.0	308 / 18	17.7	D-120V-IPR3C-35-LENGTH-NITCH	DICOD LED 120V LED STRIP LIGHT, 3500K, RECESSED MOUNTED IN CHANNEL UNDERNEATH STEEL CHANNEL, TOTAL LENGTH TO BE DETERMINED

CONTRACTOR TO VERIFY ALL EQUIPMENT WITH OWNER AND ARCHITECT BEFORE PROCEEDING

FIXTURES PKL3 MOUNTED ON 17'-0" POLE ON 3'-0" CONCRETE BASE, TOTAL ASSEMBLY HEIGHT 20'-0"

1. ALL UTILITY LOCATIONS SHOWN ARE BASED ON MAPS PROVIDED BY THE APPROPRIATE UTILITY COMPANY AND FIELD SURFACE EVIDENCE AT THE TIME OF SURVEY AND IS TO BE CONSIDERED AN APPROXIMATE LOCATION ONLY. IT IS THE CONTRACTOR'S RESPONSIBILITY TO FIELD VERIFY THE LOCATION OF ALL UTILITIES, PUBLIC OR PRIVATE, WHETHER SHOWN ON THE PLANS OR NOT, PRIOR TO CONSTRUCTION. REPORT ANY DISCREPANCIES TO THE ENGINEER PRIOR TO CONSTRUCTION.
2. WHERE A PROPOSED UTILITY CROSSES AN EXISTING UTILITY, IT IS THE CONTRACTOR'S RESPONSIBILITY TO FIELD VERIFY THE HORIZONTAL AND VERTICAL LOCATION OF SUCH EXISTING UTILITY THROUGHOUT THE PROJECT. FOR AN ALTERNATIVE METHOD, REPORT INFORMATION TO THE ENGINEER PRIOR TO CONSTRUCTION.



SITE PLAN DOCUMENTS
DOUGLAS 234, FILING NO. 6,
AMENDMENT 1, LOT 4
QUALITY BRAND GROUP CO, LLC

CHAMBERS & HESS
PARKER, CO

[illegible]

Project No:	QBG02
Drawn By:	JG
Checked By:	JG
Date:	August 25, 2023

PHOTOMETRIC PLAN

12

© 2024 dmf Lighting, Inc. All rights reserved. DMF Lighting, Inc. is a registered trademark of dmf Lighting, Inc. DMF Lighting, Inc. is a registered trademark of dmf Lighting, Inc. DMF Lighting, Inc. is a registered trademark of dmf Lighting, Inc.

Product Code:	Type:
Project:	Date:

dmf Lighting® 1118 E. 223rd St. Carson, CA 90745 T: 1.800.441.4422
© 2019 DMF Lighting. All Rights Reserved. Specifications subject to change without notice.

Trim
CONSTRUCTION: Die-cast aluminum. Twist & Lock mounting allows easy field installation and tight ceiling fit.

PHOTOMETRIC TESTING: Tested in accordance to IESNA LM-79-2008. LISTINGS: IC rated. eULus Listed. ENERGY STAR® qualified. Title 24 compliant. ASTM E283 certified Air Tight. UL Listed for Wet Location. CEC listed.

WARRANTY: 5 year limited warranty.

Light Engine
LED: Tightly binned, high performing white Cree® LEDs enable excellent fixture to fixture color consistency and long lifetime. Delivers 93+ CRI in all available color temperatures.

BINNING: Color variation within 2-step MacAdam ellipses.

CONNECTOR: IDEAL PowerPlug® Luminaire Disconnect, female. Alternate module construction with 0-10V, EcoSystem® dimming and/or Emergency Battery Backup Unit uses a IDEAL PowerPlug® Model 102 connector.

DRIVER: Integral electronic driver for 120/277V 50/60Hz operation. Electronic driver compatible with forward and reverse phase-control dimming at 120V only.

SYSTEM POWER CONSUMPTION: 11.8W (750 lm module), 14.7W (1000 lm module).

DIMMING: TRIAC/ELV dimming standard for 120V only, with flicker-free dimming to less than 5% of total lumen output. Optional 0-10V or EcoSystem® dimming available for 120/277V.

Frame-in Kit
HOUSING: 18 ga. die-formed aluminum box fastened to 22 ga. steel mounting frame (4" frame-in kit, 4" shallow frame-in kit, 20 ga. die-formed aluminum (6" frame-in kit), 22 ga. die-formed aluminum (6" frame-in kit), 20 ga. die-formed aluminum (6" shallow frame-in kit).

JUNCTION BOX: Galvanized steel. Equipped with (6) 1/2" and (1) 3/4" knockouts with pre-punch slots to allow straight conduit runs. (4) knockouts for non-metallic sheathed cable installation. Junction box tension springs allow snap-in installation of plate cover for easy access to wiring. Approved for 8 (four-in, four-out) #12 AWG 90 through wire conductors.


MOUNTING: Pre-installed adjustable bar hangers engineered to accommodate lumbar, laminated beams and T-bar.

CEILING: "N" up to 1".
CUTOUT: 4 3/4" (4" frame-in kit, 4" shallow frame-in kit, 5 1/2" 6" frame-in kit), 6 1/2" (6" frame-in kit, 6" shallow frame-in kit).

Type LED-2 DRD2

Recessed LED Downlight
General New Construction
4", 5", 6" Aperture

PRODUCT SPECIFICATIONS

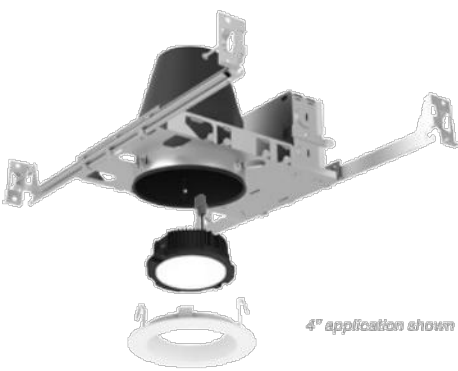

- Maximum installation compatibility
- Twist & Lock feature for easy trim installation
- 750 & 1000 lumen outputs
- 2700K, 3000K, 3500K, 4000K CCT
- Flicker-free TRIAC/ELV, 0-10V, or EcoSystem® dimming
- 50,000 hr lifetime at 70% lumen maintenance
- 5 year limited warranty

Product Code:	Type:
Project:	Date:

dmf Lighting® 1118 E. 223rd St. Carson, CA 90745 T: 1.800.441.4422
© 2019 DMF Lighting. All Rights Reserved. Specifications subject to change without notice.

Trim
CONSTRUCTION: Die-cast aluminum. Twist & Lock mounting allows easy field installation and tight ceiling fit.

PHOTOMETRIC TESTING: Tested in accordance to IESNA LM-79-2008. LISTINGS: IC rated. eULus Listed. ENERGY STAR® qualified. Title 24 compliant. ASTM E283 certified Air Tight. UL Listed for Wet Location. CEC listed.

WARRANTY: 5 year limited warranty.

Light Engine
LED: Tightly binned, high performing white Cree® LEDs enable excellent fixture to fixture color consistency and long lifetime. Delivers 93+ CRI in all available color temperatures.

BINNING: Color variation within 2-step MacAdam ellipses.

CONNECTOR: IDEAL PowerPlug® Luminaire Disconnect, female. Alternate module construction with 0-10V, EcoSystem® dimming and/or Emergency Battery Backup Unit uses a IDEAL PowerPlug® Model 102 connector.

DRIVER: Integral electronic driver for 120/277V 50/60Hz operation. Electronic driver compatible with forward and reverse phase-control dimming at 120V only.


SYSTEM POWER CONSUMPTION: 11.8W (750 lm module), 14.7W (1000 lm module).

DIMMING: TRIAC/ELV dimming standard for 120V only, with flicker-free dimming to less than 5% of total lumen output. Optional 0-10V or EcoSystem® dimming available for 120/277V.

Type LED-2 DRD2

Recessed LED Downlight
General New Construction
4", 5", 6" Aperture

PRODUCT SPECIFICATIONS

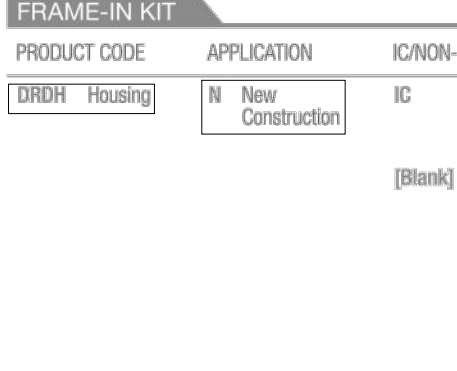

- Maximum installation compatibility
- Twist & Lock feature for easy trim installation
- 750 & 1000 lumen outputs
- 2700K, 3000K, 3500K, 4000K CCT
- Flicker-free TRIAC/ELV, 0-10V, or EcoSystem® dimming
- 50,000 hr lifetime at 70% lumen maintenance
- 5 year limited warranty

Product Code:	Type:
Project:	Date:

dmf Lighting® 1118 E. 223rd St. Carson, CA 90745 T: 1.800.441.4422
© 2019 DMF Lighting. All Rights Reserved. Specifications subject to change without notice.

Trim
CONSTRUCTION: Die-cast aluminum. Twist & Lock mounting allows easy field installation and tight ceiling fit.

PHOTOMETRIC TESTING: Tested in accordance to IESNA LM-79-2008. LISTINGS: IC rated. eULus Listed. ENERGY STAR® qualified. Title 24 compliant. ASTM E283 certified Air Tight. UL Listed for Wet Location. CEC listed.

WARRANTY: 5 year limited warranty.

Light Engine
LED: Tightly binned, high performing white Cree® LEDs enable excellent fixture to fixture color consistency and long lifetime. Delivers 93+ CRI in all available color temperatures.

BINNING: Color variation within 2-step MacAdam ellipses.

CONNECTOR: IDEAL PowerPlug® Luminaire Disconnect, female. Alternate module construction with 0-10V, EcoSystem® dimming and/or Emergency Battery Backup Unit uses a IDEAL PowerPlug® Model 102 connector.

DRIVER: Integral electronic driver for 120/277V 50/60Hz operation. Electronic driver compatible with forward and reverse phase-control dimming at 120V only.


SYSTEM POWER CONSUMPTION: 11.8W (750 lm module), 14.7W (1000 lm module).

DIMMING: TRIAC/ELV dimming standard for 120V only, with flicker-free dimming to less than 5% of total lumen output. Optional 0-10V or EcoSystem® dimming available for 120/277V.

Type LED-12

Recessed LED Downlight
General New Construction
4", 5", 6" Aperture

PRODUCT SPECIFICATIONS

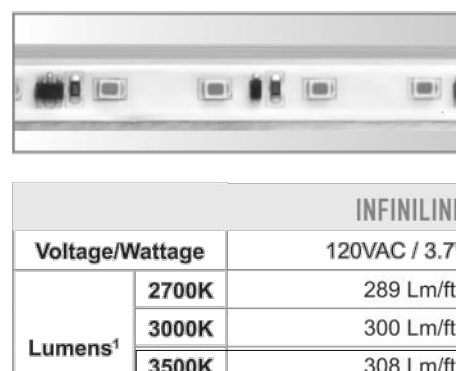

- Maximum installation compatibility
- Twist & Lock feature for easy trim installation
- 750 & 1000 lumen outputs
- 2700K, 3000K, 3500K, 4000K CCT
- Flicker-free TRIAC/ELV, 0-10V, or EcoSystem® dimming
- 50,000 hr lifetime at 70% lumen maintenance
- 5 year limited warranty

Product Code:	Type:
Project:	Date:

dmf Lighting® 1118 E. 223rd St. Carson, CA 90745 T: 1.800.441.4422
© 2019 DMF Lighting. All Rights Reserved. Specifications subject to change without notice.

Trim
CONSTRUCTION: Die-cast aluminum. Twist & Lock mounting allows easy field installation and tight ceiling fit.

PHOTOMETRIC TESTING: Tested in accordance to IESNA LM-79-2008. LISTINGS: IC rated. eULus Listed. ENERGY STAR® qualified. Title 24 compliant. ASTM E283 certified Air Tight. UL Listed for Wet Location. CEC listed.

WARRANTY: 5 year limited warranty.

Light Engine
LED: Tightly binned, high performing white Cree® LEDs enable excellent fixture to fixture color consistency and long lifetime. Delivers 93+ CRI in all available color temperatures.

BINNING: Color variation within 2-step MacAdam ellipses.

CONNECTOR: IDEAL PowerPlug® Luminaire Disconnect, female. Alternate module construction with 0-10V, EcoSystem® dimming and/or Emergency Battery Backup Unit uses a IDEAL PowerPlug® Model 102 connector.

DRIVER: Integral electronic driver for 120/277V 50/60Hz operation. Electronic driver compatible with forward and reverse phase-control dimming at 120V only.


SYSTEM POWER CONSUMPTION: 11.8W (750 lm module), 14.7W (1000 lm module).

DIMMING: TRIAC/ELV dimming standard for 120V only, with flicker-free dimming to less than 5% of total lumen output. Optional 0-10V or EcoSystem® dimming available for 120/277V.

Type LED-12

Recessed LED Downlight
General New Construction
4", 5", 6" Aperture

PRODUCT SPECIFICATIONS

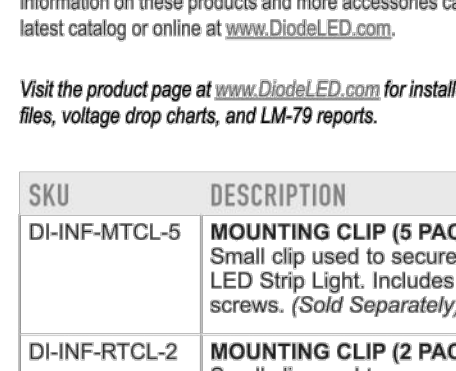

- Maximum installation compatibility
- Twist & Lock feature for easy trim installation
- 750 & 1000 lumen outputs
- 2700K, 3000K, 3500K, 4000K CCT
- Flicker-free TRIAC/ELV, 0-10V, or EcoSystem® dimming
- 50,000 hr lifetime at 70% lumen maintenance
- 5 year limited warranty

Product Code:	Type:
Project:	Date:

dmf Lighting® 1118 E. 223rd St. Carson, CA 90745 T: 1.800.441.4422
© 2019 DMF Lighting. All Rights Reserved. Specifications subject to change without notice.

Trim
CONSTRUCTION: Die-cast aluminum. Twist & Lock mounting allows easy field installation and tight ceiling fit.

PHOTOMETRIC TESTING: Tested in accordance to IESNA LM-79-2008. LISTINGS: IC rated. eULus Listed. ENERGY STAR® qualified. Title 24 compliant. ASTM E283 certified Air Tight. UL Listed for Wet Location. CEC listed.

WARRANTY: 5 year limited warranty.

Light Engine
LED: Tightly binned, high performing white Cree® LEDs enable excellent fixture to fixture color consistency and long lifetime. Delivers 93+ CRI in all available color temperatures.

BINNING: Color variation within 2-step MacAdam ellipses.

CONNECTOR: IDEAL PowerPlug® Luminaire Disconnect, female. Alternate module construction with 0-10V, EcoSystem® dimming and/or Emergency Battery Backup Unit uses a IDEAL PowerPlug® Model 102 connector.

DRIVER: Integral electronic driver for 120/277V 50/60Hz operation. Electronic driver compatible with forward and reverse phase-control dimming at 120V only.


SYSTEM POWER CONSUMPTION: 11.8W (750 lm module), 14.7W (1000 lm module).

DIMMING: TRIAC/ELV dimming standard for 120V only, with flicker-free dimming to less than 5% of total lumen output. Optional 0-10V or EcoSystem® dimming available for 120/277V.

Type LED-12

Recessed LED Downlight
General New Construction
4", 5", 6" Aperture

PRODUCT SPECIFICATIONS

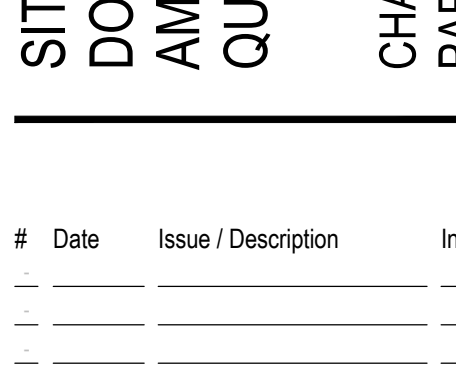

- Maximum installation compatibility
- Twist & Lock feature for easy trim installation
- 750 & 1000 lumen outputs
- 2700K, 3000K, 3500K, 4000K CCT
- Flicker-free TRIAC/ELV, 0-10V, or EcoSystem® dimming
- 50,000 hr lifetime at 70% lumen maintenance
- 5 year limited warranty

Project

Catalog #

Type

PKL3

Prepared by

Notes

Date

Lumark Prevail LED

Area / Site Luminaire

Product Features

- Interactive Menu
 - Ordering Information page 2
 - Mounting Details page 3, 4
 - Optical Configurations page 1
 - Product Specifications page 1
 - Energy and Performance Data page 1, 7
 - Control Options page 6
- Quick Facts
 - Lumen packages range from 4,800 - 84,000 lumens (35W - 588W)
 - Replaces 70W up to 1,000W HID equivalents
 - Efficacies up to 160 lumens per watt
 - Energy and maintenance savings up to 85% versus HID solutions
 - Standard universal quick mount arm with universal drill pattern
- Dimensional Details

Product Code

Type

Project

Date

dmf Lighting® 1118 E. 223rd St. Carson, CA 90745 T: 1.800.441.4422
© 2019 DMF Lighting. All Rights Reserved. Specifications subject to change without notice.

Lumark

Prevail LED

Ordering Information

Sample Number: PRV-L-CTS-D-UNV-T4-SA-BZ

Product Family	Light Engine	Color Temperature	Driver	Voltage	Distribution	Mounting	Color
PRV-P-Prevail Pelite	210-1 (L) 1,100 Nominal Lumens 210-2 (L) 1,100 Nominal Lumens 210-3 (L) 1,100 Nominal Lumens	2700K, 3000K, 3500K, 4000K	IC Rated eULus Listed ENERGY STAR®	120V, 277V 50/60Hz	12-Type B 12-Type C	12-Type B 12-Type C	12-Type B 12-Type C
PRV-M-Prevail Mini	210-1 (L) 1,100 Nominal Lumens 210-2 (L) 1,100 Nominal Lumens 210-3 (L) 1,100 Nominal Lumens	2700K, 3000K, 3500K, 4000K	IC Rated eULus Listed ENERGY STAR®	120V, 277V 50/60Hz	12-Type B 12-Type C	12-Type B 12-Type C	12-Type B 12-Type C
PRV-SL-Prevail SL	210-1 (L) 1,100 Nominal Lumens 210-2 (L) 1,100 Nominal Lumens 210-3 (L) 1,100 Nominal Lumens	2700K, 3000K, 3500K, 4000K	IC Rated eULus Listed ENERGY STAR®	120V, 277V 50/60Hz	12-Type B 12-Type C	12-Type B 12-Type C	12-Type B 12-Type C

Product Code

Type

Project

Date

dmf Lighting® 1118 E. 223rd St. Carson, CA 90745 T: 1.800.441.4422
© 2019 DMF Lighting. All Rights Reserved. Specifications subject to change without notice.

dmf

Type LED-2 DRD2

Recessed LED Downlight
General New Construction
4", 5", 6" Aperture

PRODUCT SPECIFICATIONS

- Maximum installation compatibility
- Twist & Lock feature for easy trim installation
- 750 & 1000 lumen outputs
- 2700K, 3000K, 3500K, 4000K CCT
- Flicker-free TRIAC/ELV, 0-10V, or EcoSystem® dimming
- 50,000 hr lifetime at 70% lumen maintenance
- 5 year limited warranty

Product Code

Type

Project

Date

dmf Lighting® 1118 E. 223rd St. Carson, CA 90745 T: 1.800.441.4422
© 2019 DMF Lighting. All Rights Reserved. Specifications subject to change without notice.

dmf

Type LED-2 DRD2

Recessed LED Downlight
General New Construction
4", 5", 6" Aperture

PRODUCT SPECIFICATIONS

- Maximum installation compatibility
- Twist & Lock feature for easy trim installation
- 750 & 1000 lumen outputs
- 2700K, 3000K, 3500K, 4000K CCT
- Flicker-free TRIAC/ELV, 0-10V, or EcoSystem® dimming
- 50,000 hr lifetime at 70% lumen maintenance
- 5 year limited warranty

Product Code

Type

Project

Date

dmf Lighting® 1118 E. 223rd St. Carson, CA 90745 T: 1.800.441.4422
© 2019 DMF Lighting. All Rights Reserved. Specifications subject to change without notice.

diode led

INFINILINE® 120V LED Strip Light

SPECIFICATION SHEET

Voltage/Wattage
2700K 289 W/m
3000K 300 W/m
3500K 308 W/m
4200K 351 W/m

Max. Run*
164 feet

Custom Produced
See Page 2

LED Chips
21/foot

CRI
90+

Field Cuttable
No

Dimensions
0.63 x 0.31 in. (W x H)

Environment
Outdoor / Wet Location / IP65

Certification
UL Listed (US), ETL Listed (Canada)

Dimmable
Yes (Hardware only), down to 10% using Lutron DVELV-300P, NTELV-300, or NTE-10 Dimmers

Warranty
5-Year Standard, 2-Year Deep Cold*

SKU Builder

DI - 120V - INFBCS3 - TBD - TBD - Mounting

Voltage Model Color Temp Connection SKU Length SEE PAGE 2 Mounting

27 (2700K) - (Plug-In) RTCL* (Rotating Mounting Clips)

30 (3000K) H (Hardwire) RTCL* (Rotating Mounting Clips)

35 (3500K) RTCL* (Rotating Mounting Clips)

42 (4200K) RTCL* (Rotating Mounting Clips)

Example: DI-120V-INFBCS3-H-240= Diode, 120 Volt, INFINILINE®, 4200K CCT, Hardwire lead, 20 feet custom cut.

*Rotating Mounting Clips must be used with Hardware installations to retain UL Listing.

diode led

INFINILINE® 120V LED Strip Light

SPECIFICATION SHEET

Voltage/Wattage
2700K 289 W/m
3000K 300 W/m
3500K 308 W/m
4200K 351 W/m

Max. Run*
164 feet

Custom Produced
See Page 2

LED Chips
21/foot

CRI
90+

Field Cuttable
No

Dimensions
0.63 x 0.31 in. (W x H)

Environment
Outdoor / Wet Location / IP65

Certification
UL Listed (US), ETL Listed (Canada)

Dimmable
Yes (Hardware only), down to 10% using Lutron DVELV-300P, NTELV-300, or NTE-10 Dimmers

Warranty
5-Year Standard, 2-Year Deep Cold*

SKU Builder

DI - 120V - INFBCS3 - TBD - TBD - Mounting

Voltage Model Color Temp Connection SKU Length SEE PAGE 2 Mounting

27 (2700K) - (Plug-In) RTCL* (Rotating Mounting Clips)

30 (3000K) H (Hardwire) RTCL* (Rotating Mounting Clips)

35 (3500K) RTCL* (Rotating Mounting Clips)

42 (4200K) RTCL* (Rotating Mounting Clips)

Example: DI-120V-INFBCS3-H-240= Diode, 120 Volt, INFINILINE®, 4200K CCT, Hardwire lead, 20 feet custom cut.

*Rotating Mounting Clips must be used with Hardware installations to retain UL Listing.

INFINILINE® 120V LED Strip Light

SPECIFICATION SHEET

Voltage/Wattage
2700K 289 W/m
3000K 300 W/m
3500K 308 W/m
4200K 351 W/m

Max. Run*
164 feet

Custom Produced
See Page 2

LED Chips
21/foot

CRI
90+

Field Cuttable
No

Dimensions
0.63 x 0.31 in. (W x H)

Environment
Outdoor / Wet Location / IP65

Certification
UL Listed (US), ETL Listed (Canada)

Dimmable
Yes (Hardware only), down to 10% using Lutron DVELV-300P, NTELV-300, or NTE-10 Dimmers

Warranty
5-Year Standard, 2-Year Deep Cold*

SKU Builder

DI - 120V - INFBCS3 - TBD - TBD - Mounting

Voltage Model Color Temp Connection SKU Length SEE PAGE 2 Mounting

27 (2700K) - (Plug-In) RTCL* (Rotating Mounting Clips)

30 (3000K) H (Hardwire) RTCL* (Rotating Mounting Clips)

35 (3500K) RTCL* (Rotating Mounting Clips)

42 (4200K) RTCL* (Rotating Mounting Clips)

Example: DI-120V-INFBCS3-H-240= Diode, 120 Volt, INFINILINE®, 4200K CCT, Hardwire lead, 20 feet custom cut.

*Rotating Mounting Clips must be used with Hardware installations to retain UL Listing.

Project No:	08G02
Drawn By:	JG
Checked By:	JG
Date:	August 25, 2023

dmf Lighting® 1118 E. 223rd St. Carson, CA 90745 T: 1.800.441.4422
© 2019 DMF Lighting. All Rights Reserved. Specifications subject to change without notice.

PHOTOMETRIC DETAILS

13

SITE PLAN DOCUMENTS
DOUGLAS 234, FILING NO. 6,
AMENDMENT 1, LOT 4
QUALITY BRAND GROUP CO, LLC

CHAMBERS & HESS
PARKER, CO

COPYRIGHT
THESE PLANS ARE AN INSTRUMENT OF SERVICE
AND ARE THE PROPERTY OF GALLOWAY, AND MAY
NOT BE DUPLICATED, DISCLOSED, OR REPRODUCED
WITHOUT THE WRITTEN CONSENT OF GALLOWAY.
COPYRIGHTS AND INFRINGEMENTS WILL BE
ENFORCED AND PROSECUTED.

PRELIMINARY
NOT FOR BIDDING
NOT FOR CONSTRUCTION

Galloway
5500 Greenwood Plaza Blvd., Suite 200
Greenwood Village, CO 80111
303.770.8884
GallowayUS.com

SITE PLAN

DOUGLAS 234, FILING NO. 6, AMENDMENT 1, LOT 4

A PORTION OF THE SOUTHWEST QUARTER OF THE SOUTHEAST QUARTER OF SECTION 29,
TOWNSHIP 6 SOUTH, RANGE 66 WEST, 6TH PRINCIPAL MERIDIAN,
TOWN OF PARKER, COUNTY OF DOUGLAS, STATE OF COLORADO
13.80 ACRES, 11 COMMERCIAL LOTS

Ensure that the color elevations are included in the next Site Plan Document.

**SITE PLAN FOR
DUNKIN' DONUTS
DOUGLAS 234, FILING NO. 6,
AMENDMENT 1, LOT 4**

A PORTION OF THE SOUTHWEST QUARTER OF THE SOUTHEAST QUARTER OF SECTION 29,
TOWNSHIP 6 SOUTH, RANGE 66 WEST, 6TH PRINCIPAL MERIDIAN,
TOWN OF PARKER, COUNTY OF DOUGLAS, STATE OF COLORADO
0.901 ACRES, 1 COMMERCIAL LOT

PER DISCUSSION WITH TOWN OF PARKER STAFF
ON AUGUST 30TH, 2023, BUILDING ELEVATIONS
ARE IN PROCESS AND WILL BE SUBMITTED FOR
TOWN REVIEW ONCE COMPLETED.



Know what's below.
Call before you dig.

DRAWING NO. 14

PLAN PREPARED FOR:
**DOUGLAS 234, FILING NO. 6,
AMENDMENT 1, LOT 4**
DOUGLAS COUNTY, COLORADO

RICK
ENGINEERING COMPANY
 8678 CONCORD CENTER DR., UNIT 200
 ENGLEWOOD, CO 80112
 303.537.8020
 richengineering.com
 San Diego - Riverside - San Luis Obispo - Sacramento - Orange - Tucson - Phoenix - Las Vegas - Denver

SEAL:

2ND SUBMITTAL

**SITE PLAN FOR
DUNKIN' DONUTS
DOUGLAS 234, FILING NO. 6,
AMENDMENT 1, LOT 4**

A PORTION OF THE SOUTHWEST QUARTER OF THE SOUTHEAST QUARTER OF SECTION 29,
TOWNSHIP 6 SOUTH, RANGE 66 WEST, 6TH PRINCIPAL MERIDIAN,
TOWN OF PARKER, COUNTY OF DOUGLAS, STATE OF COLORADO
0.901 ACRES, 1 COMMERCIAL LOT

PER DISCUSSION WITH TOWN OF PARKER STAFF
ON AUGUST 30TH, 2023, BUILDING ELEVATIONS
ARE IN PROCESS AND WILL BE SUBMITTED FOR
TOWN REVIEW ONCE COMPLETED.



Know what's below.
Call before you dig.

DRAWING NO. 15

PLAN PREPARED FOR:
**DOUGLAS 234, FILING NO. 6,
AMENDMENT 1, LOT 4**
DOUGLAS COUNTY, COLORADO

BUILDING ELEVATIONS

RICK
8678 CONCORD CENTER DR, UNIT 200
ENGLEWOOD, CO 80112
303.537.8020

ENGINEERING COMPANY
303.337.0020
rickengineering.com

PROJECT NO:	2243	DRAWN/DESIGNED BY:	KA/JS
-------------	------	--------------------	-------

SEAL:

[illegible]

COLOR LEGEND



MATERIAL LEGEND

FCB	FIBER CEMENT BOARD
MT	METAL TRIM / COPING CAP
SC	STEEL CHANEL
EMC	EXTRUDED METAL CHANEL
PT	PAINT
STN	MANUFACTURED STONE

WINDOW CALCULATIONS:

FACADE: 464 SF
40% WINDOW OR DESIGN ELEMENT: 185 SF

WINDOW: 108 SF
DESIGN ELEMENT: 80 SF
TOTAL: 188 SF



2 EXTERIOR ELEVATION - FRONT
SCALE: 1/4" = 1'-0"


- Include cardinal directions

Wrap this element around the corner to create a true corner tower feature.

WINDOW CALCULATIONS:

FACADE: 1,334 SF
40% WINDOW OR DESIGN ELEMENT: 533 SF

WINDOW: 315 SF
DESIGN ELEMENT: 225 SF
TOTAL: 540 SF

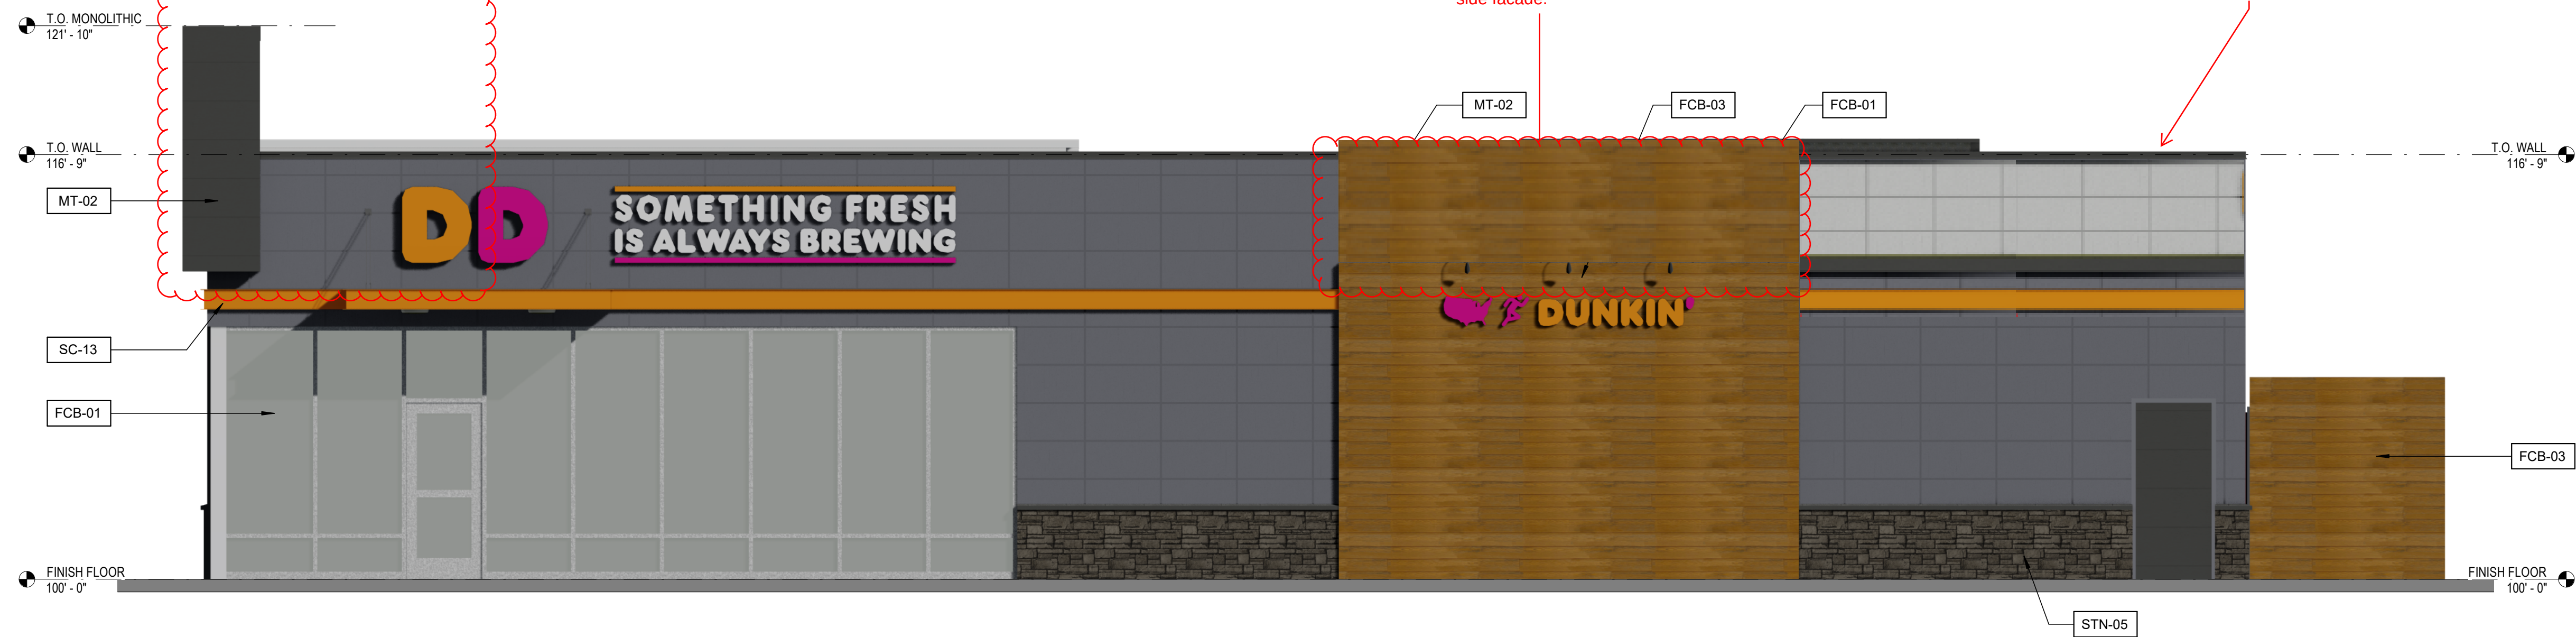

1 EXTERIOR ELEVATION - RIGHT SIDE
SCALE: 1/4" = 1'-0"

Galloway


5500 Greenwood Plaza Blvd., Suite 200
Greenwood Village, CO 80111
303.770.8884
GallowayUS.com

STAMP

PRELIMINARY
NOT FOR BIDDING
NOT FOR CONSTRUCTION

COPYRIGHT

THESE PLANS ARE AN INSTRUMENT OF SERVICE AND ARE THE PROPERTY OF GALLOWAY, AND MAY NOT BE DUPLICATED, DISCLOSED, OR REPRODUCED WITHOUT THE WRITTEN CONSENT OF GALLOWAY. COPYRIGHTS AND INFRINGEMENT WILL BE ENFORCED AND PROSECUTED.

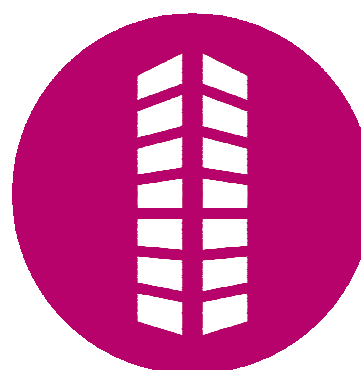

SITE PLAN DOCUMENTS
DOUGLAS 234, FILING NO. 6,
AMENDMENT 1, LOT 4
QUALITY BRAND GROUP CO, LLC

CHAMBERS & HESS
PARKER, CO

[illegible]

Project No:	XXX#####
Drawn By:	Auth
Checked By:	Check

BUILDING ELEVATIONS

T.O. MONOLITHIC
121' - 10"

T.O. WALL
116' - 9"

FINISH FLOOR
100' - 0"

MT-02

FCB-01

SC-13

FCB-03

T.O. WALL
116' - 9"

FINISH FLOOR
100' - 0"

Architectural elevation drawing of a Dunkin' Drive Thru building. The drawing shows a cross-section of the building with various materials and components labeled. The building has a stone base, a grey brick upper section, and a wood-paneled section. A red dashed line outlines the drive-thru area. Labels include: FCB-03, MT-02, FCB-01, EMC-12, FCB-03, EMC-04, T.O. WALL 116'-9", T.O. MONOLITHIC 121'-10", T.O. PARAPET 117'-3", DUNKIN' DRIVE THRU, SC-13, FCB-01, STN-05, FINISH FLOOR 100'-0", and FINISH FLOOR 100'-0".



Project Number: SP22-041

Description: Douglas 234 F6 AMD 1 L4 - Dunkin Donuts

Applied: 4/4/2022

Approved:

Site Address:

Closed:

Expired:

City, State Zip Code: ,

Status: UNDER REVIEW 2

Applicant: Brynhildr Halsten

Parent Project: SUB21-022

Owner: bert hayenga

Contractor: Bert Hayenga

Details:

The applicant, Ethos Architecture, is proposing a 2,108 sq. ft. drive through donut store. The site is located northeast of Hess Road and Chambers Road.

LIST OF REVIEWS

SENT DATE	RETURNED DATE	DUE DATE	TYPE	CONTACT	STATUS	REMARKS
-----------	---------------	----------	------	---------	--------	---------



PARKER
COLORADO

Project Reviews Town of Parker

Review Group: ALL

4/22/2022	5/10/2022	5/2/2022	COMPLETENESS REVIEW	Carson Byerhof	REVISIONS REQUIRED	Notes
-----------	-----------	----------	---------------------	----------------	-----------------------	-------

Notes:

MISSING

- Exhibit A – Legal Description – please make sure this document reflects the location information as portrayed with the County Assessor's Office (example attached)
- Exhibit B – Title (must be current to 30 days)
- Exhibit E – Vicinity Map – showing the relationship of the site to the surrounding area within a ½-mile radius
- Executed Charge Back Agreement (attached)
- Public Notice Requirements – momentarily, I will start a new email thread connecting you to our third-party vendor requesting the public sign installations
- Project narrative – a brief description of what is being proposed to send out to all agencies. Include the following:
 - o Applicant's name and contact information
 - o Description of the general proposal
 - o Present zoning
 - o General development schedule and phasing plan
- Fees have been added to TRACKIT
- Please send a physical materials board to Town Hall addressed to Carson Byerhof

REQUIRED REVISIONS

- Application
 - o Property Information
 - ? Revise information for name, general location, PLSS, and plat information to match the County Assessor's Office
 - o Property Owner of Record
 - ? This information needs to match the name given in the title (note, exhibits C & D also need to match the name given in the title)
 - o Utility Providers
 - ? Water – Parker Water and Sanitation District
 - ? Sanitary Sewer – Parker Water and Sanitation District
 - ? Fire – South Metro Fire Rescue
 - o Current Property and Zoning Use
 - ? Zoning – PD – Douglas 234
 - ? Specify – Commercial
 - ? Current Use – Vacant
 - ? Subdivision – Douglas 234
- Site Plan Exhibits
 - o Missing colored elevations and perspectives
 - o Include a sheet with digital materials board

6/1/2022	6/14/2022	6/3/2022	COMPLETENESS REVIEW	Carson Byerhof	REVISIONS REQUIRED	02 review notes
----------	-----------	----------	---------------------	----------------	-----------------------	-------------------

Notes:

- need following items before comments can be returned
- rough perspective
 - physical materials board
 - updated charge back, resigned

6/14/2022	7/22/2022	7/13/2022	COMPLETENESS REVIEW	Carson Byerhof	REVISIONS REQUIRED	03 review notes
-----------	-----------	-----------	---------------------	----------------	-----------------------	-------------------

Notes:

- need following items before comments can be returned
- rough perspective
 - physical materials board
 - updated charge back, resigned
- Still missing physical materials board and updated charge back agreement



PARKER
COLORADO

Project Reviews Town of Parker



Review Group: AUTO

4/4/2022			ENGINEERING ADMINISTRATIVE	Tom Williams		
----------	--	--	-------------------------------	--------------	--	--

Notes:

4/4/2022	4/27/2022	4/18/2022	LAND USE COMPLETENESS REVIEW	Alex Mestdagh	COMPLETED	
----------	-----------	-----------	---------------------------------	---------------	-----------	--

Notes:

Review Group: SP 1ST 20

6/13/2022	7/8/2022	7/13/2022	BUILDING 20	Randy Sale	APPROVED	01 review
-----------	----------	-----------	-------------	------------	----------	-----------

Notes:

We highly encourage a Building pre-application meeting before applying for the permit to discuss construction type, occupancy, allowable areas, MEP's, energy, structural, fire, etc... Please visit our website for all plan submittal requirements: Plan Review | Town of Parker - Official Website (parkeronline.org), and our most current code adoptions.

Building and/or Fire Life Safety permit application will not be accepted/reviewed until the associated site plan is approved or otherwise discussed. All plans submitted for Building's review must meet the 2021 I-Codes, ICC A117.1-2017 for accessibility, the 2020 NEC, and the referenced NFPA editions noted in the applicable codes (i.e., 2021 IFC references the 2019 edition of NFPA 72) if received by December 31, 2024. NFRC certificates, interior/exterior lighting along with the mechanical and envelope compliance path must be included with the original submittal. All Fire Permit applications and inspections will be handled through the Parker Building Division. All land use applications and the associated Grading Permit must be approved/issued per Planning and Public Works prior to the Building Permit being approved/issued.

Retaining walls greater than 4' from base of footing or bottom course requires separate building permits and plans must be stamped by qualified professional. Tiered/staggered/stepped back retaining walls all require permits no matter the height of individual wall.

Please know the Town's Charge Back Agreement may be required for this project, specific to the building permit application. The form will be emailed to the applicant prior to the Building Pre-App meeting or upon receiving the permit application submittal. Once all required documents have been accepted and the charge back agreement form has been returned signed to the Building Division, then full plan review process may be able to begin.

Please contact us with any questions, 303.841.1970.



PARKER
COLORADO

Project Reviews Town of Parker



6/13/2022	7/4/2022	7/13/2022	CENTURYLINK COMMUNICATIONS 20	CenturyLink	NO COMMENT	01 review
-----------	----------	-----------	----------------------------------	-------------	------------	-----------

Notes: From: PlatReview <PlatReview@lumen.com> Sent: Monday, July 4, 2022 9:41 AM To: Byerhof, Carson <cbyerhof@parkeronline.org> Cc: Benson, William <William.Benson2@lumen.com> Subject: RE: Referral Agency Response Request Requester, Our engineer has reviewed this plat and their comments are: "I have reviewed this project and have no objections or comments." If you require signatures, you can contact the engineer CC'd on this email and if you have any further questions, please don't hesitate to reach out. Thank you! Lumen Plat Review -----Original Message----- From: cbyerhof@parkeronline.org <cbyerhof@parkeronline.org> Sent: Monday, June 13, 2022 5:29 PM To: PlatReview <PlatReview@lumen.com> Subject: Referral Agency Response Request CAUTION: This email originated outside of Lumen Technologies. Do not click links or open attachments unless you recognize the sender and know the content is safe.						
---	--	--	--	--	--	--

6/13/2022	6/24/2022	7/13/2022	CHERRY CREEK BASIN WATER QUALITY AUTHORITY 20	Rich Borchardt	ADVISORY COMMENTS	See Comments
-----------	-----------	-----------	---	----------------	----------------------	--------------

Notes: 1. The Authority's Control Regulation 72 requires construction and post-construction Best Management Practices (BMPs). 2. No exceptions taken with the construction BMP plan 3. Provide description of post construction BMPs (permanent water quality) for the site. 4. The Authority reserves the right to review and comment on future referrals for the project.						
--	--	--	--	--	--	--

6/13/2022		7/13/2022	COMCAST 20	Butch Buster		01 review
-----------	--	-----------	------------	--------------	--	-----------

Notes:						
--------	--	--	--	--	--	--

6/13/2022	7/15/2022	7/13/2022	CONST PLANS - ENVIRONMENTAL	Michael Walton	REVISIONS REQUIRED	See Stormwater Memo
-----------	-----------	-----------	--------------------------------	----------------	-----------------------	---------------------

Notes:						
--------	--	--	--	--	--	--

6/13/2022	7/15/2022	7/13/2022	CONST PLANS - STORMWATER	Michael Walton	REVISIONS REQUIRED	See Stormwater Memo
-----------	-----------	-----------	-----------------------------	----------------	-----------------------	---------------------

Notes:						
--------	--	--	--	--	--	--



PARKER
COLORADO

Project Reviews Town of Parker



6/13/2022	8/8/2022	7/13/2022	CONSTRUCTION PLANS - CIVIL	Michael Walton	ADVISORY COMMENTS	See Notes
Notes: Please consider routing Inlet SDI-02 directly to SDI-01. As proposed, SDMH-02 will require closure of the drive thru for any maintenance activities which could have a significant impact on business during maintenance activities. This configuration would also eliminate the need for the additional manhole structure potentially providing some savings in construction costs.						
6/13/2022	7/6/2022	7/13/2022	DOUGLAS COUNTY ASSESSORS OFFICE 20	Marian Woodward	NO COMMENT	01 review
Notes:						
6/13/2022		7/13/2022	DOUGLAS COUNTY ENGINEERING DIVISION 20	DC Referrals		01 review
Notes:						
6/13/2022	7/12/2022	7/13/2022	DOUGLAS COUNTY PLANNING SERVICES DIVISION 20	DC Referrals	ADVISORY COMMENTS	01 review
Notes: Addressing Comments: The proposed address is 12211 SLICEROO DRIVE. This address is not to be used for any purpose other than for plan review until after this project is approved. Proposed addresses are subject to changes as necessary for 911 dispatch and life safety purposes. Addresses are recorded by Douglas County following all necessary approvals. Send confirmation of project approval to this office by email. Contact DCAAddressing@douglas.co.us or 303.660.7411 with questions.						
6/13/2022		7/13/2022	DOUGLAS COUNTY SCHOOL DISTRICT RE1 20	Shavon Caldwell		01 review
Notes:						
6/13/2022	7/29/2022	7/13/2022	DRAINAGE REPORT - CIVIL	Alex Mestdagh	NO COMMENT	01 review
Notes:						
6/13/2022	7/15/2022	7/13/2022	DRAINAGE REPORT - STORMWATER	Michael Walton	REVISIONS REQUIRED	See Stormwater Memo
Notes: Provide a drainage conformance letter specific to this site plan application.						
6/13/2022		7/13/2022	ECONOMIC DEVELOPMENT 20	Bo Martinez		01 review
Notes:						



PARKER
COLORADO

Project Reviews Town of Parker



6/13/2022	6/27/2022	7/13/2022	FIRE LIFE SAFETY 20	Randy Capra	REVISIONS REQUIRED	See Notes
Notes: The site plan does not work with regard to emergency access; the long dead end... at approximately 260 feet must be addressed. See response letter named "SP22-041 Douglas 234 F6 AMD1 L4 Dunkin Donuts Fire Life Safety Response Ltr [1] Submittal 062722" for comments.						
6/13/2022	7/29/2022	7/13/2022	FLOODPLAIN DEVELOPMENT PLAN	Alex Mestdagh	NOT APPLICABLE	01 review
Notes:						
6/13/2022	7/13/2022	7/13/2022	IREA 20	Brooks Kaufman	REVISIONS REQUIRED	01 review
Notes: The applicant will be required to provide transformer and EUSERC Cabinet locations. The applicant will be required to meet clearance requirements per the attached CORE Builder Handbook.						
6/13/2022	7/29/2022	7/13/2022	PLAT - CIVIL	Alex Mestdagh	NOT APPLICABLE	01 review
Notes:						
6/13/2022	7/11/2022	7/13/2022	POLICE 20	Greg Epp	NO COMMENT	01 review
Notes:						
6/13/2022	7/12/2022	7/13/2022	PUBLIC SERVICE COMPANY OF COLORADO 20	Donna George	ADVISORY COMMENTS	see New Notes
Notes: The property owner/developer/contractor must complete the application process for any new natural gas service via xcelenergy.com/InstallAndConnect . It is then the responsibility of the developer to contact the Designer assigned to the project for approval of design details						
6/13/2022	8/8/2022	7/13/2022	SITE PLAN - CIVIL	Michael Walton	APPROVED	01 review
Notes:						
6/13/2022	7/15/2022	7/13/2022	SITE PLAN - STORMWATER	Michael Walton	APPROVED	01 review
Notes:						
6/13/2022	7/28/2022	7/28/2022	SITE PLAN 20	Carson Byerhof	REVISIONS REQUIRED	01 review
Notes: Cannot return comments until outstanding items from completeness review have been submitted. Pushing review out until July 28th See attached, "STAFFcomments...Review01"						



PARKER
COLORADO

Project Reviews Town of Parker



6/13/2022		7/13/2022	SOUTH METRO FIRE 20	South Metro Fire		01 review
Notes:						
6/13/2022	8/8/2022	7/13/2022	TRAFFIC IMPACT STUDY - CIVIL	Michael Walton	REVISIONS REQUIRED	See Notes
Notes:						
Please note that traffic from the proposed development cannot queue on to the adjacent shared access road or impact adjacent properties. Should traffic issues arise the developer will be required to re-analyze and make any necessary improvements to mitigate the issue. Please add text in the narrative acknowledging this within the TIS.						
6/13/2022	7/13/2022	7/13/2022	URBAN DRAINAGE AND FLOOD CONTROL 20	UDFCD	NO COMMENT	01 review
Notes:						
Good Morning,						
We have no comment on Referral Response Request: Douglas 234 F6 AMD 1 L4 - Dunkin Donuts (SP22-041). We appreciate the opportunity to review. Please let me know if you have any questions or concerns.						
Thank you, Pieter van Leeuwen						
Pieter Van Leeuwen Student Intern (He, Him, His) MILE HIGH FLOOD DISTRICT 2480 W. 26th Ave. Suite 156-B Denver, Colorado 80211 Office: 303-455-6277 www.udfcd.org						
Comment letter attached						
Review Group: SP 1ST 20 ADD						
6/13/2022	7/12/2022	7/13/2022	PARKER WATER AND SANITATION DISTRICT 20	Robert Ramsey	REVISIONS REQUIRED	01 review
Notes:						
Please see the uploaded documents.						
Please note PWSD requires all documents to have original signatures.						
Please feel free to contact me with any questions.						
Robert						
6/13/2022		7/13/2022	DOUG 234 HORSE CREEK HOA 20	Lauren Hill		01 review
Notes:						



PARKER
COLORADO

Project Reviews Town of Parker

Review Group: SP 2ND 15

9/20/2023	10/12/2023	10/11/2023	BUILDING 15	Randy Sale	APPROVED	No response required, See notes
-----------	------------	------------	-------------	------------	----------	------------------------------------

Notes:

We highly encourage a Building pre-application meeting before applying for the permit to discuss access requirements during construction, construction type, occupancy, allowable areas, MEP's, energy, structural, fire, etc... Please visit our website for all plan submittal requirements: Plan Review | Town of Parker - Official Website (parkeronline.org), and our most current code adoptions.

Please know the Town's Charge Back Agreement may be required for this project, specific to the building permit application. The form will be emailed to the applicant prior to the Building Pre-App meeting or upon receiving the permit application submittal. Once all required documents have been accepted and the charge back agreement form has been returned signed to the Building Division, then the full plan review process will begin.

General Comments to be aware of:

Building and/or Fire Life Safety permit application will not be accepted/reviewed until the associated site plan is approved or otherwise discussed. All plans submitted for Building's review must meet the 2021 I-Codes, ICC A117.1-2017 for accessibility, the 2020 NEC, and the referenced NFPA editions noted in the applicable codes (i.e., 2021 IFC references the 2019 edition of NFPA 72) if received by December 31, 2024. NFRC certificates, interior/exterior lighting along with the mechanical and envelope compliance path must be included with the original submittal. All Fire Permit applications and inspections will be handled through the Parker Building Division. All land use applications and the associated Grading Permit must be approved/issued per Planning and Public Works prior to the Building Permit being approved/issued.

Retaining walls greater than 4' from base of footing or bottom course requires separate building permits and plans must be stamped by a qualified professional. Tiered, staggered, stepped back retaining walls all require permits no matter the height of individual wall.

9/20/2023	9/22/2023	10/11/2023	CHERRY CREEK BASIN WATER QUALITY AUTHORITY 15	Val Endyk	ADVISORY COMMENTS	See Notes
-----------	-----------	------------	---	-----------	----------------------	-----------

Notes:

The Cherry Creek Basin Water Quality Authority (Authority) acknowledges notification from the Town of Parker that the proposed development plans for SP22-041, Douglas 234 F6 AMD 1 L4 - Dunkin Donuts have been or will be reviewed by the Town of Parker for compliance with the applicable Regulation 72 construction and post-construction requirements. Based on the Authority's current policy, the Authority will no longer routinely conduct a technical review and instead the Authority will defer to the Town of Parker's review and ultimate determination that the proposed development plans comply with Regulation 72.

If a technical review of the proposed development plan is needed, please contact LandUseReferral@ccbwwqa.org. The review may include consultation with the Authority's Technical Manager to address specific questions or to conduct a more detailed Land Use Review, if warranted.



PARKER
COLORADO

Project Reviews Town of Parker



9/20/2023	10/11/2023	10/11/2023	CONST PLANS - ENVIRONMENTAL 15	Robert Seacat	REVISIONS REQUIRED	See Engineering Memo and Comments
-----------	------------	------------	--------------------------------	---------------	--------------------	-----------------------------------

Notes:

SP22-041 – Douglas 234 F6 AMD 1 L4 - Dunkin Donuts, 2nd, 10-11-23

GENERAL COMMENTS for ALL Erosion Control Plan Sheets

Please note that a CBMP Estimate will be required and reviewed with the Grading Permit after all CBMP comments have been addressed and the final site plan is near approval.

1. Please add a note stating – “THE TRUE LOCATION OF THE VTC, CWA, and PTs MAY BE DETERMINED BY THE TOWN AND THE ECS”.
2. Please add a note stating – “MASONRY WORK PROTECTION IS REQUIRED FOR CONSTRUCTION OF BUILDINGS”.
3. Please add a note stating – “ANY ONSITE BULK FUEL STORAGE REQUIRES A FIRE LIFE SAFETY PERMIT FROM THE TOWN OF PARKER PRIOR TO INSTALLATION”. Contact Randy Capra at 303-805-3136 or rcapra@parkeronline.org for FLS Permit questions.
4. Please show multiple Portable Toilet Protections (PTP), a site this size must have at least 2 at initial phase. Addition PTPs may be needed in the interim and final phases.
5. Please provide and identify in curb line rock sock protection (4) on Slicero Drive to the southeast, down gradient of site. Follow the Inlet Protection Curb on Grade detail for installation.

INITIAL CBMP PLANS

6. Please consider moving the Vehicle Tracking Control (VTC) to the north end of Slicero Drive. This configuration helps limit the amount of Stormwater Sheet Flow washing over the VTC and flowing off-site during a rain event. Please provide and identify construction fence along the sides of the VTC to assure use of the entire 50-foot pad.

INTERIM/FINAL CBMP PLANS

7. Provide and identify Masonry Work Protection (MWP) on the plans in two locations for Construction of the building.
8. Please remove ALL Traffic Striping Arrows from the CBMP Drawings to avoid confusion with the stormwater flow arrows.

9/20/2023	10/11/2023	10/11/2023	CONSTRUCTION PLANS - CIVIL 15	Michael Walton	REVISIONS REQUIRED	See Engineering Memo
-----------	------------	------------	-------------------------------	----------------	--------------------	----------------------

Notes:

9/20/2023	10/11/2023	10/11/2023	DRAINAGE REPORT - CIVIL 15	Michael Walton	REVISIONS REQUIRED	See Engineering Memo
-----------	------------	------------	----------------------------	----------------	--------------------	----------------------

Notes:

9/20/2023	9/26/2023	10/11/2023	FIRE LIFE SAFETY 15	Randy Capra	REVISIONS REQUIRED	See latest response letter and provide a written response
-----------	-----------	------------	---------------------	-------------	--------------------	---

Notes:

9/20/2023	10/3/2023	10/11/2023	IREA 15	Brooks Kaufman	REVISIONS REQUIRED	Provide transformer and EUSERC Cabinet locations
-----------	-----------	------------	---------	----------------	--------------------	--

Notes:

The applicant will be required to provide transformer and EUSERC Cabinet locations and meet CORE's requirements per the attached builder handbook. In addition, the proposed trash enclosure and sign may not encroach into the 15-foot utility easement.



PARKER
COLORADO

Project Reviews Town of Parker



9/20/2023	10/11/2023	10/11/2023	SITE PLAN - CIVIL 15	Michael Walton	APPROVED	
Notes:						
9/20/2023	10/16/2023	10/11/2023	SITE PLAN 15	Ashley Chasez	REVISIONS REQUIRED	See notes
Notes:						
Only one minor change, all rock has to be 2" or larger. Will need to review again changes are made to address other reviewer's comments and once the color elevations are submitted.						
9/20/2023	10/11/2023	10/11/2023	TRAFFIC IMPACT STUDY - CIVIL 15	Michael Walton	REVISIONS REQUIRED	See Engineering Memo
Notes:						
Review Group: SP 2ND 15 ADD						
9/20/2023	10/11/2023	10/11/2023	PARKER WATER AND SANITATION DISTRICT 15	Robert Ramsey	REVISIONS REQUIRED	See Notes
Notes:						
Please see uploaded red lined plans and comment letter.						