



Development Review Division

Community Development Department: *Town Hall / 20120 East Mainstreet Parker, CO 80138* Phone: 303.841.2332 Fax: 303.841.3223

MEMORANDUM

TO: Brynhildr Halsten, Galloway & Company
FROM: Ashley Chasez, Planner I
DATE: October 25, 2023
SUBJECT: Douglas 234 F6 AMD 1 L4 - Dunkin Donuts
Review Comments 02

Listed below are the Planning Division's comments related to your land use application, which must be responded to. If you wish to discuss a comment, please contact your Case Planner. Upon resubmittal, please sign and return this memo. A follow-up meeting with the reviewing agencies can be scheduled to provide additional guidance by contacting the Case Planner.

TOWN OF PARKER PLANNING DEPARTMENT CASE PLANNER: Ashley Chasez

EMAIL: achasez@parkeronline.org

PHONE: 303.805.3331

GENERAL PROJECT COMMENTS:

1. The Planning Division references certain sections of the Parker 2035 Master Plan, the Land Development Ordinance (LDO) and the Development Design Standards. Copies of these documents are available at:
[Parker 2035 Master Plan](#)
[Development Design Standards](#)
[Land Development Ordinance](#)
2. The Planning Division has made every effort to make this comment letter as comprehensive as possible. However, additional comments that have not been provided as part of this comment letter may be identified as part of future submittals, based on revisions to the project.
3. Please contact the referral agencies if you have questions regarding their review comment(s).
4. A redlined plan is included with this memorandum and is intended to supplement and clarify the review comments of this memorandum.
5. Final Plans submitted to the Building Department, Engineering Department and Parker Water and Sanitation District **must be exactly the same as the approved Site Plan set.**
6. The Town of Parker has implemented a naming convention for all applications. For all future documents that are uploaded to TRAKIT please ensure the submittal round is first, the name of the document is second and the name of the project is third. Staff will not refer the application out with this naming convention.
Example: "02" or "Second Submittal"

- 7. **Prairie Dog Management:** The Town’s current land development ordinance section 13.10.250 - Prairie Dog Management requires applicants/developers to make a good faith effort to have any prairie dogs on site relocated. Documentation of this effort will be a condition of the land use application approval/site development and a certificate of compliance will be required prior to issuance of the grading permit. If relocation of the prairie dogs is not available, humane extermination may be considered. Prairie Dog management should begin as early as possible during the review process. Please coordinate with staff.
- 8. **Utility transformers:** Pursuant to section 13.10.090- Utilities of the Town of Parker Land Development Ordinance all on-site utilities serving a single use shall be placed underground. On-site utilities for the provision of service to nonresidential use(s) such as pedestals, transformers or other equipment may be placed above ground in a rear-yard or side-yard utility easement only. Transformers and other utility equipment associated with the application shall be shown on the approved Site Plan. Please work with staff to determine the correct placement for this equipment.

Site Plan and Project Details

1. Please see the attached redlines for additional information.

Comment Addressed: Yes No

Response:

RICK RESPONSE: NOTED.

OUTSIDE REFERRAL AGENCY COMMENTS

Please address all outside referral agency comments with a written response. The following agencies have provided comments for review:

- Town of Parker – Construction Plan (Environmental)
- Town of Parker – Construction Plan (Civil)
- Town of Parker – Drainage Report
- Town of Parker – Fire, Life & Safety
- Town of Parker – Traffic Impact Study
- Parker Water and Sanitation District
- CORE Electric
- Cherry Creek Basin Water Quality Authority

Attached to the Planning comments is a printout of all review comments on the project. These comments include all comments from the first submittal to the most recent. They are organized from oldest to most recent. Therefore, the comments from this referral can be found at the end of the document.

Comment(s) Addressed: Yes No

Response:

RICK RESPONSE: NOTED. WE HAVE ADDRESSED ALL OUTSIDE REFERRAL COMMENTS AND HAVE PROVIDED SEPARATE WRITTEN RESPONSES.

Staff Comments 02
SP22-041
Douglas 234 F6 AMD 1 L4 - Dunkin Donuts
10/25/2023

Property Owner

Date

Project Representative

Date

CONTACT LIST

DEVELOPER

FIRST CUP DUNKIN' DONUTS, LLC
106 S. KYRENE RD, SUITE 2
CHANDLER, AZ 85226
PHONE: 480.313.2724
CONTACT: BRIAN ZUREK

ARCHITECT

ETHOS ARCHITECTURE GROUP
8025 W. 25TH PLACE
LAKEWOOD, CO 80214
PHONE: 303.374.9896
CONTACT: JOHN SPONSELLER

ENGINEER

RICK ENGINEERING COMPANY
8678 CONCORD CENTER DR, UNIT 200
ENGLEWOOD, CO 80112
PHONE: 303.537.8020
CONTACT: TROY BALES

SURVEYOR

RICK ENGINEERING COMPANY
5690 WEBSTER ST.
ARVADA, CO 80002
PHONE: 303.403.2433
CONTACT: ROBERT HENNESSY

PARKER PUBLIC WORKS

20120 E. MAINSTREET
PARKER, CO. 80138
PHONE: 303.840.9546
STREETS - MIKE WAUGH
STORM WATER - JACOB JAMES

TOWN OF PARKER POLICE DEPARTMENT

19600 E. PARKER SQUARE DR.
PARKER, CO. 80134
PHONE: 303.841.9800

PARKER WATER AND SANITATION DISTRICT

18100 E. WOODMAN DR.
PARKER, CO. 80134
PHONE: 303.841.4627

FIRE & LIFE SAFETY

20120 E. MAINSTREET
PARKER, CO 80138
PHONE: 303.205.3169
CONTACT: RANDALL CAPRA

UTILITY NOTIFICATION COMPANY OF COLORADO

2801 SOUTH YOUNGFIELD ST, SUITE 301
GOLDEN, CO 80401
PHONE: 800.922.1987
LOCAL CALLS: (811)

XCEL ENERGY

5909 E. 38TH AVE.
DENVER, CO 80207
PHONE: 303.329.1618
CONTACT: MICHELLE O'NAN

COMCAST

6850 S. TUCSON WAY
ENGLEWOOD, CO 80112
PHONE: 720.490.3867
CONTACT: KEVIN YOUNG

LUMEN

9750 E. COSTILLA AVE.
ENGLEWOOD, CO 80220
PHONE: 303.792.6069
CONTACT: WILLIAM BENSON

COLORADO DEPARTMENT OF HEALTH

4210 E. 11TH AVE.
DENVER, CO
PHONE: 303.320.8333

INTERMOUNTAIN RURAL ELECTRIC ASSOCIATION

5496 NORTH US HWY 85
P.O. BOX DRAWER A
SEDALIA, CO 80135
PHONE: 303.688.3100
CONTACT: JASON JENKS

MILE HIGH FLOOD CONTROL DISTRICT (MHFCD)

2480 W. 26TH AVE.
SUITE 156-B
DENVER, CO 80211
PHONE: 303.455.6277
CONTACT: MIKE SARMENTO

SITE BENCHMARK & BASIS OF BEARINGS

THE PRIMARY BENCHMARK USED TO DETERMINE THE BASIS OF ELEVATIONS FOR THIS MAP IS BY GPS OBSERVATION NAVD88. A SITE BENCHMARK HAS BEEN SET AT THE NORTHWEST CORNER OF A DRAIN INLET ON CHAMBERS ROAD, APPROXIMATELY 200'± NORTH OF HESS ROAD. ELEVATION = 6075.31

THE BASIS OF BEARINGS IS THE SOUTH LINE OF THE SOUTHEAST QUARTER OF SECTION 29 TOWNSHIP 6 SOUTH, RANGE 66 WEST, 6TH PRINCIPAL MERIDIAN, BEARING SOUTH 89°15'13" WEST AS SHOWN ON FINAL PLAT DOUGLAS 234 FILING NO. 1.

SHEET INDEX	
NO.	TITLE
1	COVER SHEET
2	EXISTING CONDITIONS & DEMOLITION PLAN
3	SITE PLAN
4	PRELIMINARY UTILITY PLAN
5	FIRE TRUCK ACCESS PLAN
6	LANDSCAPE PLAN & DETAILS
7	LANDSCAPE PLAN & DETAILS
8	LANDSCAPE IRRIGATION & DETAILS
9	LANDSCAPE IRRIGATION & DETAILS
10	LANDSCAPE IRRIGATION & DETAILS
11	LANDSCAPE IRRIGATION & DETAILS
12	PHOTOMETRIC PLAN
13	PHOTOMETRIC DETAILS
14	BUILDING ELEVATIONS
15	BUILDING ELEVATIONS

SETBACKS		
COMMERCIAL DEVELOPMENT STANDARDS	REQUIRED SETBACKS	PROVIDED SETBACK
FRONT	10'	143.91'
SIDE	8'	47.59'/62.32'
REAR	0'	64.40'

DEVELOPMENT STANDARDS		
COMMERCIAL DEVELOPMENT STANDARDS	TOWN OF PARKER LAND DEVELOPMENT CODE REQ.	PROVIDED
MINIMUM LANDSCAPE AREA	0.14 AC (15%)	0.305 ACRES (34%)
MAXIMUM BUILDING HEIGHT	35 FEET	1 STORY/ 22'-10"
MINIMUM OFF-STREET PARKING	18 (PER NLA)	18 ON-SITE SPACES (2 ADA SPACES)
MAXIMUM FLOOR AREA RATIO (FAR)	0.35	0.05

FLOOD PLAIN NOTE


BY SCALED MAP LOCATION AND GRAPHIC PLOTTING ONLY, THIS PROPERTY LIES IN ZONE X OF THE FLOOD INSURANCE RATE MAP, COMMUNITY PANEL NUMBER 08035C0181G AND DATED MARCH 16, 2016 - SUBJECT PROPERTY IS NOT IN A SPECIAL FLOOD HAZARD AREA.

LEGAL DESCRIPTION

LOT 4, DOUGLAS 234, FILING NO. 6, AMENDMENT 1


**SITE PLAN FOR
DUNKIN' DONUTS
DOUGLAS 234, FILING NO. 6,
AMENDMENT 1, LOT 4**

A PORTION OF THE SOUTHWEST QUARTER OF THE SOUTHEAST QUARTER OF SECTION 29, TOWNSHIP 6 SOUTH, RANGE 66 WEST, 6TH PRINCIPAL MERIDIAN, TOWN OF PARKER, COUNTY OF DOUGLAS, STATE OF COLORADO
0.901 ACRES, 1 COMMERCIAL LOT

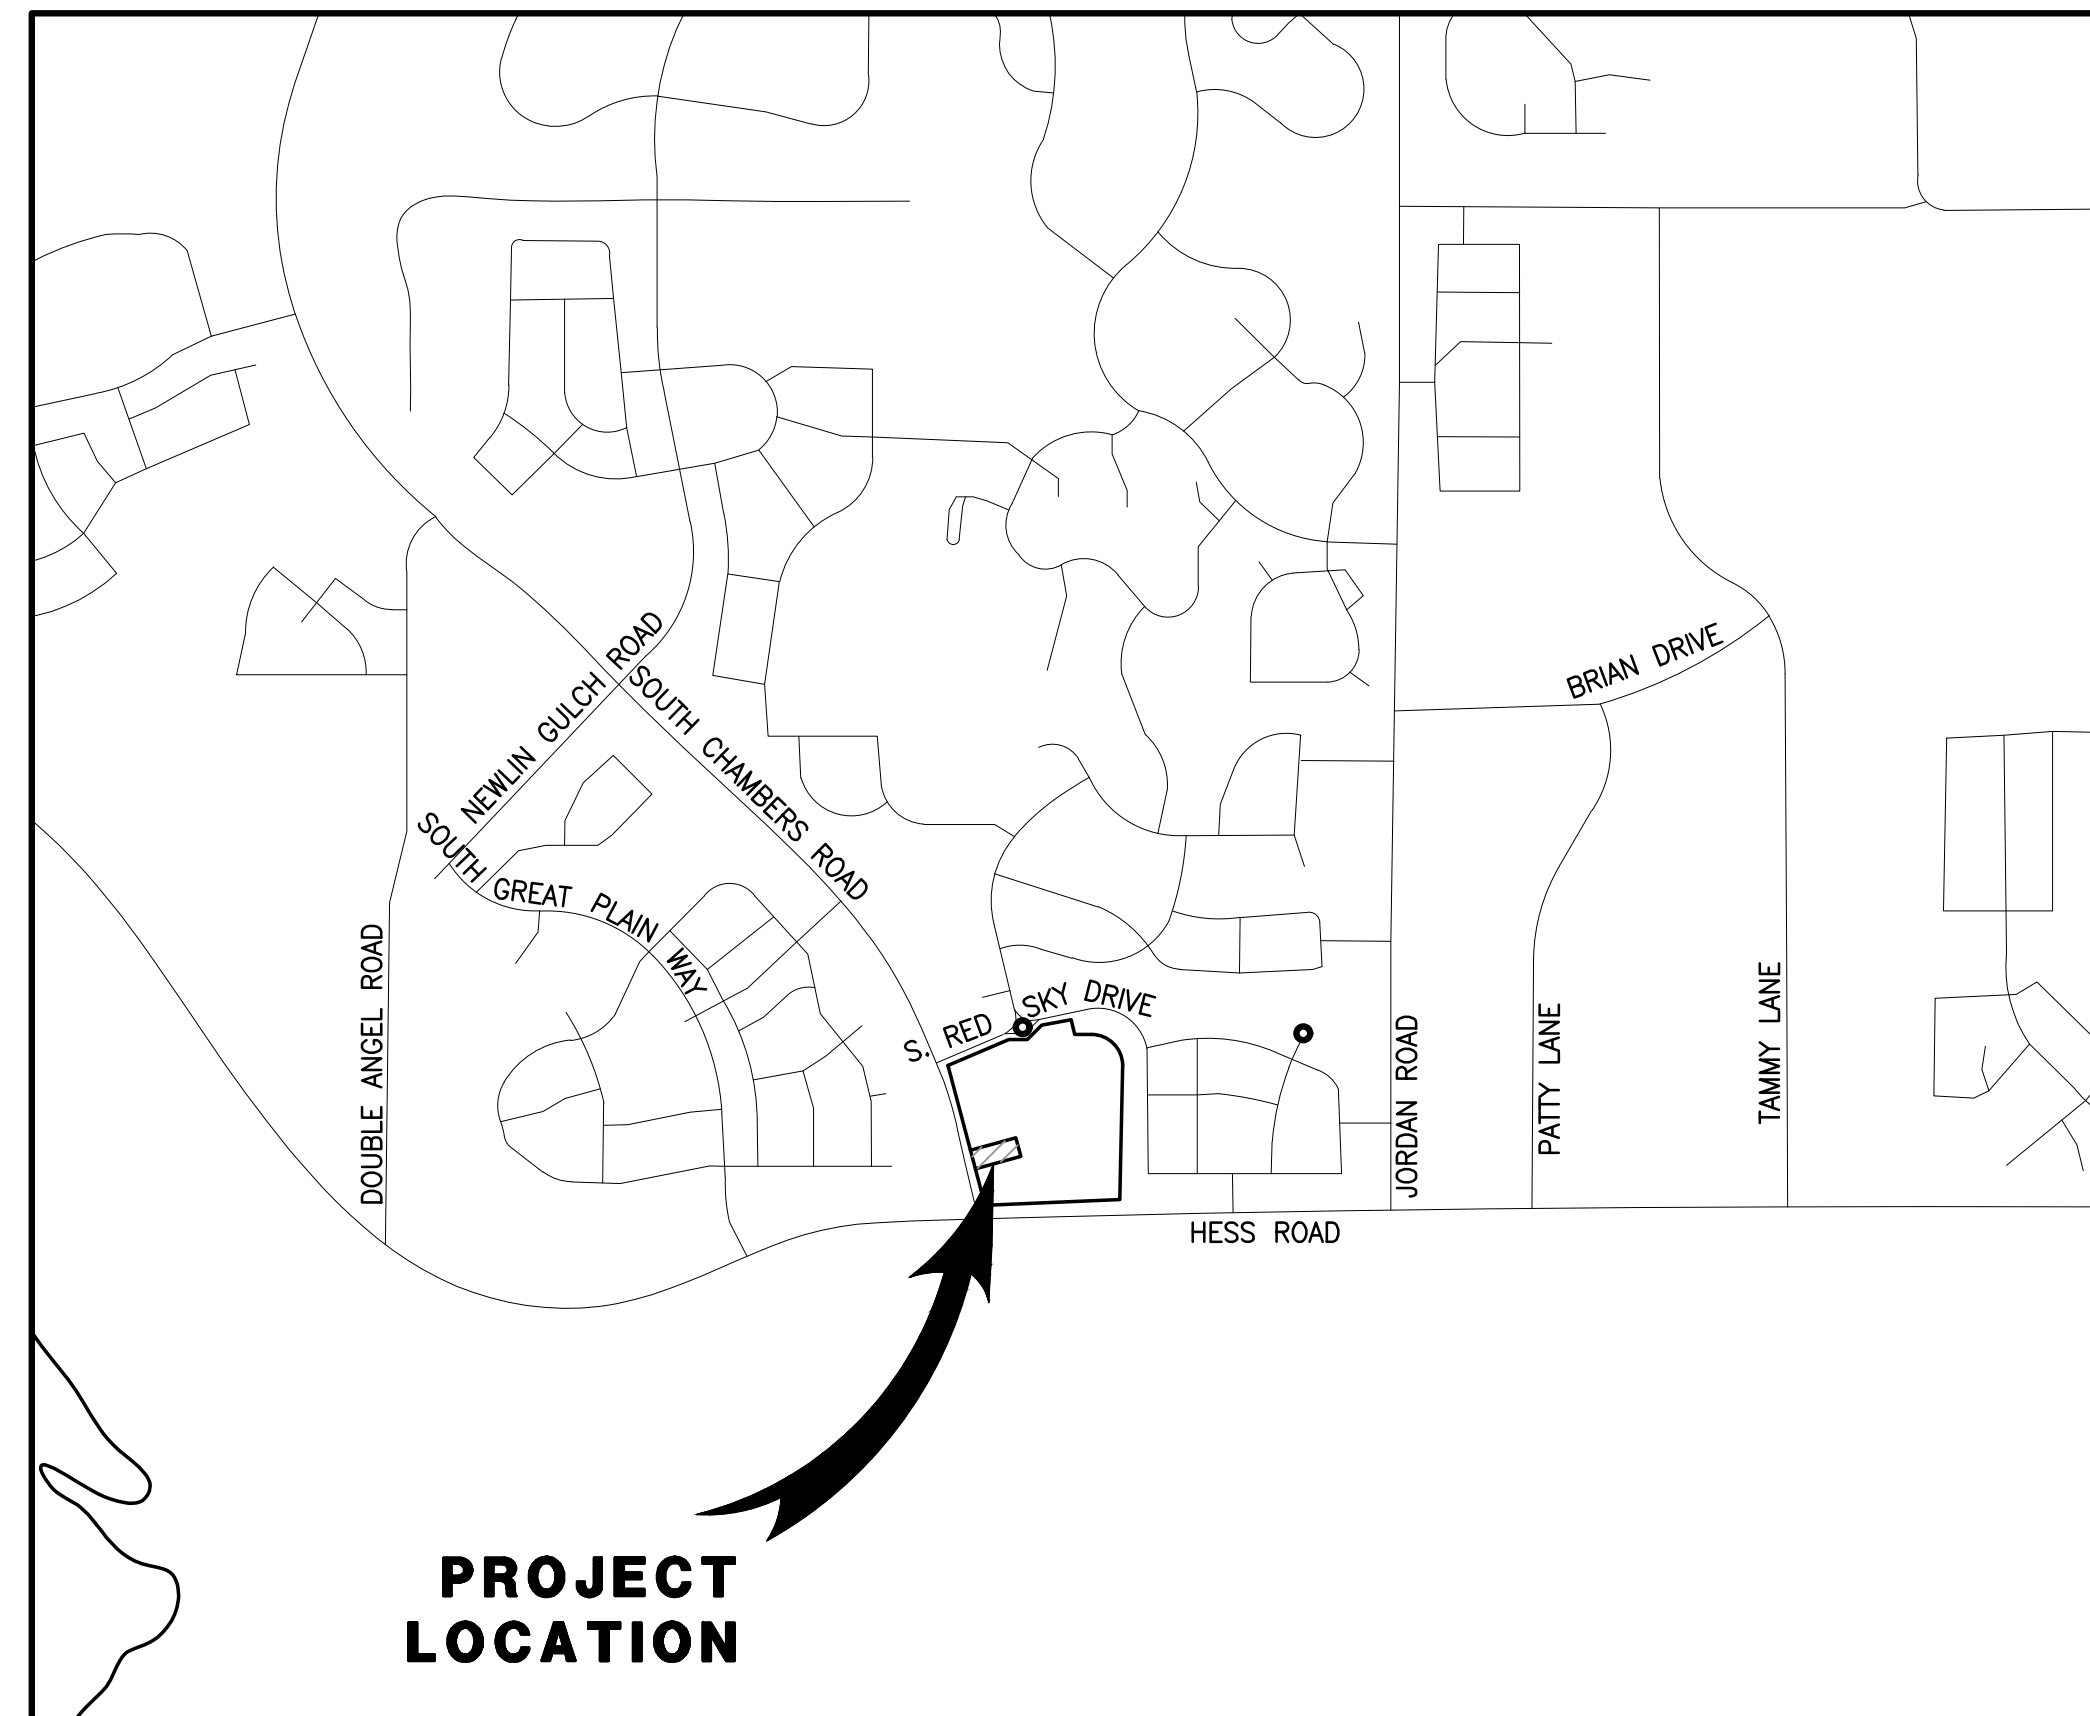

VICINITY MAP

SCALE 1"= 1000'

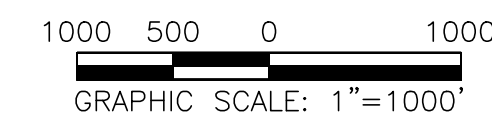

LEGEND

	EXISTING	PROPOSED
PROPERTY BOUNDARY	---	---
PROPERTY LINE	---	---
RIGHT-OF-WAY	---	---
CENTERLINE	---	---
CURB	---	---
CURB & GUTTER	---	---
EASEMENT	---	---
CONTOURS	---	---
WATER LINE	W	W
SANITARY SEWER LINE	S	S
STORM DRAIN LINE	---	---
GAS LINE	G	G
ELECTRIC LINE	E	E
TYPICAL LATERALS	---	---
SANITARY SEWER MANHOLE	(S)	(S)
STORM DRAIN MANHOLE	(D)	(D)
STORM DRAIN INLET	---	---
FIRE HYDRANT	---	---
AC PAVING	---	---
CONCRETE	---	---
LANDSCAPE	---	---

ABBREVIATIONS

BLDG	BUILDING
CL	CENTERLINE
DIA.	DIAMETER
DIST.	DISTRICT
E	EASTING
EG	EXISTING GRADE
ESMT	EASEMENT
EX.	EXISTING
FG	FINISHED GRADE
FL	FLOW LINE
FS	FINISHED SURFACE
INV	INVERT
MIN.	MINIMUM
N	NORTHING
NLA	NET LEASABLE AREA
NO.	NUMBER
PL	PROPERTY LINE
PROP.	PROPOSED
PVC	POLYVINYL CHLORIDE PIPE
RCP	REINFORCED CONCRETE PIPE
R.O.W.	RIGHT OF WAY
REC.	RECEPTION
REQ.	REQUIRED
SAN	SANITARY SEWER
SF	SQUARE FOOT
STD	STANDARD

SITE DATA

PROPERTY ACREAGE	0.901 ACRES (39,244 SF)
PERVIOUS AREA	0.305 ACRES
IMPERVIOUS AREA	0.596 ACRES
MAXIMUM IMPERVIOUS AREA	0.766 ACRES, 85% OF TOTAL LAND AREA
BUILDING DENSITY	1,959 SF (BLDG) = 4.99% 39,244 SF (LOT)
MAX BUILDING DENSITY	NONE
PARKING AREA	3,083 SF
PARKING REQUIRED	18 SPACES/12 SPACES (1 PER 100 NLA/1 PER EACH 3 PERSONS OF RATED CAPACITY)
PARKING PROVIDED	18 ON-SITE SPACES (2 ADA SPACES)
BICYCLE PARKING REQUIRED	4
BICYCLE PARKING PROVIDED	4

LAND USE DATA

EXISTING ZONING	PLANNED DEVELOPMENT
GROSS SITE AREA	0.901 ACRES
NUMBER OF BUILDINGS	1 BUILDING
BUILDING GROSS FLOOR AREA	1,959 SF
NET LEASABLE AREA	1,811 SF
BUILDING OCCUPANCY	35 PEOPLE

REC Response - 11/10/23
Troy Bales - 619-540-6848

SEAL:

8678 CONCORD CENTER DR, UNIT 200
ENGLEWOOD, CO 80112
rickengineering.com
303.537.8020

ENGINEERING COMPANY
San Diego - Riverside - Sacramento - Orange - Tucson - Phoenix - Las Vegas - Denver

PROJECT NO: 2243 | DRAWN/DESIGNED BY: KAJS
DATE: 8/28/2023 | CHECKED BY: JS

DOUGLAS COUNTY, COLORADO

DOUGLAS 234, FILING NO. 6,
AMENDMENT 1, LOT 4

COVER SHEET


811
Know what's below.
Call before you dig.

DRAWING NO.
1

2ND SUBMITTAL


SITE PLAN FOR DUNKIN' DONUTS DOUGLAS 234, FILING NO. 6, AMENDMENT 1, LOT 4

A PORTION OF THE SOUTHWEST QUARTER OF THE SOUTHEAST QUARTER OF SECTION 29,
TOWNSHIP 6 SOUTH, RANGE 66 WEST, 6TH PRINCIPAL MERIDIAN,
TOWN OF PARKER, COUNTY OF DOUGLAS, STATE OF COLORADO
0.901 ACRES, 1 COMMERCIAL LOT

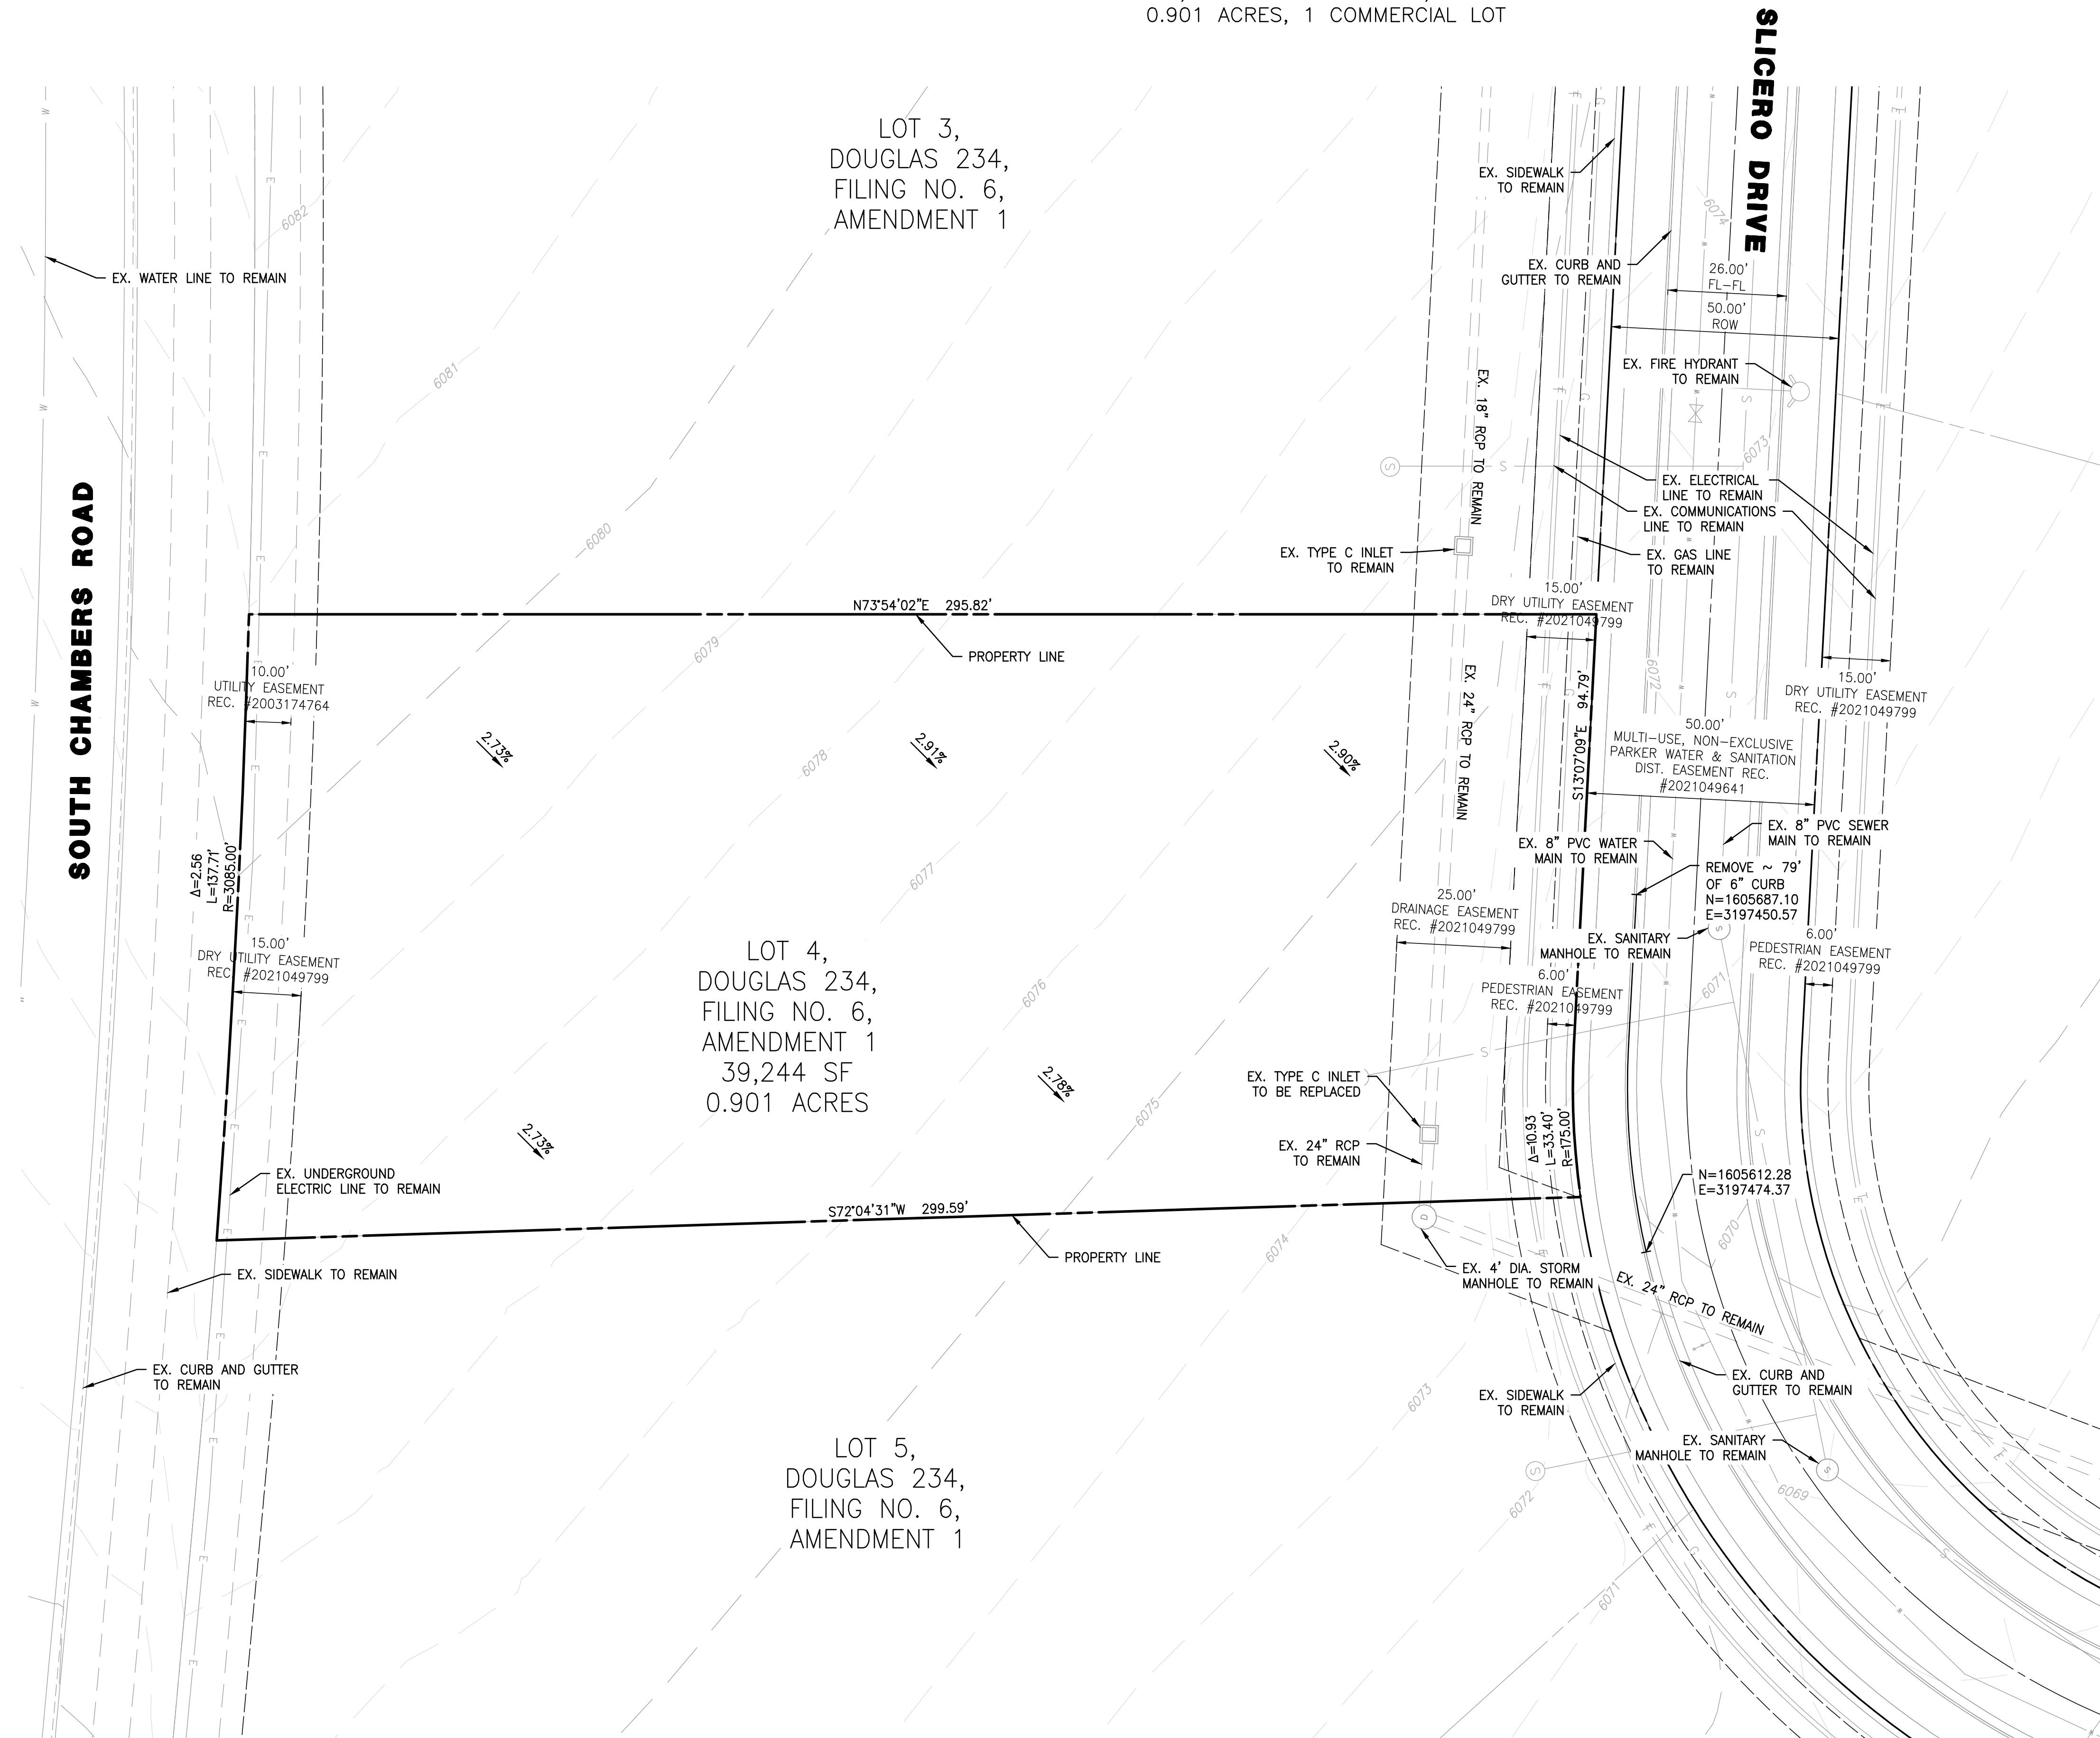

NOTES

1. ALL EXISTING UTILITIES ARE TO REMAIN UNLESS OTHERWISE NOTED.
2. ALL EXISTING IMPROVEMENTS TO BE PROTECTED IN PLACE, UNLESS SPECIFICALLY CALLED AS "TO BE REMOVED".

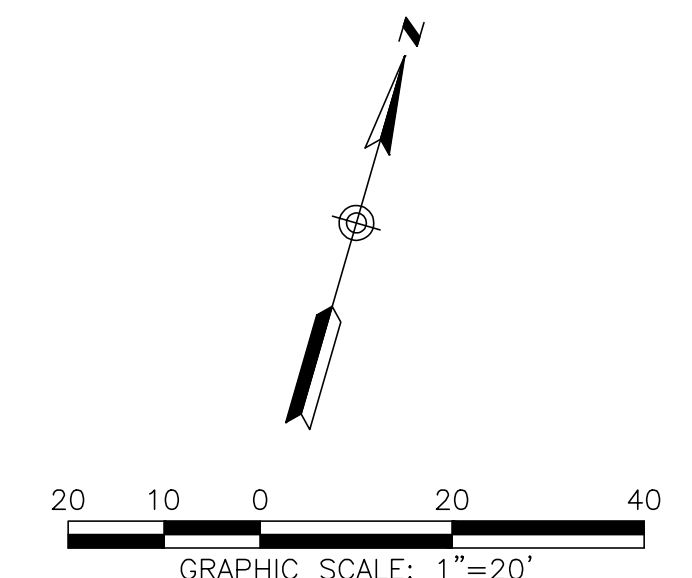


<p>SEAL:</p> <div style="text-align: center;"> <p>RICK ENGINEERING COMPANY</p> <p>8678 CONCORD CENTER DR, UNIT 200 ENGLEWOOD, CO 80112 303.537.8020 rickengineering.com</p> <p>San Diego - Riverside - Sacramento - Orange - Turson - Phoenix - Las Vegas - Denver</p> </div> <p>PROJECT NO: 2243 DRAWN/DESIGNED BY: KA/JS DATE: 8/24/2023 CHECKED BY: JS</p>	<p>SITE PLAN PREPARED FOR:</p> <p style="text-align: center;">DOUGLAS 234, FILING NO. 6, AMENDMENT 1, LOT 4</p> <p style="text-align: center;">DOUGLAS COUNTY, COLORADO</p> <p style="text-align: center;">EXISTING CONDITIONS & DEMOLITION PLAN</p> <div style="text-align: center;"> <p>Know what's below. Call before you dig.</p> </div> <p>DRAWING NO. 2</p>
<p>DOUGLAS 234, FILING NO. 6, AMENDMENT 1, LOT 4</p> <p>0.901 ACRES</p>	<p>DOUGLAS 234, FILING NO. 6, AMENDMENT 1, LOT 4</p> <p>39,244 SF</p>

C:\RICK\Projects\022000\2243_DunkinDonuts\Civil\Plans\Site Plan\2243-C-DEM001.dwg - plotted by: kalazard on 2023-08-24 @ 08:32 - c:\birec_ncs.ctb - © 2022 Rick Engineering Company

2ND SUBMITTAL

SITE PLAN FOR DUNKIN' DONUTS DOUGLAS 234, FILING NO. 6, AMENDMENT 1, LOT 4

A PORTION OF THE SOUTHWEST QUARTER OF THE SOUTHEAST QUARTER OF SECTION 29,
TOWNSHIP 6 SOUTH, RANGE 66 WEST, 6TH PRINCIPAL MERIDIAN,
TOWN OF PARKER, COUNTY OF DOUGLAS, STATE OF COLORADO
0.901 ACRES, 1 COMMERCIAL LOT

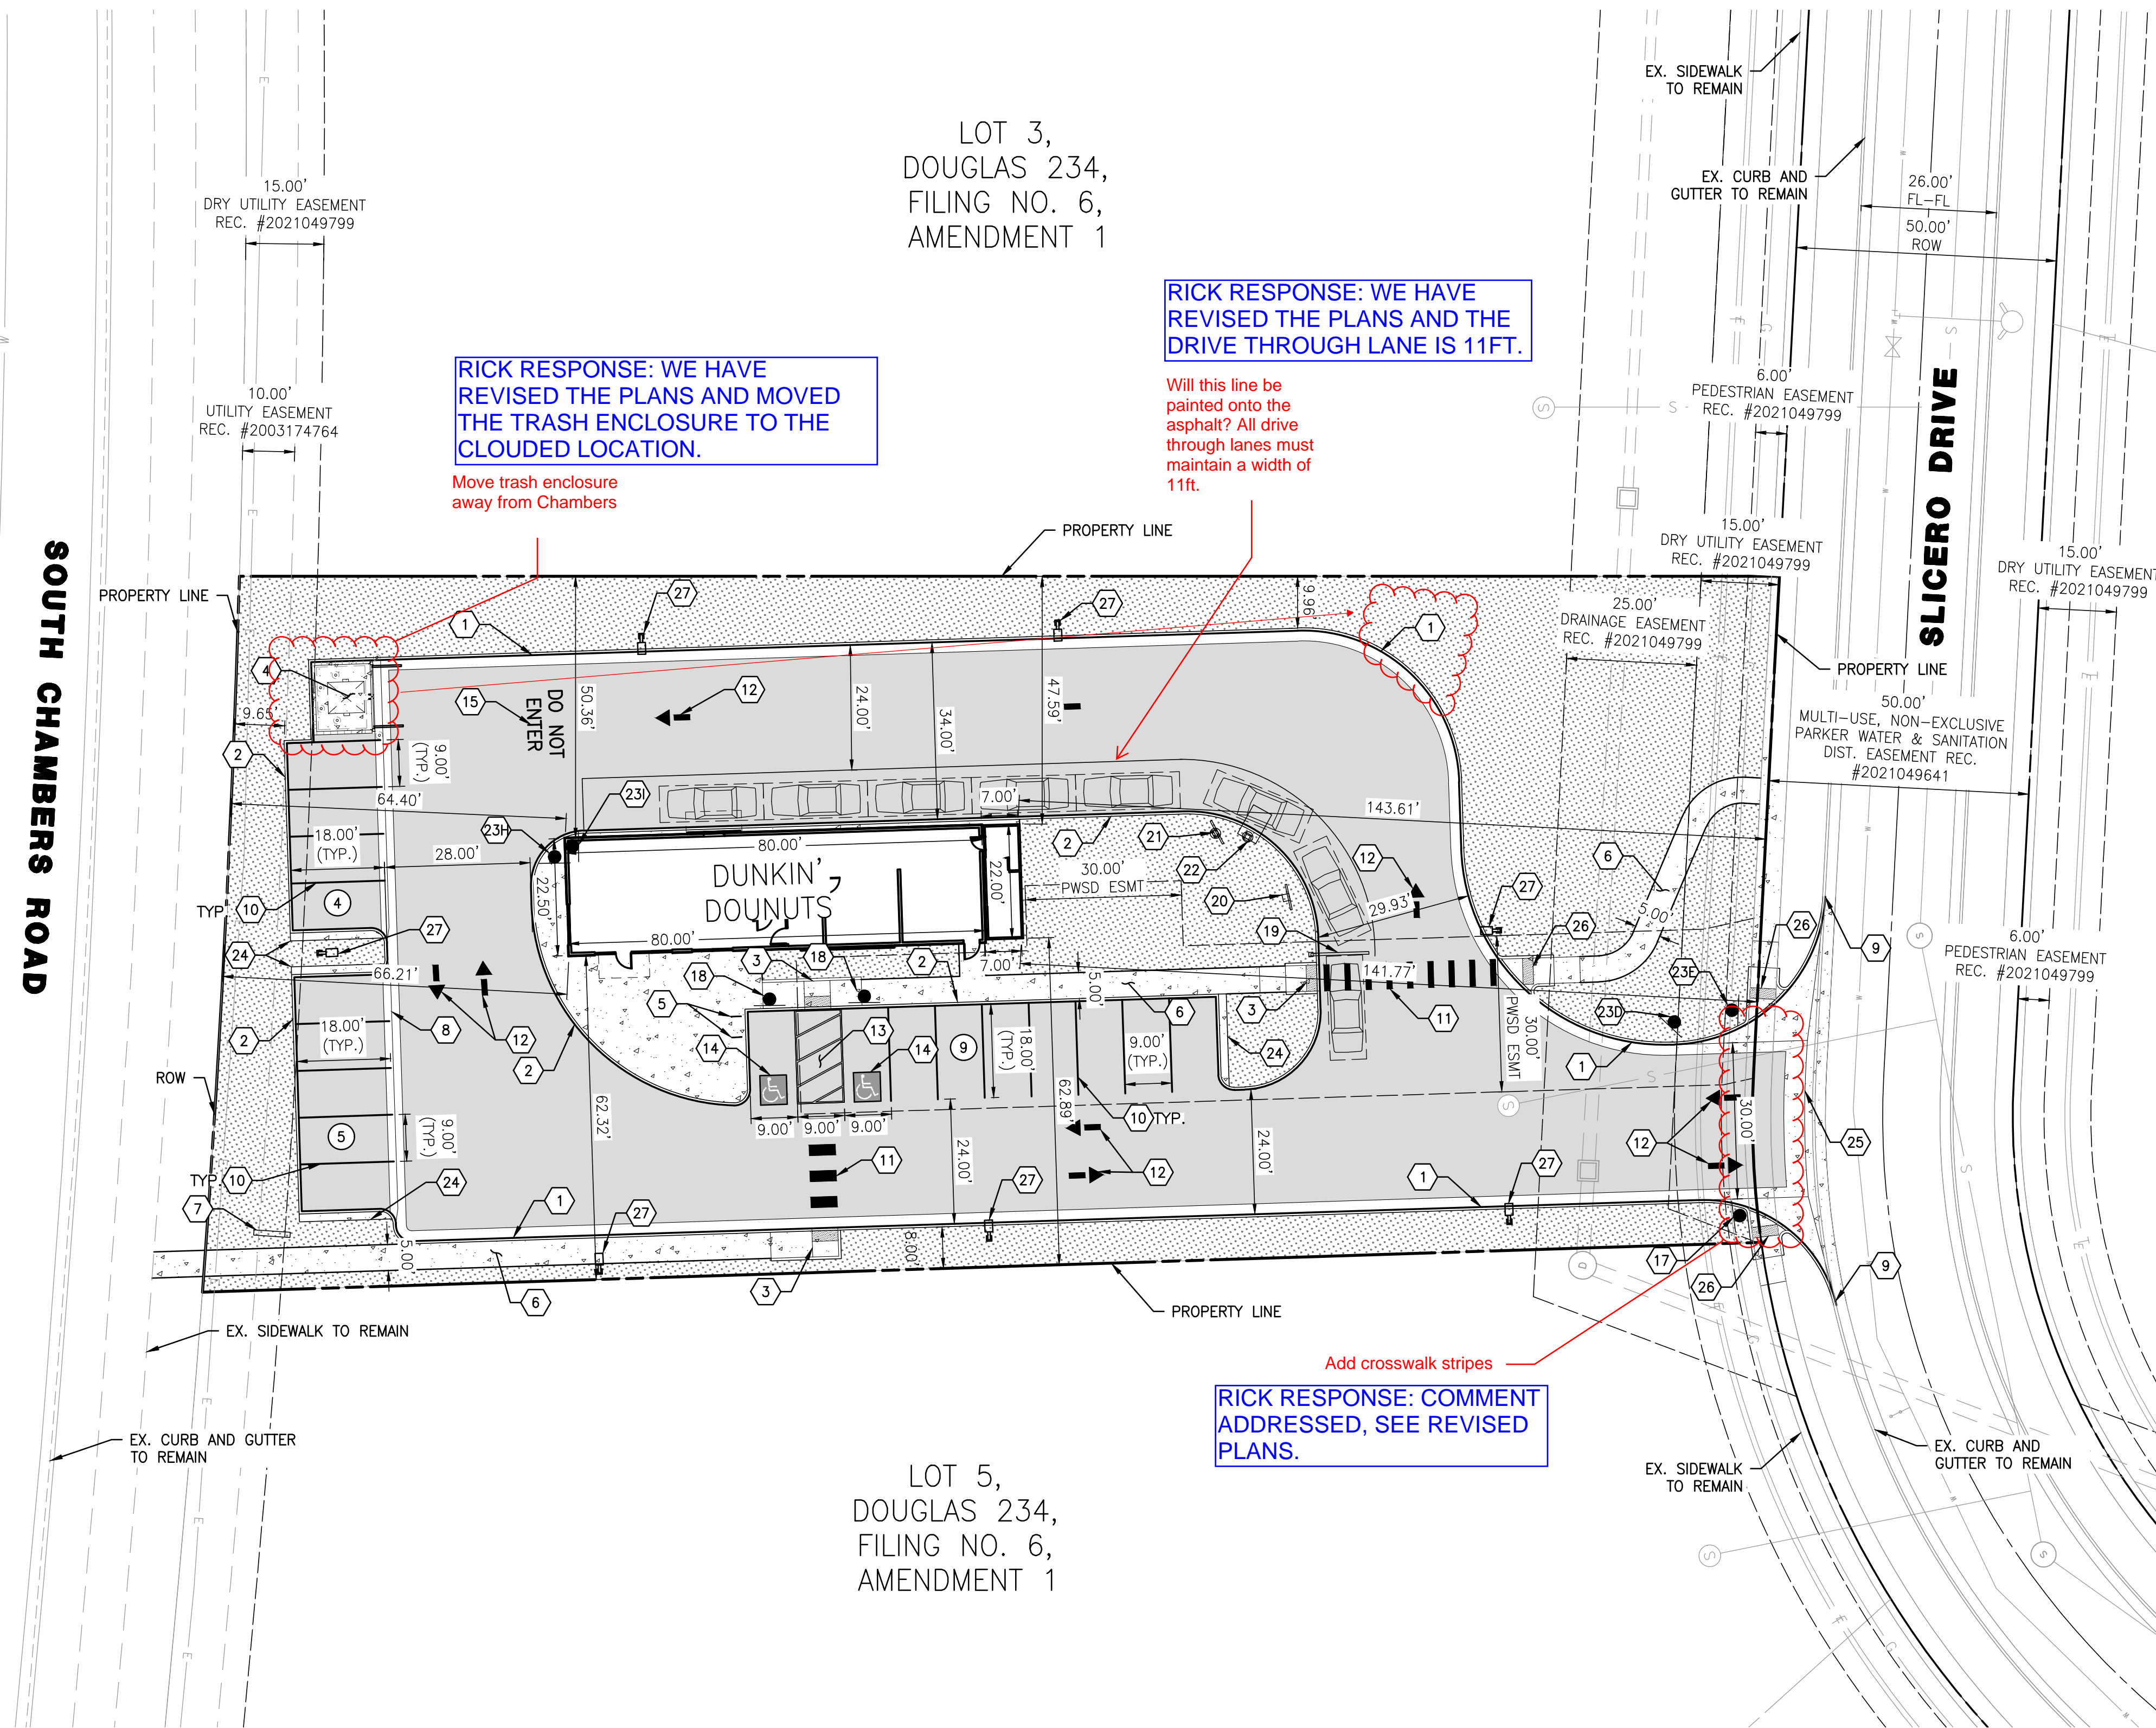

RICK RESPONSE: WE HAVE REVISED THE PLANS AND MOVED THE TRASH ENCLOSURE TO THE CLOUDED LOCATION.

Move trash enclosure away from Chambers

RICK RESPONSE: WE HAVE REVISED THE PLANS AND THE DRIVE THROUGH LANE IS 11FT.

Will this line be painted onto the asphalt? All drive through lanes must maintain a width of 11ft.

RICK RESPONSE: COMMENT ADDRESSED, SEE REVISED PLANS.

Add crosswalk stripes

LEGEND


- PROPERTY LINE
- RIGHT-OF-WAY CENTERLINE
- EASEMENT
- AC PAVING
- CONCRETE
- LANDSCAPE

Correct the legend to match what is shown on the plan

RICK RESPONSE: WE HAVE REVISED THE PLANS TO SHOW THE LANDSCAPE HATCH.

CONSTRUCTION NOTES

- 1 PROPOSED VERTICAL CURB AND GUTTER
- 2 PROPOSED CURB TYPE 2 (SECTION B) 6" BARRIER
- 3 PROPOSED MIDBLOCK CURB RAMP
- 4 PROPOSED TRASH ENCLOSURE PROPOSED
- 5 BIKE PARKING (4 SPACES)
- 6 PROPOSED SIDEWALK
- 7 PROPOSED MONUMENT SIGN (ALL SIGNS ARE REVIEWED UNDER SEPARATE PERMIT)
- 8 3' GUTTER TYPE 2
- 9 TIE INTO EXISTING
- 10 4" WIDE, WHITE PARKING SPACE MARKING
- 11 WHITE CROSSWALK MARKINGS
- 12 DIRECTIONAL ARROW
- 13 4" WIDE, WHITE, SOLID DIAGONAL MARKINGS AT 5' SPACING ANGLED AT 30 DEGREES
- 14 INTERNATIONAL SYMBOL OF ACCESSIBILITY PARKING SPACE MARKING
- 15 "DO NOT ENTER" PAVEMENT LEGEND
- 16 "NO PARKING" PAVEMENT LEGEND
- 17 R1-1 SIGN
- 18 "HANDICAP PARKING ONLY" SIGN AND "VAN ACCESSIBLE" SIGN
- 19 SINGLE VEHICLE CLEARANCE BAR
- 20 DIGITAL PREVIEW BOARD
- 21 DIGITAL MENU BOARD
- 22 ORDER CANOPY
- 23 DIRECTIONAL SIGN
- 24 PROPOSED 18" CONCRETE LANDING
- 25 PROPOSED 8" CROSS PAN
- 26 PROPOSED DIRECTIONAL CURB RAMP
- 27 PROPOSED LIGHTING

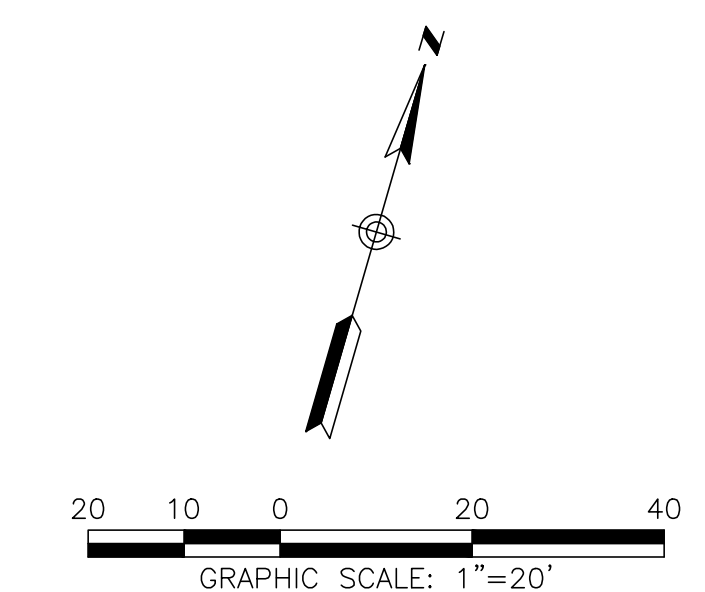

NO.	BY	DATE	REVISION

SEAL:

8678 CONCORD CENTER DR, UNIT 200
ENGLEWOOD, CO 80112
rickengineering.com
303.537.8020

RICK
ENGINEERING COMPANY

San Diego - Riverside - Sacramento - Orange - Tucson - Phoenix - Las Vegas - Denver

PROJECT NO: 2243 DRAWN/DESIGNED BY: KA/JS
DATE: 8/25/2023 CHECKED BY: JS

SITE PLAN PREPARED FOR:
**DOUGLAS 234, FILING NO. 6,
AMENDMENT 1, LOT 4**
DOUGLAS COUNTY, COLORADO

SITE PLAN

811
Know what's below.
Call before you dig.



DRAWING NO. **3**

2ND SUBMITTAL


C:\RICK\Projects\022000\2243_DunkinDonuts\Civil\Plans\Site Plan\2243-C-SF01.dwg - plotted by: kolozard on 2023-08-25 @ 10:24 - c:\birec_msc.ctb - © 2023 Rick Engineering Company

**SITE PLAN FOR
DUNKIN' DONUTS
DOUGLAS 234, FILING NO. 6,
AMENDMENT 1, LOT 4**

A PORTION OF THE SOUTHWEST QUARTER OF THE SOUTHEAST QUARTER OF SECTION 29,
TOWNSHIP 6 SOUTH, RANGE 66 WEST, 6TH PRINCIPAL MERIDIAN,
TOWN OF PARKER, COUNTY OF DOUGLAS, STATE OF COLORADO
0.901 ACRES, 1 COMMERCIAL LOT

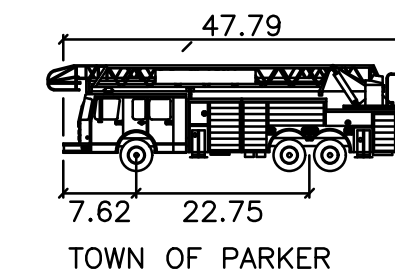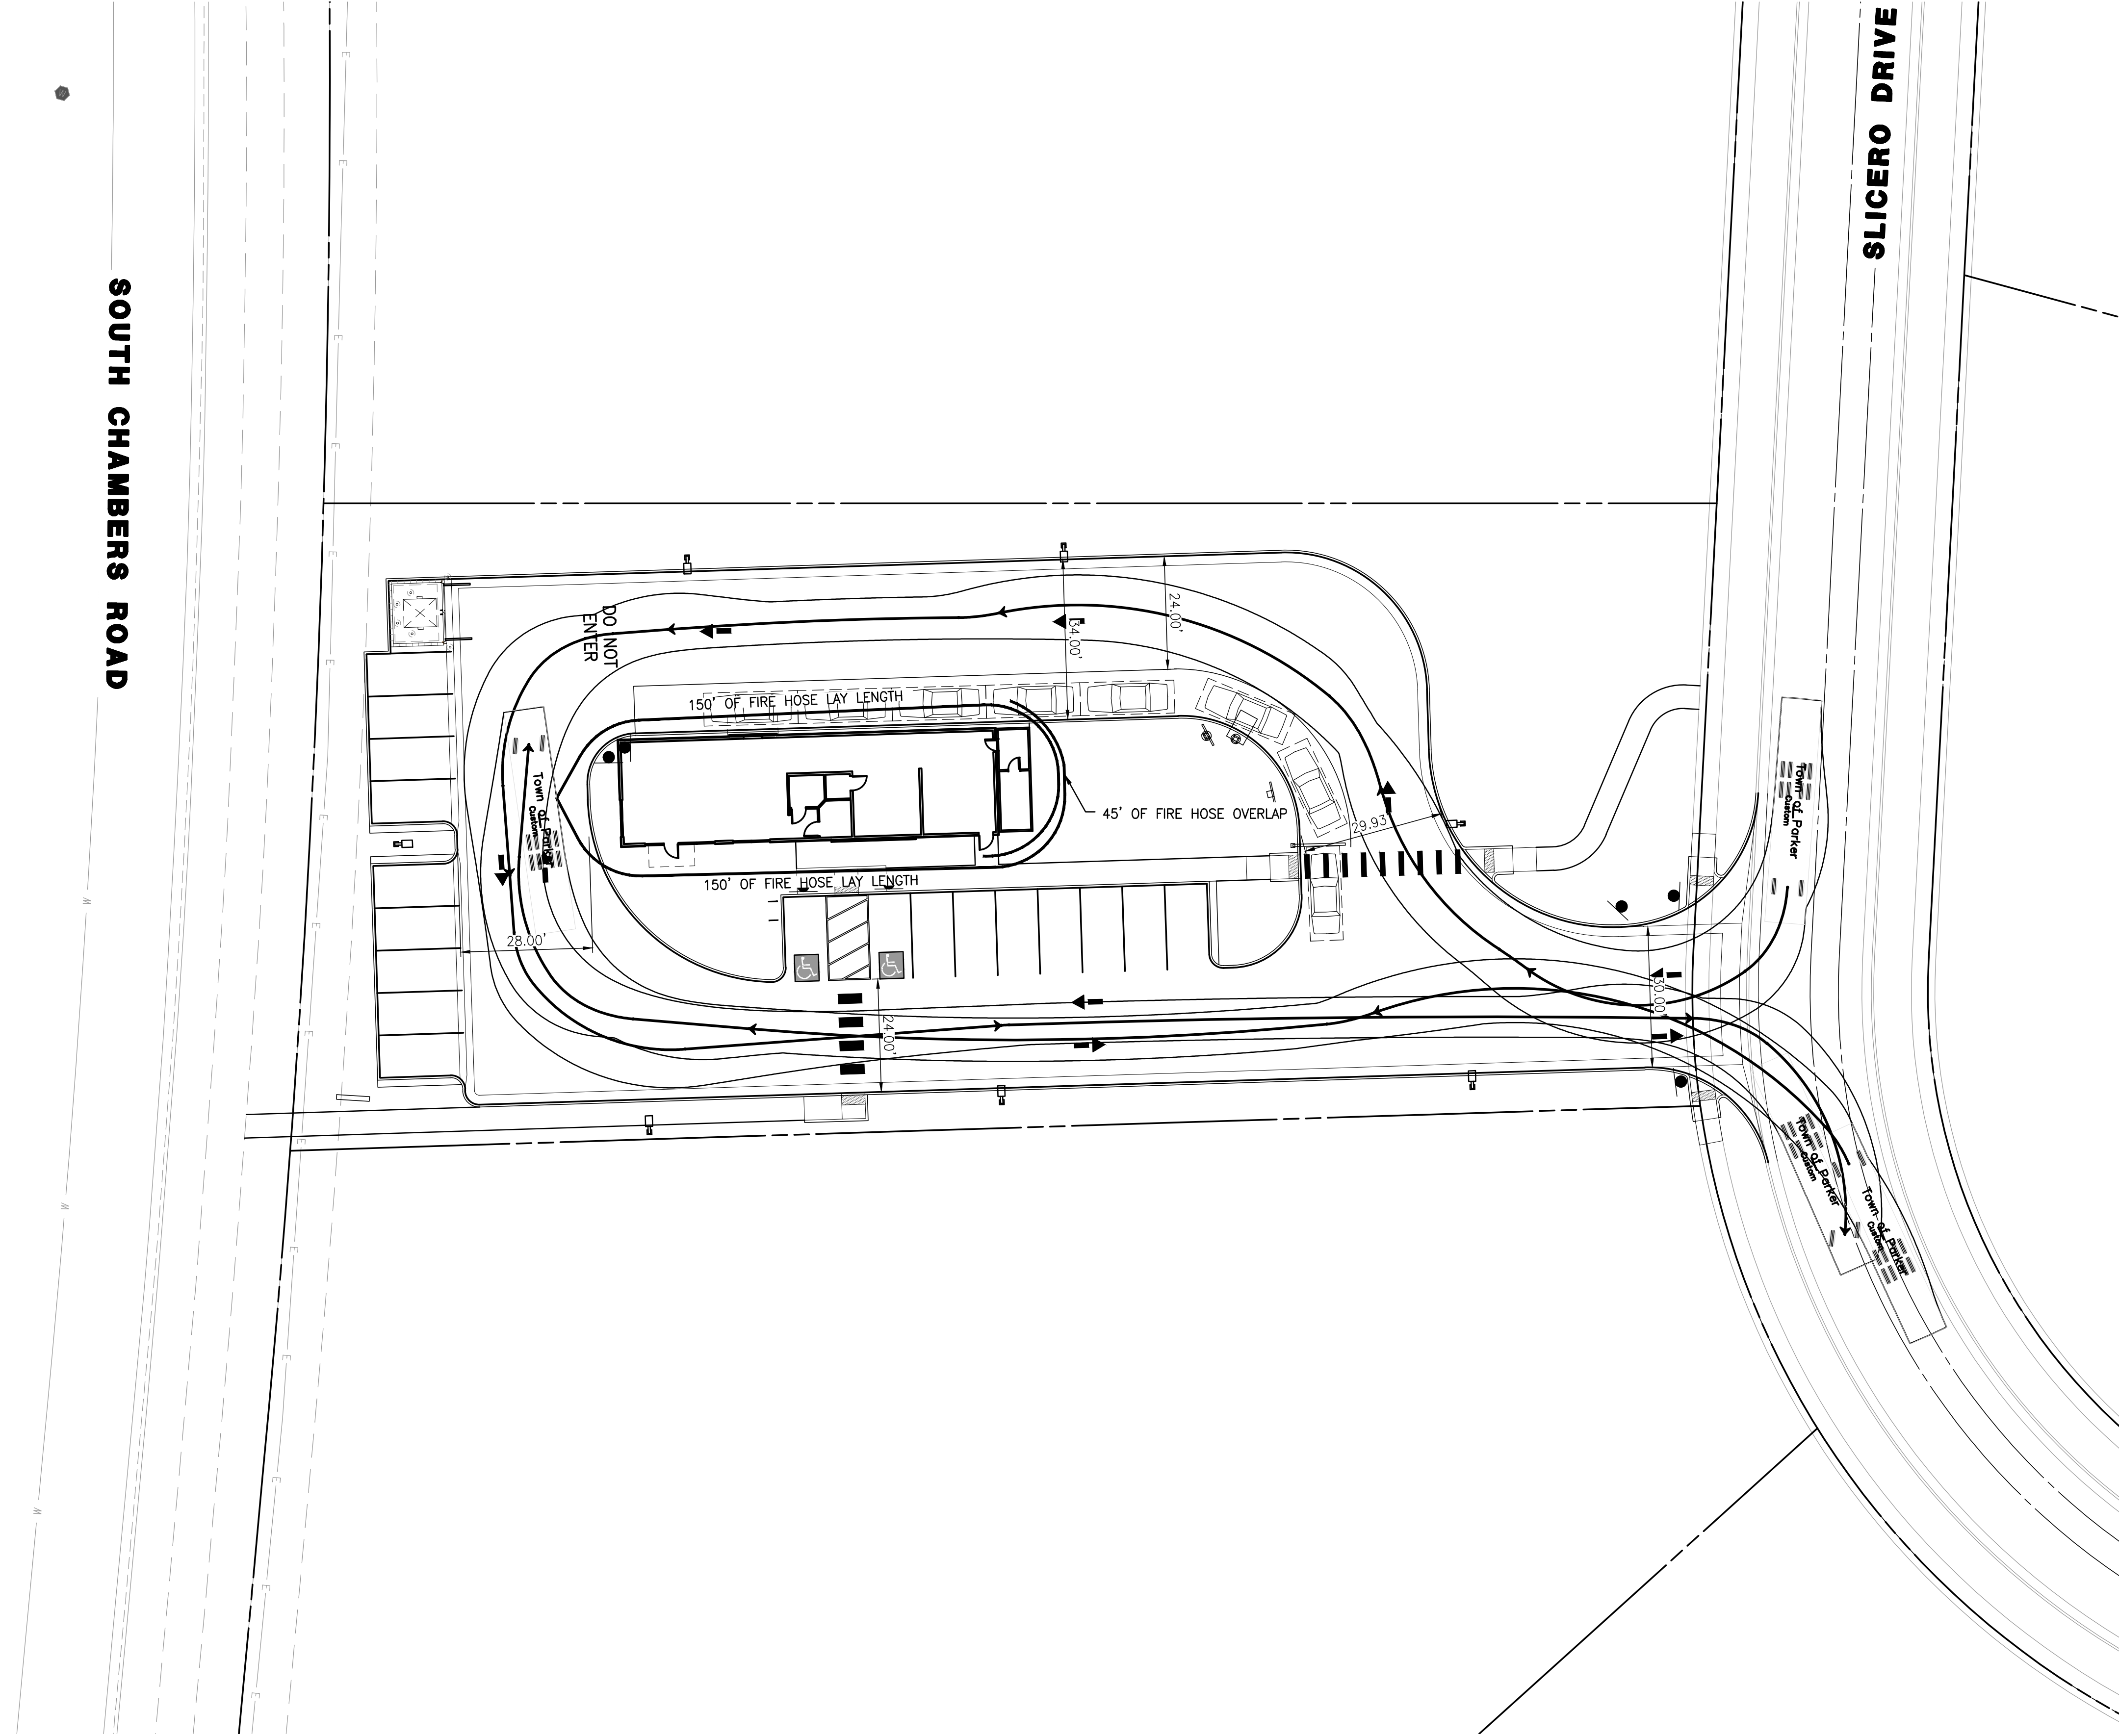

LENGTH: 47.79'
WIDTH: 8.50'
HEIGHT: 10.75'
MIN GROUND CLEARANCE: 1.55'
TRACK WIDTH : 6.92'
LOCK TO LOCK TIME : 5.0sec
WALL TO WALL TURNING RADIUS : 46.67'

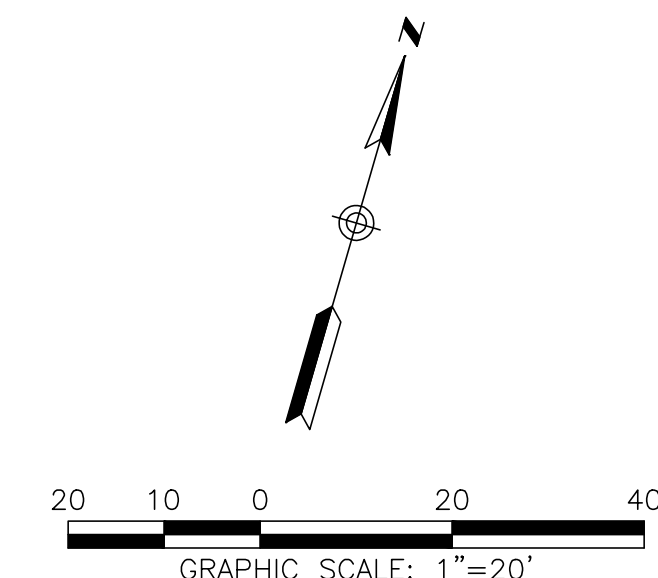

NO.	BY	DATE	REVISION

SEAL:

RICK
ENGINEERING COMPANY
8678 CONCORD CENTER DR, UNIT 200
ENGLEWOOD, CO 80112
rickengineering.com
303.537.8020
San Diego - Riverside - San Luis Obispo - Sacramento - Orange - Tucson - Phoenix - Las Vegas - Denver

PROJECT NO: 2243 | DRAWN/DESIGNED BY: KA/JS
DATE: 8/24/2023 | CHECKED BY: JS

SITE PLAN PREPARED FOR:
**DOUGLAS 234, FILING NO. 6,
AMENDMENT 1, LOT 4**
DOUGLAS COUNTY, COLORADO

FIRE TRUCK ACCESS PLAN

DRAWING NO.
5


C:\RICK\Projects\022000\2243_DunkinDonuts\Civil\Plansets\Site Plan\2243-C-AUTOTURN01.dwg - plotted by: kalezard on 2023-08-24 @ 16:47 - c:\brec_nca.ctb - © 2022 Rick Engineering Company

2ND SUBMITTAL


SITE PLAN FOR DUNKIN' DONUTS DOUGLAS 234, FILING NO. 6, AMENDMENT 1, LOT 4

A PORTION OF THE SOUTHWEST QUARTER OF THE SOUTHEAST QUARTER OF SE
TOWNSHIP 6 SOUTH, RANGE 66 WEST, 6TH PRINCIPAL MERIDIAN,
TOWN OF PARKER, COUNTY OF DOUGLAS, STATE OF COLORADO
0.901 ACRES, 1 COMMERCIAL LOT


TOWN OF PARKER PLANTING STANDARDS

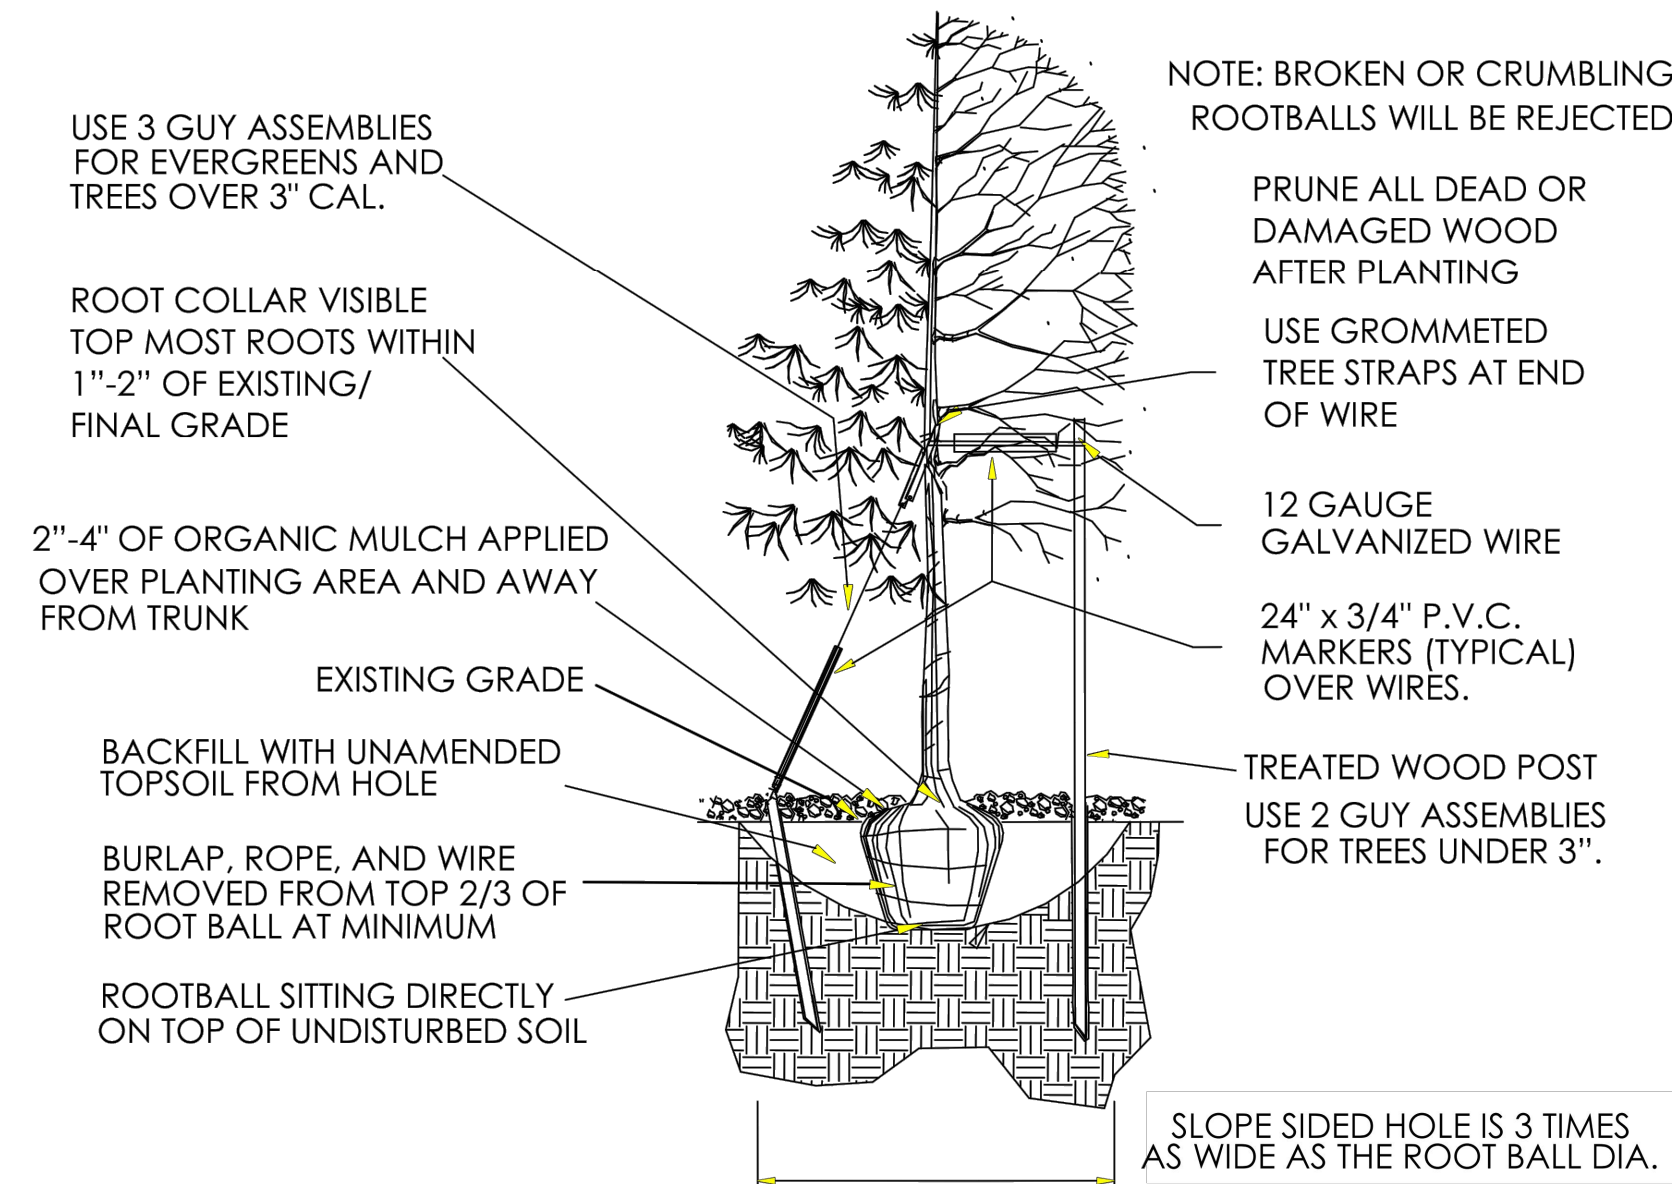


A TREE PLANTING
SCALE: N.T.S.

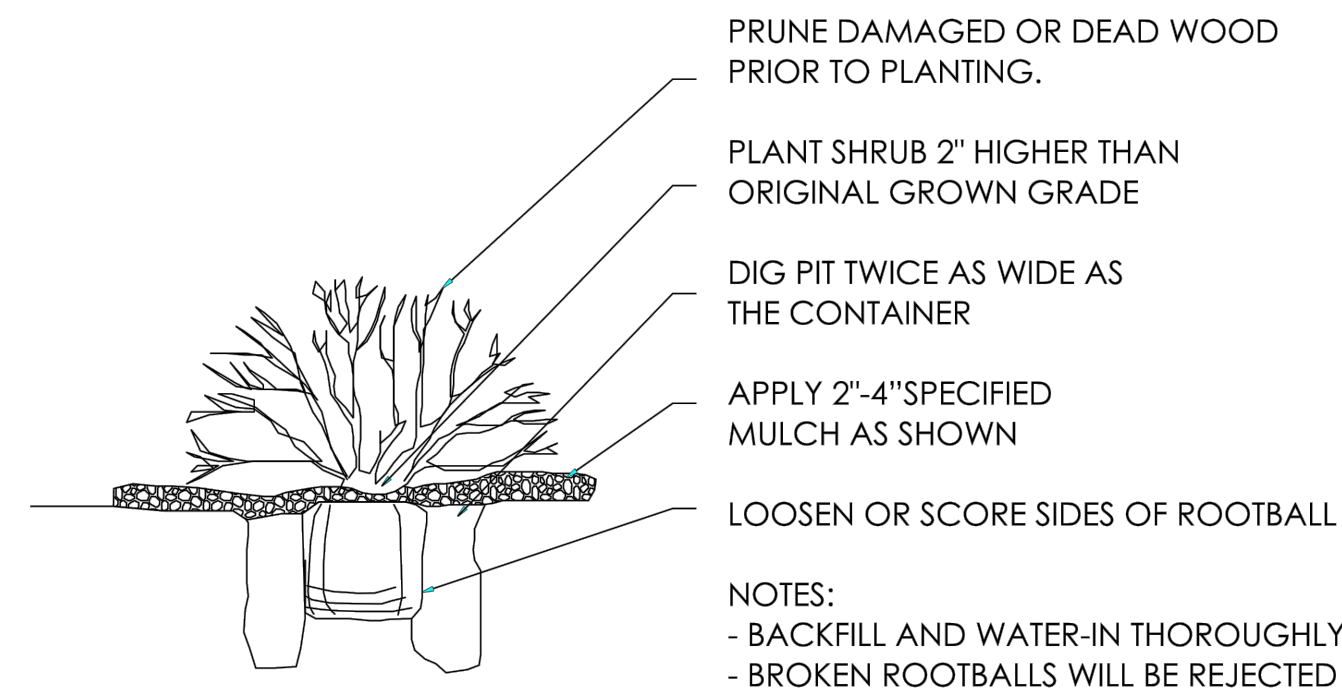

B SHRUB PLANTING
SCALE: N.T.S.

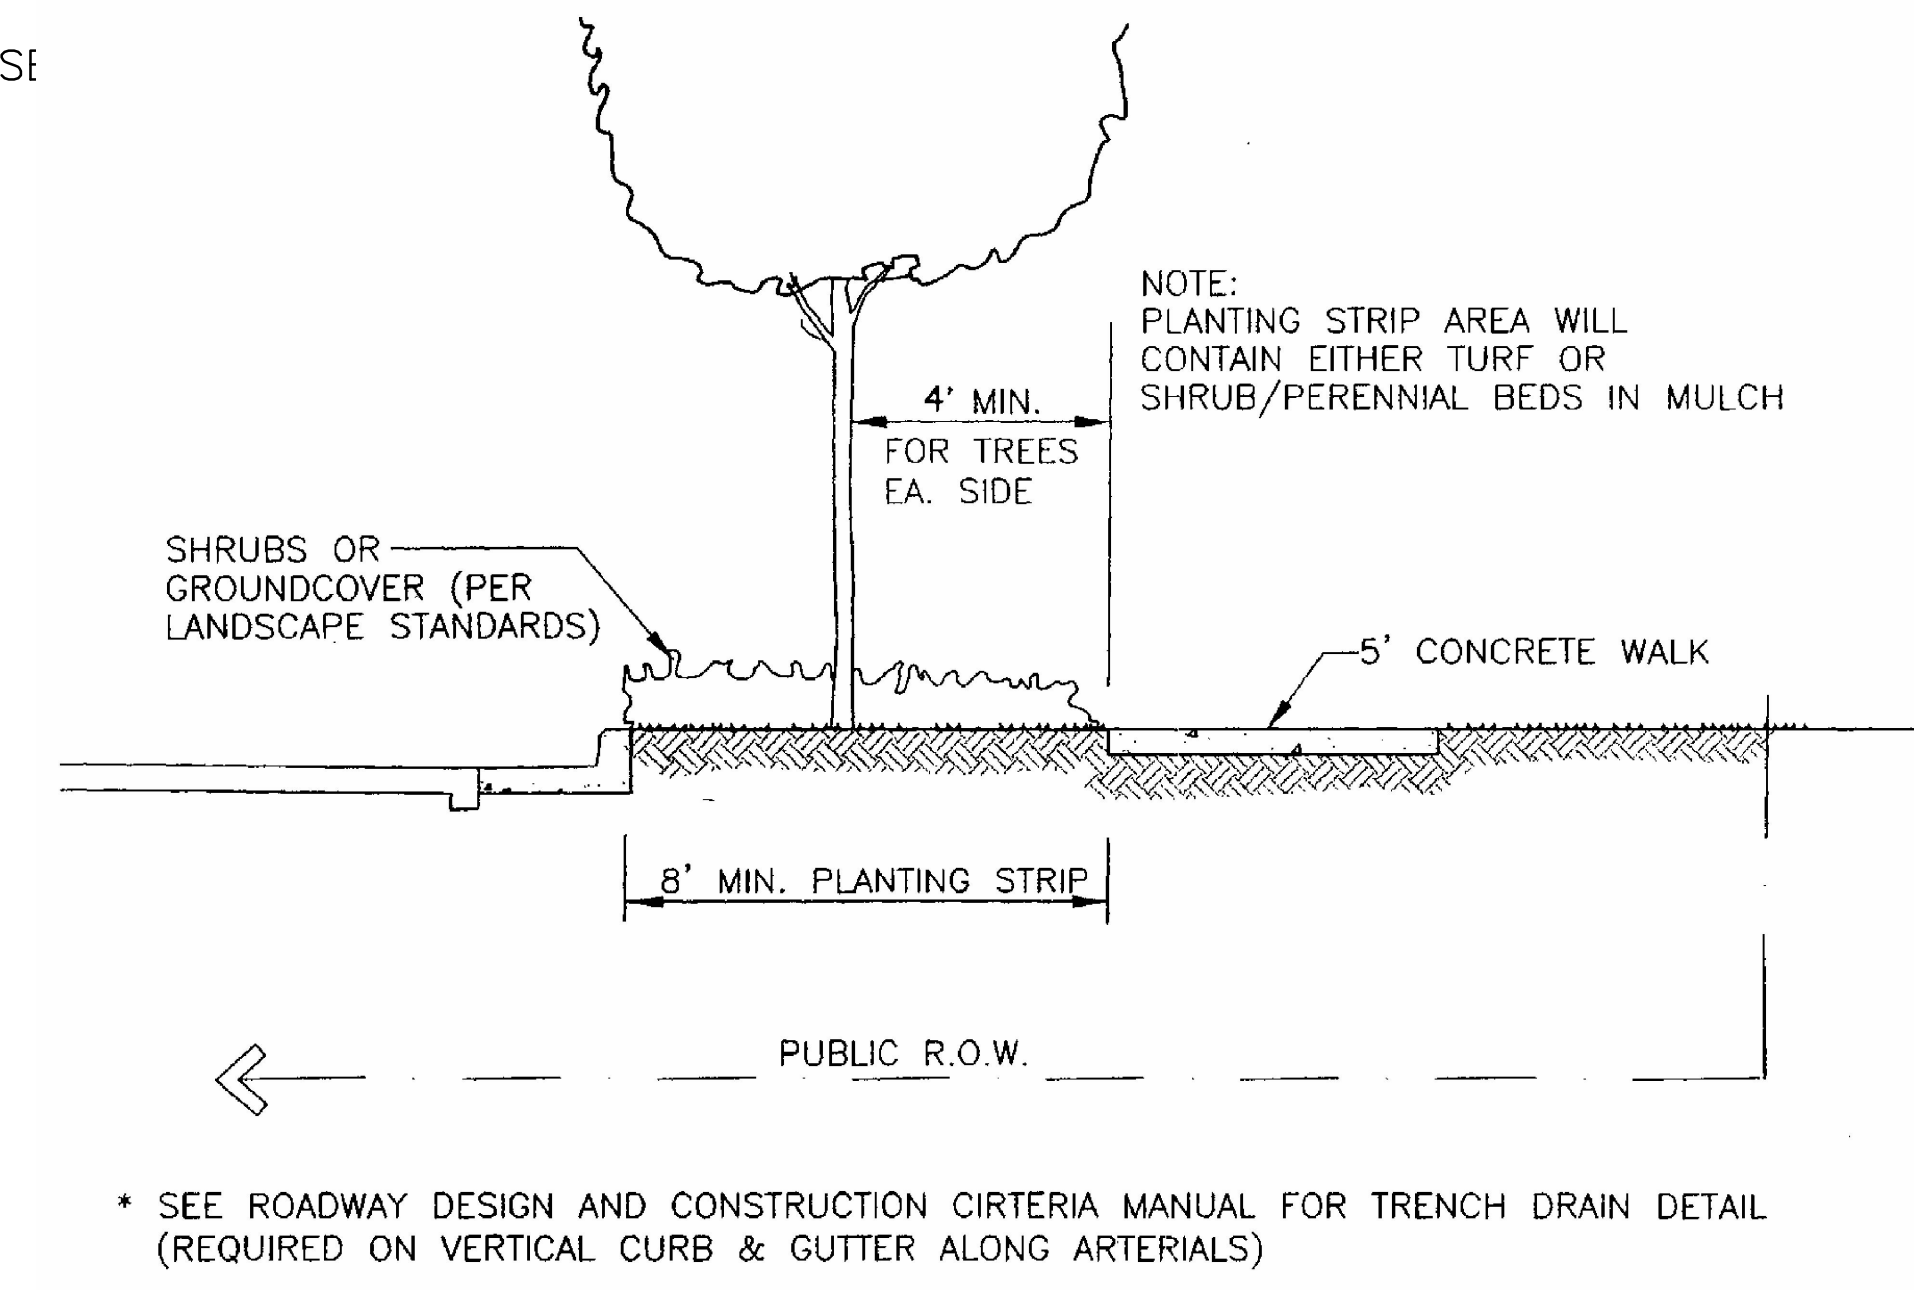


C STREET SECTION WITH DETACHED WALK
SCALE: N.T.S.

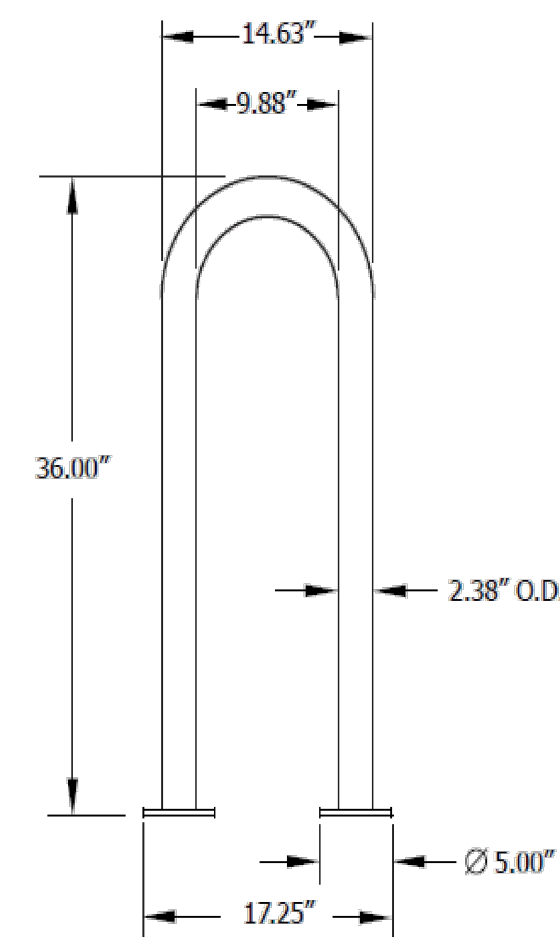


D BIKE RACK
SCALE: N.T.S.

STIDESTEET 1-LOOP RACK,
SURFACE MOUNT
MANUFACTURER: ANOVA
MODEL NUMBER: LBR3PSURF
COLOR: TEXTURED BRONZE
DIMENSIONS: 36"H x 17"W

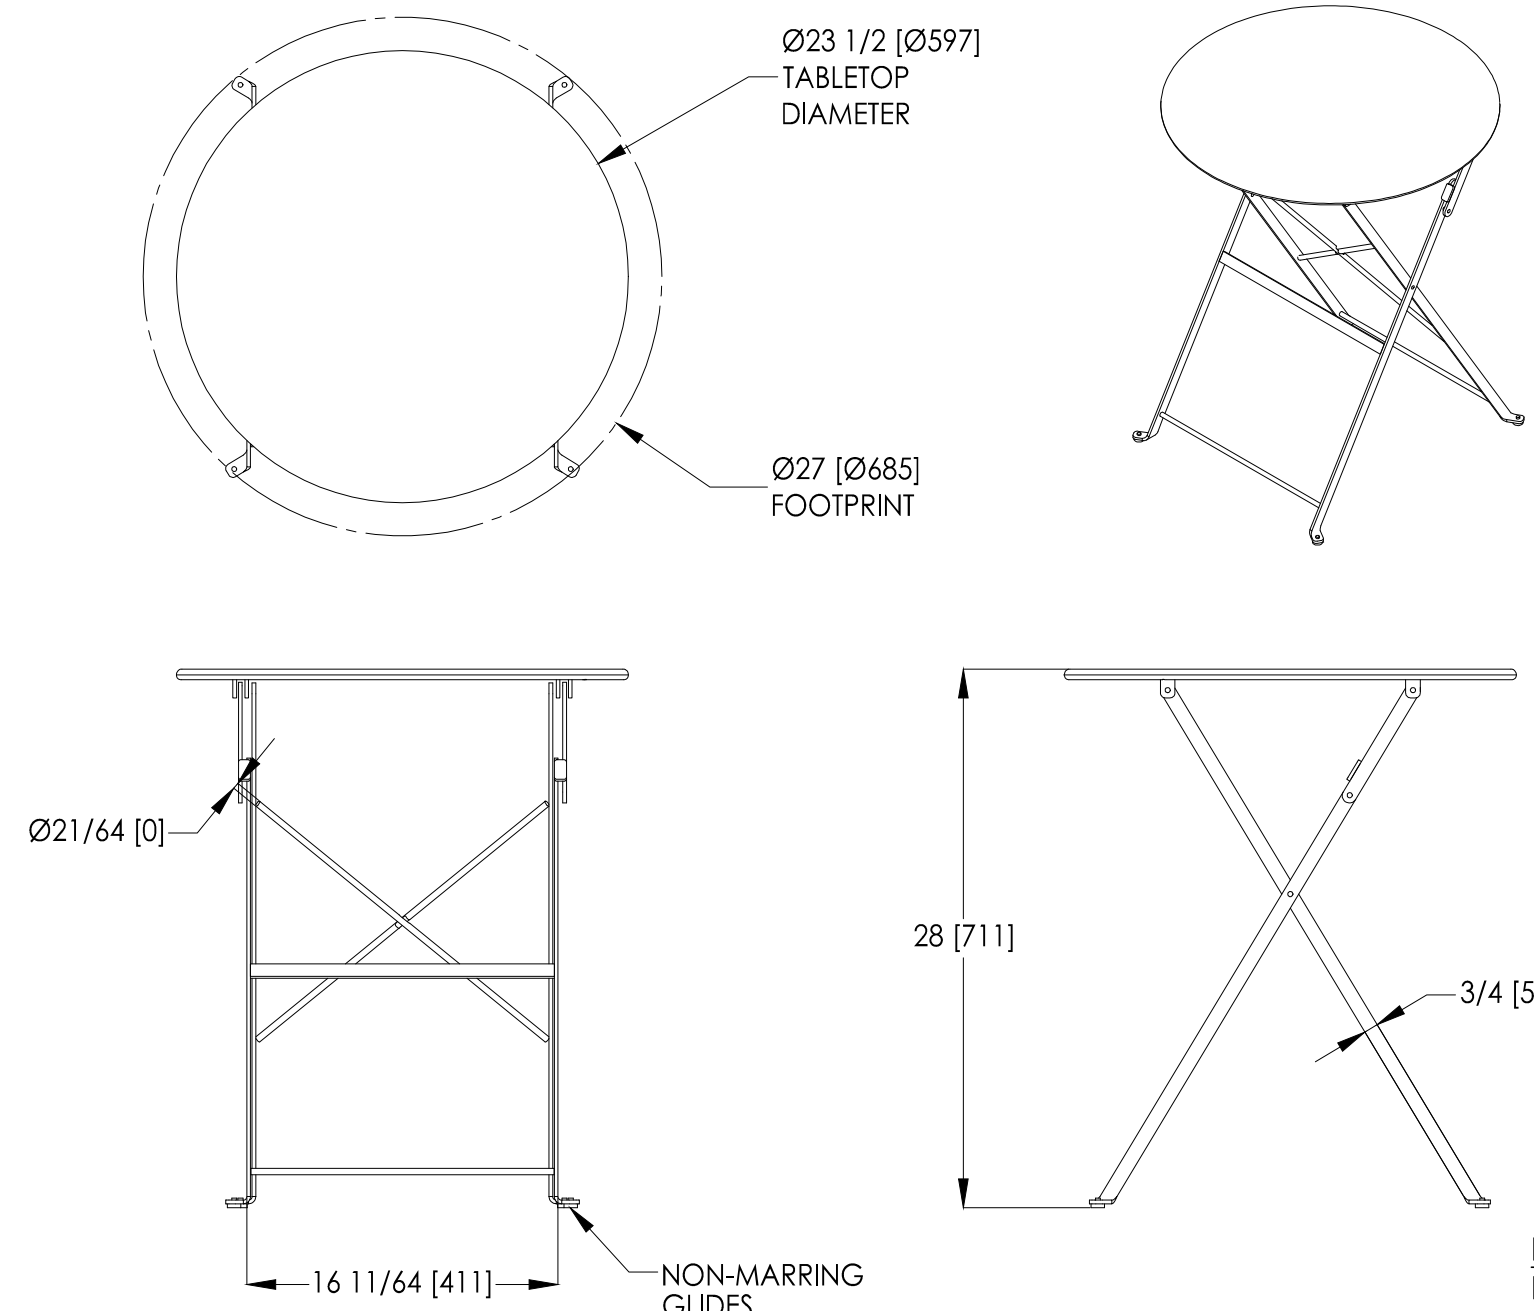


E PATIO TABLES
SCALE: N.T.S.

BRAVO BISTRO TABLE
MANUFACTURER: LANDSCAPE FORMS
MODEL NUMBER: CS201-01
COLOR: CADMIUM
CONTACT: 1.800.521.2546

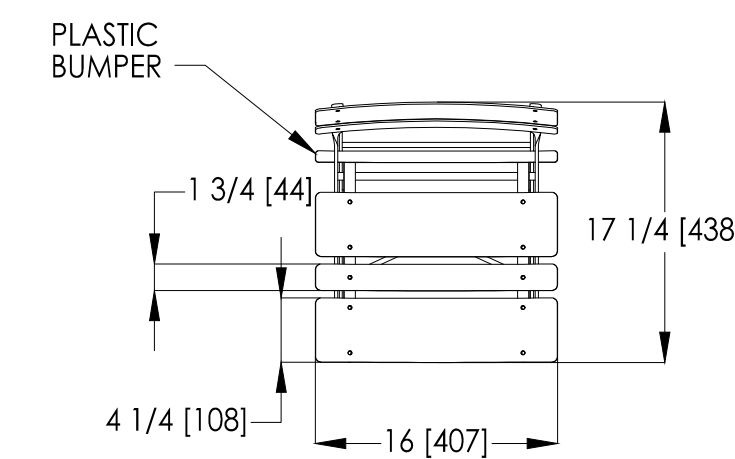

F PATIO CHAIRS
SCALE: N.T.S.

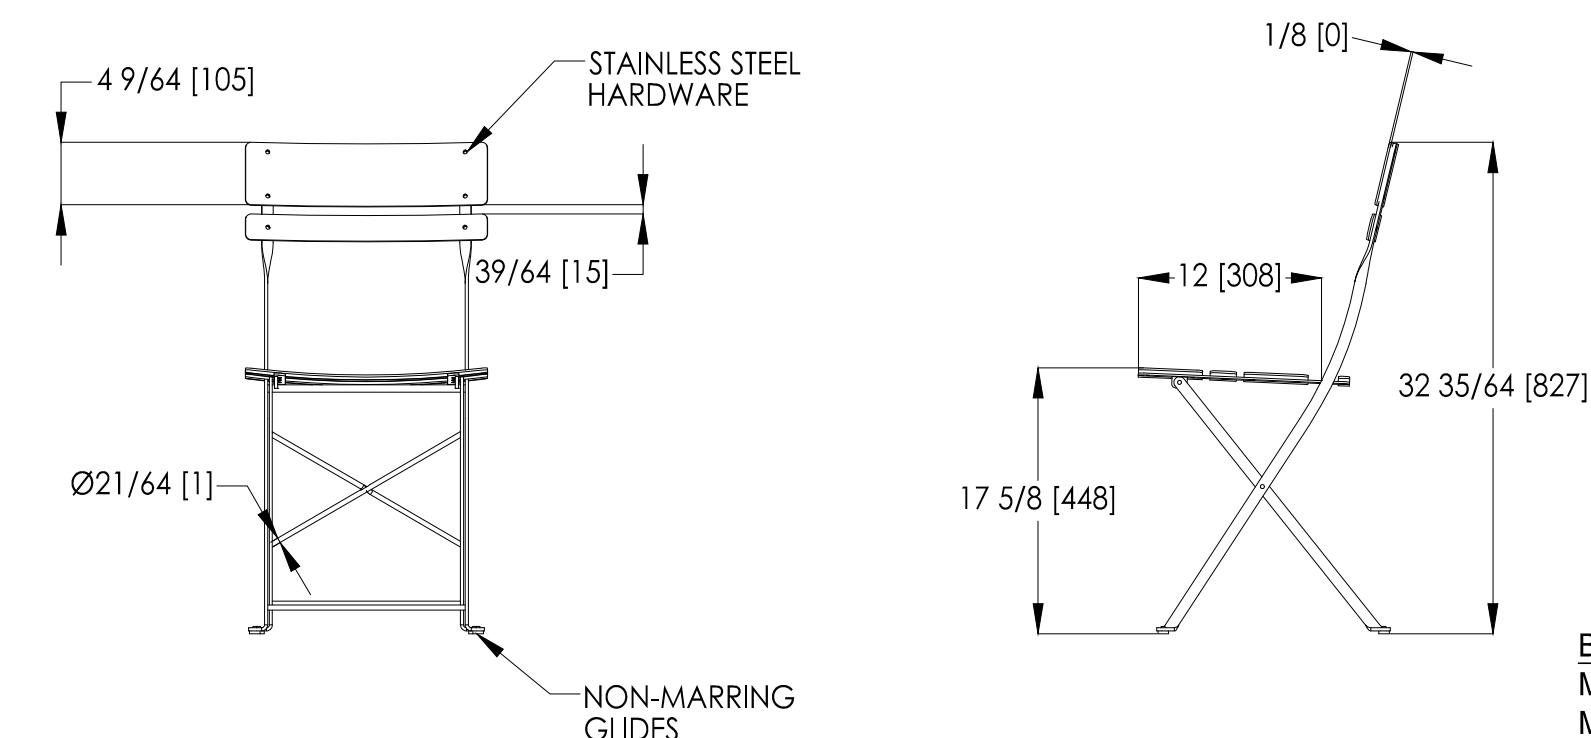

BRAVO BISTRO CHAIR
MANUFACTURER: LANDSCAPE FORMS
MODEL NUMBER: CS101-01
COLOR: CADMIUM
CONTACT: 1.800.521.2546

NO.	BY	DATE	REVISION

SEAL:

8678 CONCORD CENTER DR, UNIT 200
ENGLEWOOD, CO 80112
303.537.8020
rickengineering.com

RICK ENGINEERING COMPANY
San Diego - Riverside - Sacramento - Orange - Tucson - Phoenix - Las Vegas - Denver


PROJECT NO: 2243 | DRAWN/DESIGNED BY: KAJS
DATE: 07/05/2023 | CHECKED BY: JS

SITE PLAN PREPARED FOR:
**DOUGLAS 234, FILING NO. 6,
AMENDMENT 1, LOT 4**
DOUGLAS COUNTY, COLORADO

LANDSCAPE PLAN & DETAILS

SITE PLAN FOR DUNKIN' DONUTS DOUGLAS 234, FILING NO. 6, AMENDMENT 1, LOT 4

A PORTION OF THE SOUTHWEST QUARTER OF THE SOUTHEAST QUARTER OF SECTION 29,
TOWNSHIP 6 SOUTH, RANGE 66 WEST, 6TH PRINCIPAL MERIDIAN,
TOWN OF PARKER, COUNTY OF DOUGLAS, STATE OF COLORADO
0.901 ACRES, 1 COMMERCIAL LOT

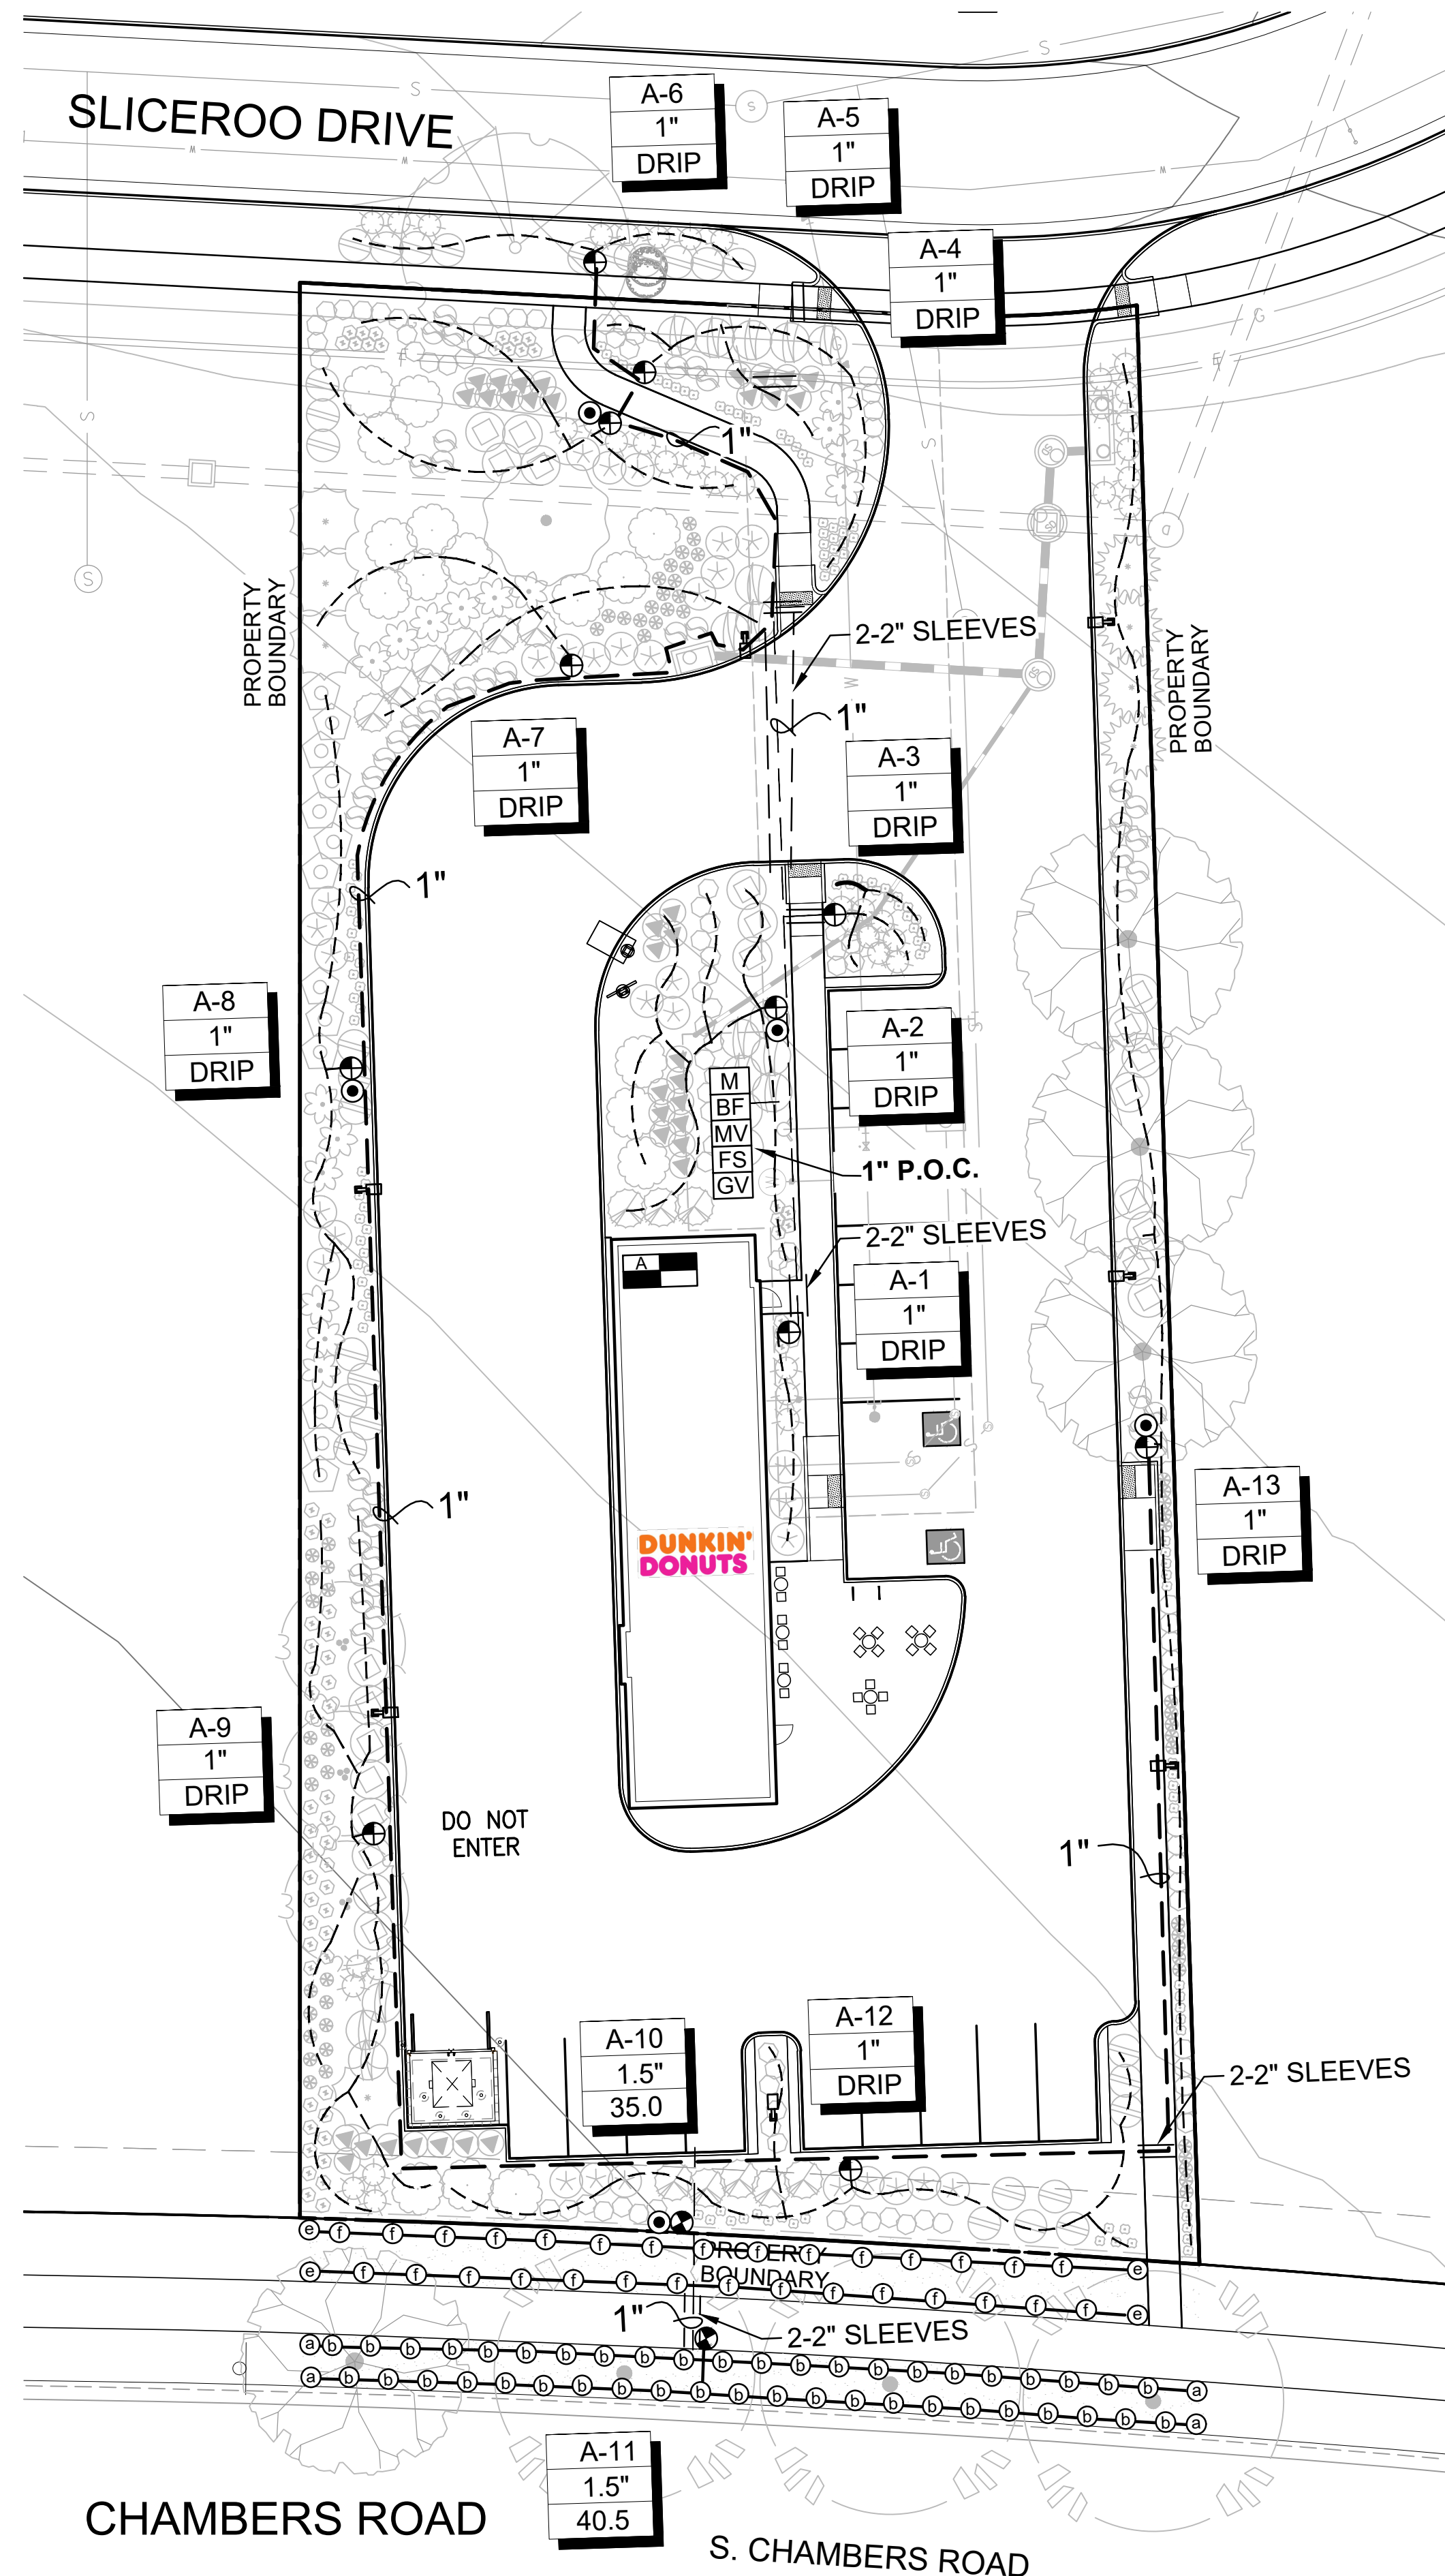

IRRIGATION NOTES

IRRIGATION - GENERAL

ALL WORK SHALL CONFORM TO TOWN OF PARKER STANDARDS AND SPECIFICATIONS AND WITH THE ACCEPTED PLANS. REFER TO THESE STANDARDS FOR ADDITIONAL INFORMATION AS NEEDED. A COPY OF THESE SPECIFICATIONS SHALL BE AVAILABLE ON THE WORK SITE AT ALL TIMES.

THIS SYSTEM DESIGN ASSUMES A STATIC PRESSURE OF 70 PSI AT THE POINT OF CONNECTION. CONTRACTOR RESPONSIBLE FOR VERIFYING PRESSURE AND FLOW. CONTRACTOR RESPONSIBLE FOR COORDINATION OF ELECTRICAL INSTALLATION OF CONTROLLER.

INSTALL CONTROLLER ON PEDESTAL AT APPROXIMATE LOCATION SHOWN ON PLANS, COORDINATE LOCATION WITH OWNER.

INSTALL ALL ELECTRICAL IN ACCORDANCE WITH NATIONAL ELECTRICAL CODE AND ALL APPLICABLE LOCAL CODES.

DO NOT PROCEED WITH THE INSTALLATION OF THE IRRIGATION SYSTEM WHEN IT IS OBVIOUS IN THE FIELD THAT OBSTRUCTIONS OR GRADE DIFFERENCES EXIST THAT WILL AFFECT THE EFFICIENCY OF THE IRRIGATION SYSTEM. CONTACT OWNERS REPRESENTATIVE FOR CLARIFICATION. IF DISCREPANCIES IN NOTES, DETAILS OR SPECIFICATIONS EXIST CONTACT OWNER'S REPRESENTATIVE TO CLARIFY.

DRAWINGS ARE DIAGRAMMATIC, IRRIGATION SYSTEM IS TO BE INSTALLED IN LANDSCAPE AREAS.

CONTRACTOR RESPONSIBLE FOR INSTALLATION OF ALL IRRIGATION SLEEVING. COORDINATE ALL SLEEVE INSTALLATION WITH OTHER TRADES.

ALL DRIP LINES TO BE INSTALLED BELOW GRADE AND BROUGHT TO THE BASE OF PLANTS.

THE CONTRACTOR SHALL CERTIFY THAT THE GRADE IS WITHIN PLUS OR MINUS ONE-TENTH (1/10TH) OF THE FINAL GRADING PLAN PRIOR TO COMMENCEMENT OF ANY LANDSCAPE OR IRRIGATION WORK. THE CONTRACTOR SHALL BE RESPONSIBLE FOR ALL PERMITS, FEES, AND LICENSES ASSOCIATED WITH THE WORK AS SHOWN ON THE PLANS.

THE CONTRACTOR SHALL BE RESPONSIBLE FOR UTILITY LOCATIONS PRIOR TO ANY EXCAVATION.

ANY REVISION TO THE IRRIGATION PLAN SHALL BE REVIEWED AND APPROVED BY THE TOWN OF PARKER PRIOR TO IMPLEMENTATION.

THE CONTRACTOR SHALL HAVE ACCEPTED SET OF PLANS AND MUST HAVE HELD A PRE-CONSTRUCTION MEETING WITH OWNERS REPRESENTATIVE PRIOR TO COMMENCEMENT OF ANY AND ALL WORK.

THE CONTRACTOR SHALL WARRANT THE WORKMANSHIP AND IRRIGATION SYSTEM FOR A PERIOD OF TWO YEARS.

DO NOT DISTURB PAVING, LIGHTING, LANDSCAPE OR IRRIGATION THAT EXISTS ADJACENT TO THE SITE UNLESS OTHERWISE NOTED ON PLANS.

THE CONTRACTOR SHALL IDENTIFY, VERIFY AND PROTECT CONTROL POINT. CONTRACTOR SHALL VERIFY LOCATION OF CONTROL POINT WEEKLY AND THE ORIGINAL CONDITION OF CONTROL POINT PIN SHALL BE MAINTAINED THROUGHOUT ENTIRE PROJECT. LOCATION AND G.P.S. COORDINATES OF THE CONTROL POINT SHALL BE IDENTIFIED ON ALL PLANS AND AS-BUILTS.

THE IRRIGATION SYSTEM SHALL BE INSTALLED AFTER SOIL PREPARATION AND PRIOR TO PLANT MATERIALS.

IRRIGATION - INSPECTIONS

CONTRACTOR SHALL BE RESPONSIBLE FOR THE SCHEDULING AND COORDINATION OF ALL REQUIRED INSPECTIONS WITH OWNERS REPRESENTATIVE AND THE TOWN OF PARKER. REFER TO TOWN OF PARKER STANDARDS AND SPECIFICATIONS FOR ALL REQUIRED INSPECTIONS.

THE IRRIGATION SYSTEM SHALL PASS A MAINLINE PRESSURE TEST AND COVERAGE TEST AND A WATERING SCHEDULE WITH RUN TIMES AND APPLICATION RATES SHALL BE SUBMITTED PRIOR TO SODDING, SEEDING, OR PLANTING.

CONTRACTOR SHALL SCHEDULE PRESSURE TEST AT COMPLETION OF MAINLINE, MAINLINE SHALL HOLD AT SEVENTY (70) P.S.I. FOR TWO (2) HOURS.

IRRIGATION - AS-BUILTS

APPROVED CONSTRUCTION DRAWINGS SHALL BE ON SITE AND UPDATED DAILY WITH AS-BUILT MARKUPS. CONTRACTOR SHALL MAKE AS-BUILTS AVAILABLE ON SITE TO TOWN STAFF AND OWNERS REPRESENTATIVE FOR REVIEW AND INSPECTION IMMEDIATELY UPON REQUEST.

RECORD ALL CHANGES WHICH ARE MADE FROM THE CONTRACT DRAWINGS. RECORD ALL REQUIRED INFORMATION ON AS-BUILT DRAWINGS. DO NOT USE THESE PRINTS FOR ANY OTHER PURPOSE.

IRRIGATION MATERIAL LEGEND

SYMBOL	MANUFACT.	MODEL NO. / DESCRIPTION	
	HUNTER	HYDRAWISE X2-1400, IRRIGATION CONTROLLER 'A' 14 STATION CONTROLLER, 13 STATIONS USED	A/9
	P.O.C. 'A'	METER, P.O.C. 'A' - 1" POTABLE TAP. STATIC WATER PRESSURE IS ASSUMED TO BE 70 PSI. CONTRACTOR TO FIELD VERIFY AND NOTIFY LANDSCAPE ARCHITECT IMMEDIATELY IF DIFFERENT	B/9
	FEBCO	BACKFLOW PREVENTION ASSEMBLY 825-YA SPARKERS W/MODEL 650 WYE STRAINER SIZE OF P.O.C. (1"). IN STRONG BOX ENCLOSURE. ALL PIPING BETWEEN METER AND BACKFLOW DEVICE SHALL BE 'K' COPPER OR RED BRASS.	B & C/9
	RAINBIRD	BRASS MASTER VALVE, EFB-CP-PRS-D, SIZE OF P.O.C. NORMALLY CLOSED WITH PRESSURE REGULATING MODULE. MASTER VALVE SHALL BE INSTALLED IN A 'JUMBO' SIZED VALVE BOX WITH LOCKING COVER AND 'MCV' HEAT BRANDED ON COVER	B & D/9
	HUNTER	RAIN-CLIK FLOW SENSOR. INSTALL PER MANUFACTURER'S RECOMMENDATIONS.	B/9, B/10
	RAINBIRD	QUICK COUPLER VALVE 44RC WITH LOCKING RUBBER COVER, INSTALLED IN 10" ROUND VALVE BOX WITH 'QCV' HEAT BRANDED ON COVER INSTALL QCV ON A 1" STUB-OUT OFF MAINLINE.	D/10
	RAINBIRD	PEB, REMOTE CONTROL VALVE. BOX WITH LOCKING VALVE COVER AND 'RCV' HEAT BRANDED ON COVER.	A/11
	RAINBIRD	XCZ-150-PRB-COM, 1" REMOTE CONTROL DRIP VALVE KIT. BOX WITH LOCKING VALVE COVER AND 'RCV' HEAT BRANDED ON COVER.	C/11
	AS APPROVED	MAINLINE, CLASS 200 PVC SOLVENT WELD FITTINGS	H/10
	AS APPROVED	LATERAL LINE, CLASS 200 PVC SOLVENT WELD FITTINGS	H/10
	AS APPROVED	HUNTER HDL-CV DRIP TUBING WITH EMITTERS TO BASE OF PLANTS	E/9
	AS APPROVED	SLEEVING, SCH. 40 PVC PIPE, MINIMUM 4" DIAMETER FOR PIPING, LARGER WHERE APPROPRIATE. A SEPARATE 2" SLEEVE, FOR WIRE UNDER ALL PAVED SURFACES.	D, H/11
	RAINBIRD	SHRUBS - POINT SOURCE DRIP ZONE, XERIBUG DRIP EMITTERS ON A STAKE CONNECTED TO POLY DRIP TUBING PER DETAIL.	E/9
NOT SHOWN	AS APPROVED	WIRE SPLICES ALLOWED ONLY WHERE RUNS EXCEED 2500'. PULL BOXES FOR WIRE SPLICES. PULL BOXES SHALL BE 12" RECTANGULAR WITH LOCKING LID.	I/10
NOT SHOWN	NETAFIM	DRIP END FLUSH, NETAFIM TL050MFV-1, INSTALL ON PVC EXHAUST MANIFOLD WITHIN VALVE BOX AT LOWEST ELEVATION AND ALL END RUN(S) IN SYSTEM. INSTALL MIN. TYP AS REQUIRED.	

IRRIGATION MATERIAL LEGEND (HEADS):


SYMBOL	Q	H	F	MANF.	MODEL NO. / DESCRIPTION	GPM	PRECIP	PSI	RADIUS FT.	DETAIL
	⊙	⊙	⊙	HUNTER	PROS-04-PRS30-8A 4" HIGH POP-UP W/ 8A BROWN NOZZLE	.44, .88, 1.76	3.06	30	8	B/11
	⊙	⊙	⊙	HUNTER	PROS-04-PRS30-10A 4" HIGH POP-UP W/ 10A RED NOZZLE	.50, 1.00, 2.00	2.22	30	10	B/11

LATERAL PIPE SIZING CHART:

CLASS 200 PIPE	GPM
3/4"	0-10
1"	11-16
1-1/4"	17-26
1-1/2"	27-36
2"	37-55
2-1/2"	56-80

SLEEVING SCHEDULE

PIPE SIZE	SLEEVE SIZE
3/4"	2"
1"	2"
1-1/4"	3"
1-1/2"	3"
2"	4"
2-1/2"	6"
3"	6"

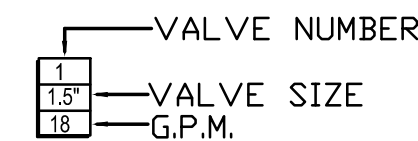

SEAL:

PROJECT NO: 2243

DATE: 9/5/2023

NO. BY DATE

NO. BY DATE

8678 CONCORD CENTER DR, UNIT 200
ENGLEWOOD, CO 80112
303.537.8020

rickengineering.com

San Diego - Riverside - Sacramento - Orange - Tucson - Phoenix - Las Vegas - Denver

KN/TM

DESIGNED BY:

CHECKED BY:

ENGINEERING COMPANY

San Diego - Riverside - Sacramento - Orange - Tucson - Phoenix - Las Vegas - Denver

ENGINEERING COMPANY

San Diego - Riverside - Sacramento - Orange - Tucson - Phoenix - Las Vegas - Denver

8678 CONCORD CENTER DR, UNIT 200
ENGLEWOOD, CO 80112
303.537.8020

ENGINEERING COMPANY

San Diego - Riverside - Sacramento - Orange - Tucson - Phoenix - Las Vegas - Denver

ENGINEERING COMPANY

San Diego - Riverside - Sacramento - Orange - Tucson - Phoenix - Las Vegas - Denver

SITE PLAN PREPARED FOR:
**DOUGLAS 234, FILING NO. 6,
 AMENDMENT 1, LOT 4**
 DOUGLAS COUNTY, COLORADO
LANDSCAPE IRRIGATION & DETAILS

Know what's below.
Call before you dig.

DRAWING NO. 8

2ND SUBMITTAL

SITE PLAN FOR DUNKIN' DONUTS DOUGLAS 234, FILING NO. 6, AMENDMENT 1, LOT 4

A PORTION OF THE SOUTHWEST QUARTER OF THE SOUTHEAST QUARTER OF SECTION 29,
TOWNSHIP 6 SOUTH, RANGE 66 WEST, 6TH PRINCIPAL MERIDIAN,
TOWN OF PARKER, COUNTY OF DOUGLAS, STATE OF COLORADO
0.901 ACRES, 1 COMMERCIAL LOT



Landscape/Irrigation Worksheet

Project Name: Dunkin' Donuts

Landscape/Irrigation Tap address (physical location of tap) 12211 Sliceroo Drive, Parker, CO


Landscape Area	High Water TURF (6,000sf = 1 SFE)	Low Water Native Grass and Perennials (10,000sf = 1 SFE)	Spray Shrubs & Drip Irrigated (20,000sf = 1 SFE)	Sub-Total of Non-Irrigated area (calculated) Areas	PWSD one SFE per 6000	SFE Requirement (Sub-Total Calculation divided by 6000 = requirement)
Area #1	2,330 sf x 1 = 2,330	0 sf x .6 = 0	13,830 sf x .3 = 4,149	0 sf x 0 = 0	6,479 sf	6,000
						1,079 SFE's

Worksheet Completed by: Kim Nelson
Company: RICK Engineering
Address: 5690 Webster St., Arvada, CO 80002
Phone #: 303-423-6036

Owner/Developer: First Cup Dunkin' Donuts, LLC
Attn: Brian Zurek
Billing Address: 106 S. Kyrene Rd, Ste 2, Chandler, AZ 85226
Phone #: 480-313-2724

ET Controller (with Rain Sensor)	
Manufacturer	Hunter
Model number	Hydrawise X2-1400


Tap Size Requirements:	
0 - 1 SFE's	requires a 3/4-inch tap
1.1 - 2.0 SFE's	requires a 1-inch tap
2.1 - 4.0 SFE's	requires a 1 1/2-inch tap
4.1 - 7.0 SFE's	requires a 2-inch tap
7.1 - 16.0 SFE's	requires a 3-inch tap

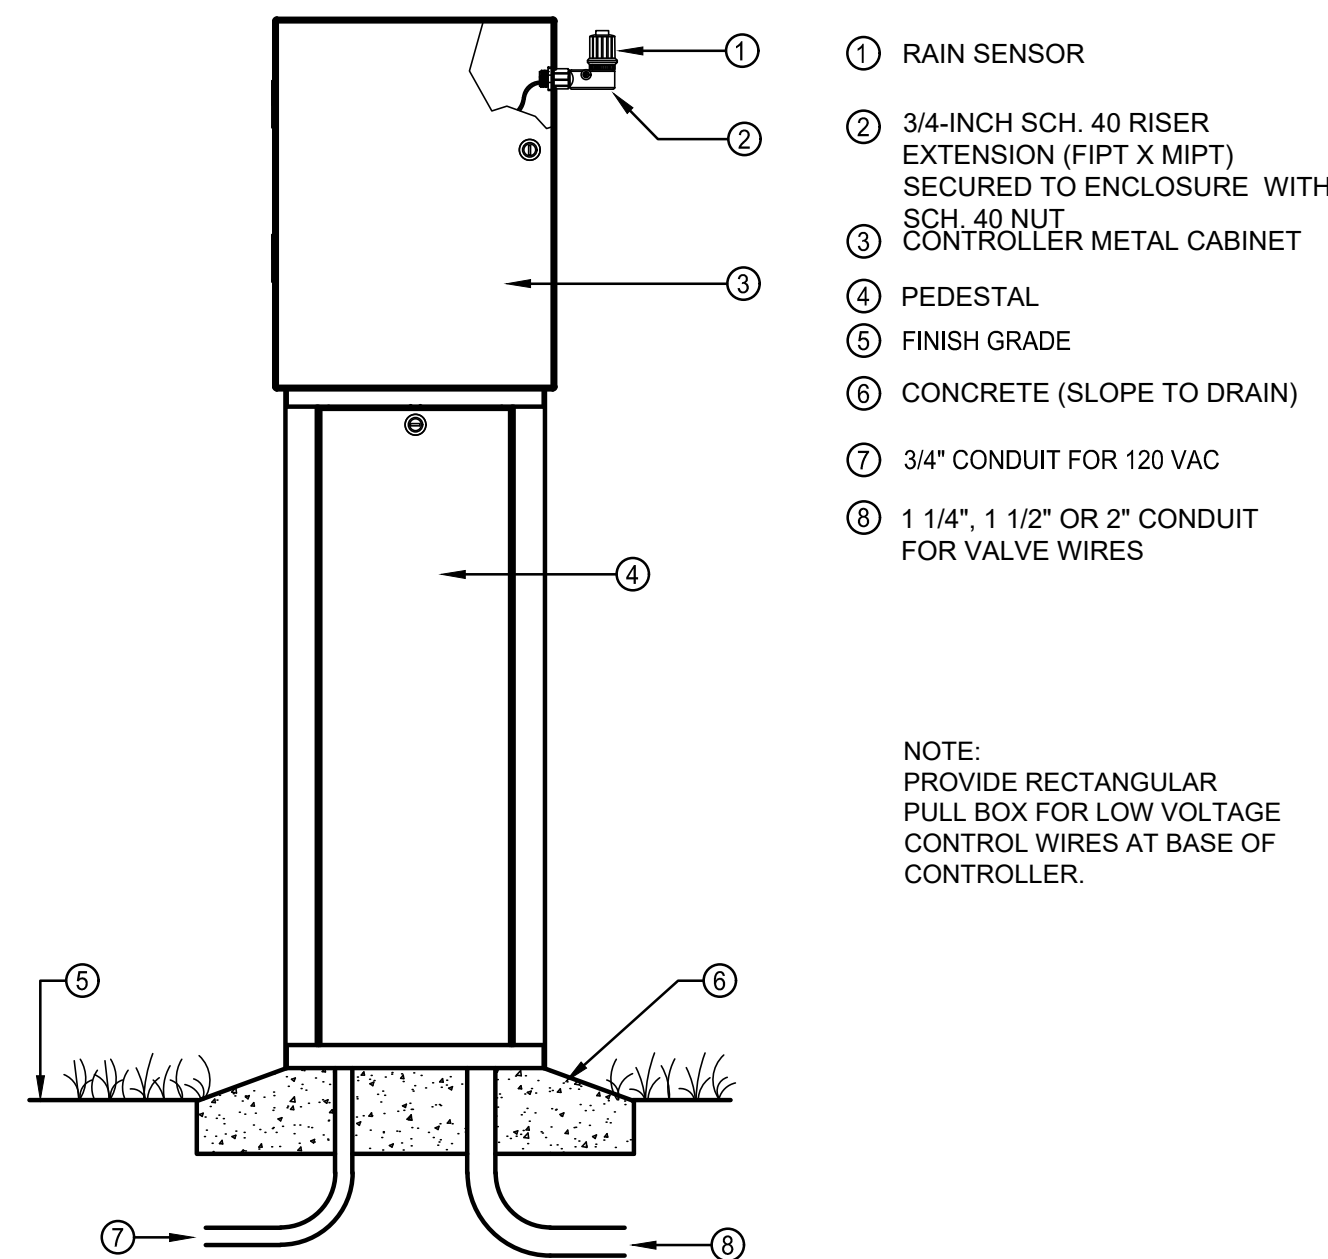


- ① RAIN SENSOR
- ② 3/4-INCH SCH. 40 RISER EXTENSION (F1PT X MIPT) SECURED TO ENCLOSURE WITH SCH. 40 NUT CONTROLLER METAL CABINET
- ③ PEDESTAL
- ④ FINISH GRADE
- ⑤ CONCRETE (SLOPE TO DRAIN)
- ⑥ 3/4" CONDUIT FOR 120 VAC
- ⑦ 1 1/4", 1 1/2" OR 2" CONDUIT FOR VALVE WIRES

NOTE:
PROVIDE RECTANGULAR PULL BOX FOR LOW VOLTAGE CONTROL WIRES AT BASE OF CONTROLLER.


A CONTROLLER PEDESTAL MOUNT
SCALE: N.T.S.

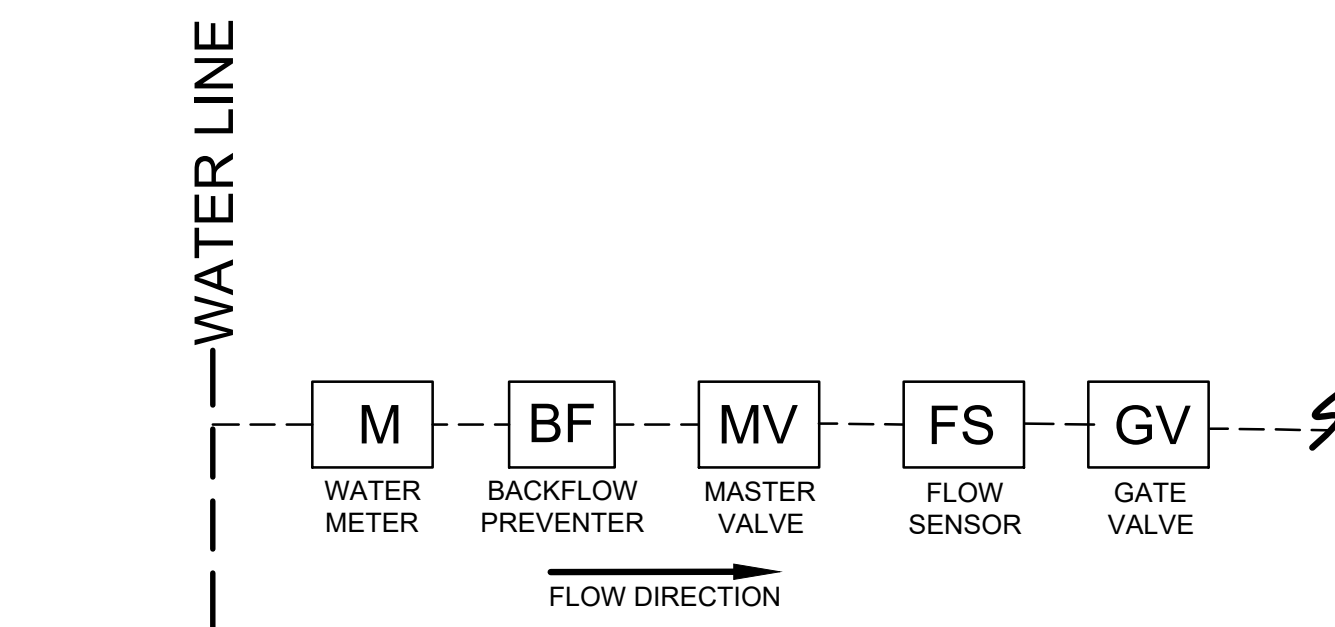


B POINT OF CONNECTION (P.O.C.)
SCALE: N.T.S.

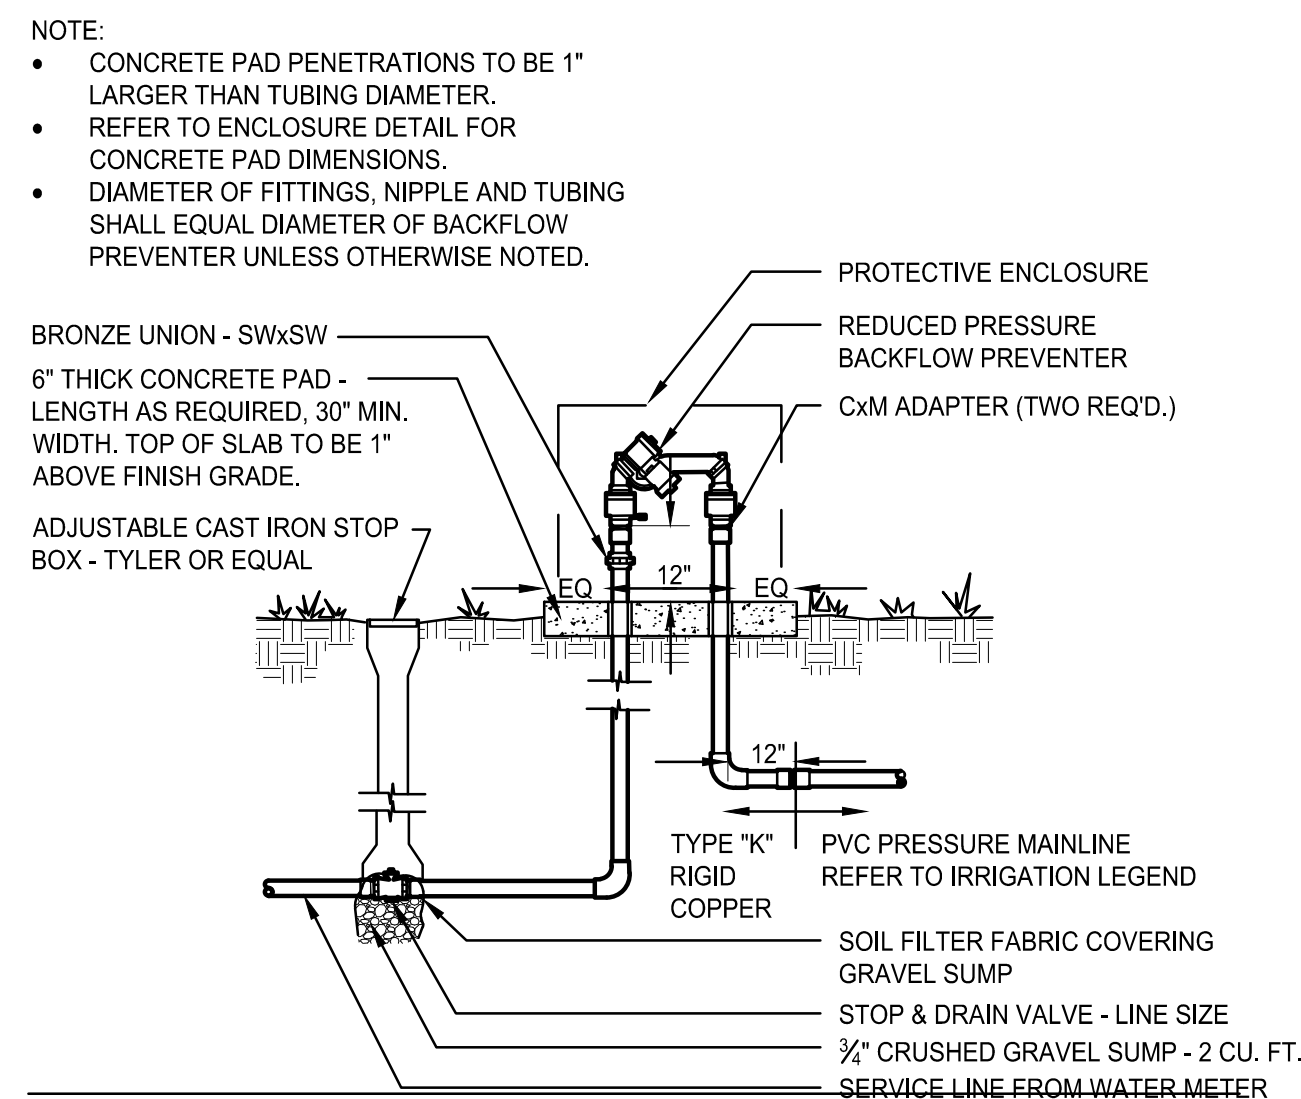

C BACKFLOW PREVENTER
SCALE: N.T.S.

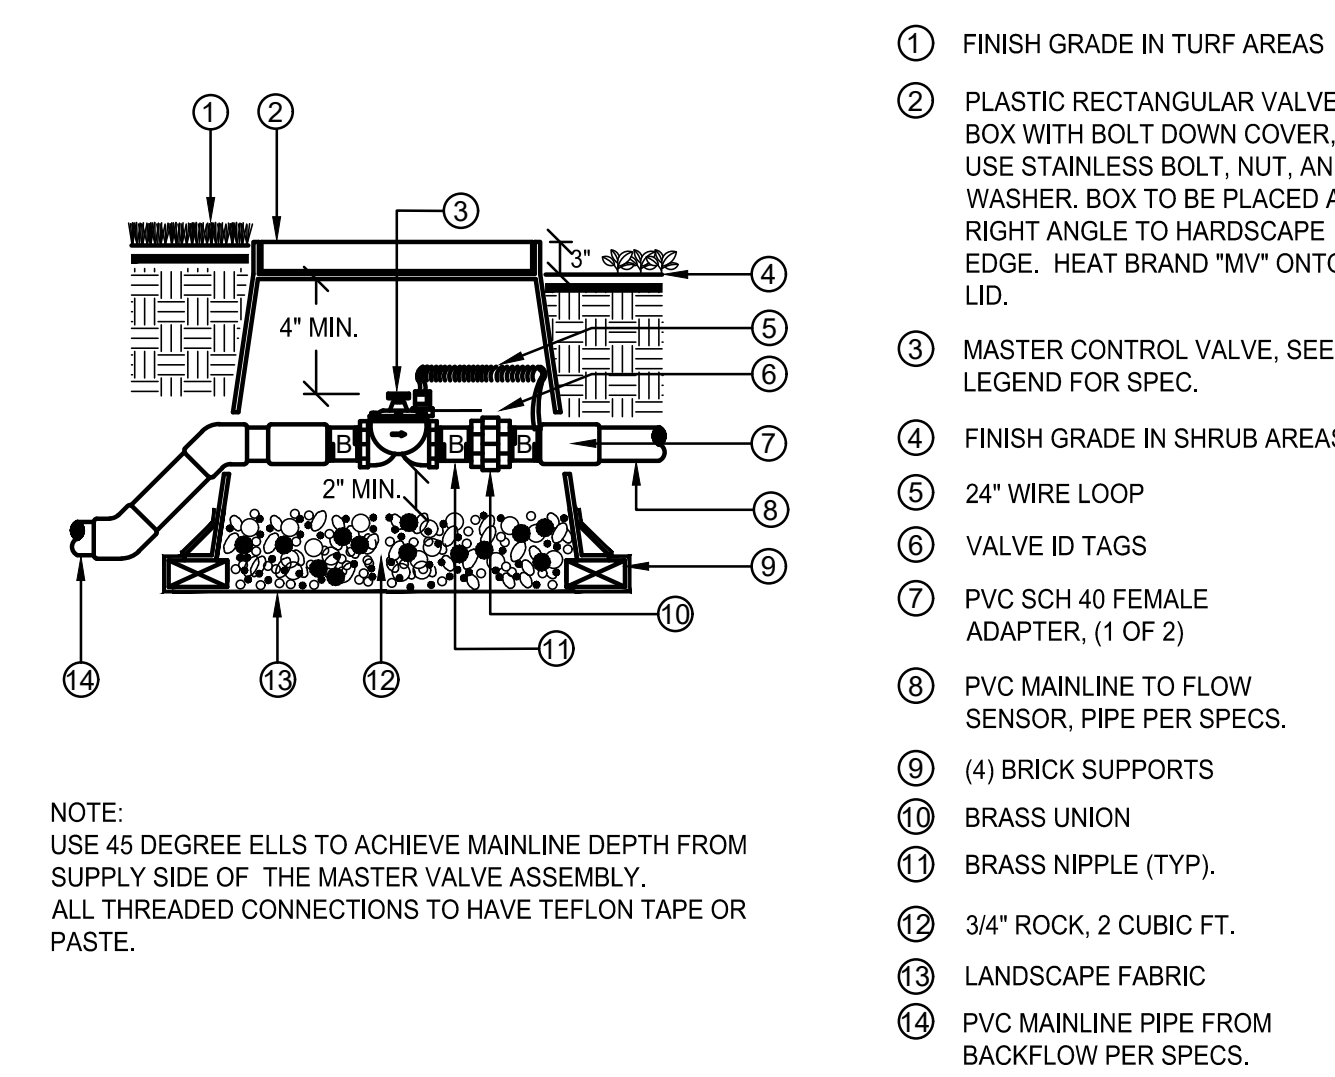

D MASTER VALVE
SCALE: N.T.S.

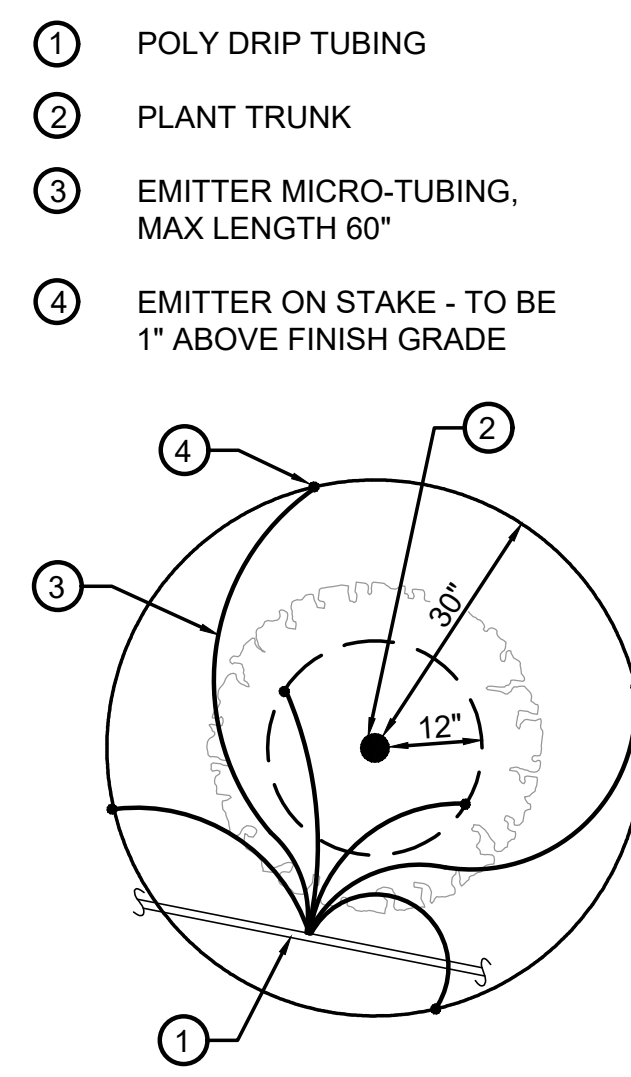

E DRIP EMITTER
SCALE: N.T.S.

PLANT SIZE	EMITTER FLOW RATE	EMITTER QTY. AT MULCHED BED LOCATIONS	EMITTER QTY. AT NATIVE SEED LOCATIONS
1-2 GALLON MATERIAL	0.5 GPH	ONE EACH	ONE EACH
5 GALLON MATERIAL	0.5 GPH	TWO EACH	TWO EACH
1-1/2" CALIPER TREE	1 GPH	THREE EACH	FOUR EACH
2" CALIPER TREE	1 GPH	FOUR EACH	SIX EACH
2-1/2" CALIPER TREE	1 GPH	SIX EACH	EIGHT EACH
3" CALIPER TREE	1 GPH	EIGHT EACH	TEN EACH
3-1/2" CALIPER TREE	1 GPH	NINE EACH	ELEVEN EACH
4" CALIPER TREE	1 GPH	TEN EACH	TWELVE EACH
6 FT. CONIFEROUS TREE	1 GPH	FOUR EACH	SIX EACH
8 FT. CONIFEROUS TREE	1 GPH	SIX EACH	NINE EACH
10 FT. CONIFEROUS TREE	1 GPH	EIGHT EACH	TWELVE EACH
12 FT. CONIFEROUS TREE	1 GPH	TEN EACH	FOURTEEN EACH

NO.	BY	DATE	REVISION

SEAL:

PROJECT NO: 2243
DATE: 9/5/2023
DRAWN/DESIGNED BY: [Signature]
CHECKED BY: [Signature]

KN/TM
KN

RICK
ENGINEERING COMPANY
8678 CONCORD CENTER DR, UNIT 200
ENGLEWOOD, CO 80112
303.537.8020
rickengineering.com

San Diego - Riverside - San Luis Obispo - Sacramento - Orange - Tucson - Phoenix - Las Vegas - Denver

SITE PLAN PREPARED FOR:
**DOUGLAS 234, FILING NO. 6,
AMENDMENT 1, LOT 4**
DOUGLAS COUNTY, COLORADO

LANDSCAPE IRRIGATION & DETAILS


811
Know what's below.
Call before you dig.

DRAWING NO. 9

2ND SUBMITTAL


SITE PLAN FOR DUNKIN' DONUTS DOUGLAS 234, FILING NO. 6, AMENDMENT 1, LOT 4

A PORTION OF THE SOUTHWEST QUARTER OF THE SOUTHEAST QUARTER OF SECTION 29,
TOWNSHIP 6 SOUTH, RANGE 66 WEST, 6TH PRINCIPAL MERIDIAN,
TOWN OF PARKER, COUNTY OF DOUGLAS, STATE OF COLORADO
0.901 ACRES, 1 COMMERCIAL LOT

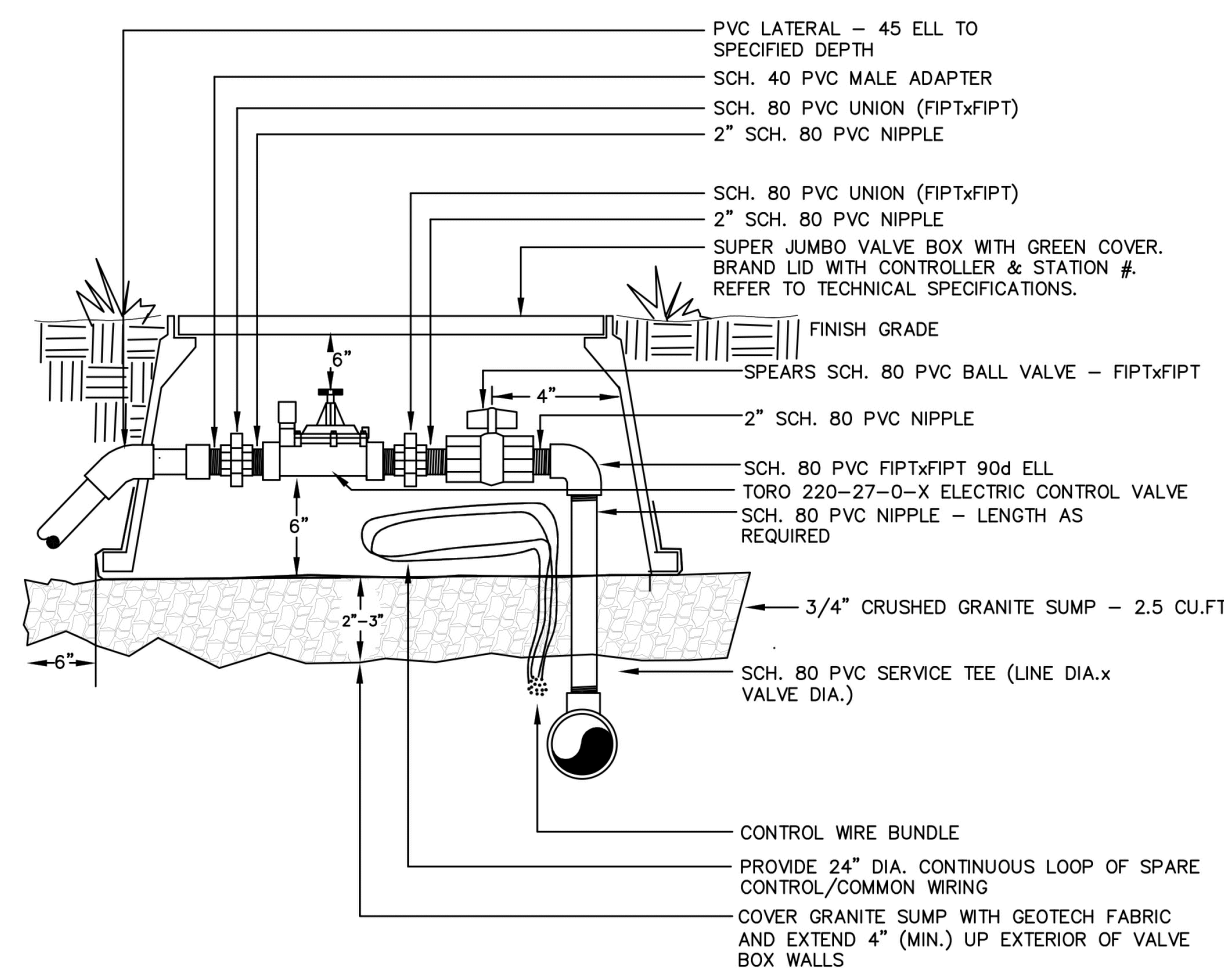

- NOTES:
1. DIAMETERS OF BALL VALVES, PVC FITTINGS, AND NIPPLES SHALL EQUAL ELECTRIC CONTROL VALVE DIAMETER
 2. VALVE BOXES SHALL BE INSTALLED PARALLEL OR PERPENDICULAR TO ADJACENT SIDEWALKS AND HARD SURFACES WHERE APPLICABLE
 3. USE BRAND NAMES SPECIFIED OR APPROVED EQUAL
 4. BALL VALVE IN SEPARATE BOX FOR VALVES THAT ARE 3" OR GREATER


A AUTOMATIC CONTROL VALE
NTS

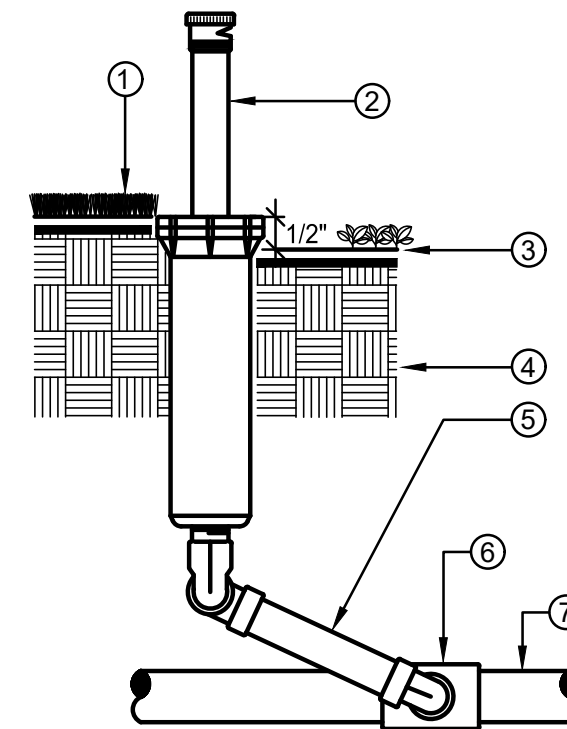

- NOTE:
INSTALL SPRINKLER HEADS 24" FROM PAVING EDGE. INSTALL SPRINKLER HEADS PLUMB. ADJUST SPRAYS OR NOZZLE STREAM TO COVER LANDSCAPE AREA WITHOUT OVERSPRAY ONTO PAVING, FENCES, WALLS OR BUILDINGS. ALL THREADED CONNECTIONS TO HAVE TEFLON TAPE OR PASTE.
- WHERE INSTALLED AT TREES, INSTALL BUBBLERS 3" FROM TRUNK TO ENSURE PROPER WATERING AS TREE GROWS

B POP-UP SPRINKLER
NTS


1. INSTALL SPRINKLER HEAD FLUSH WITH FINISH GRADE IN TURF AREAS
2. POP-UP SPRINKLER HEAD, SPRAY OR ROTOR SEE LEGEND FOR SPECIFICATION
3. INSTALL SPRINKLER HEAD 1/2" ABOVE FINISH GRADE IN SHRUB AND GROUND COVERS AREAS
4. UNDISTURBED SOIL
5. TRIPLE SWING JOINT ASSEMBLY
6. SCH 40 PVC SxSXT TEE FITTING LATERAL x SPRINKLER INLET SIZE
7. LATERAL LINE, SEE SPECIFICATIONS FOR TYPE AND DEPTH REQUIRED

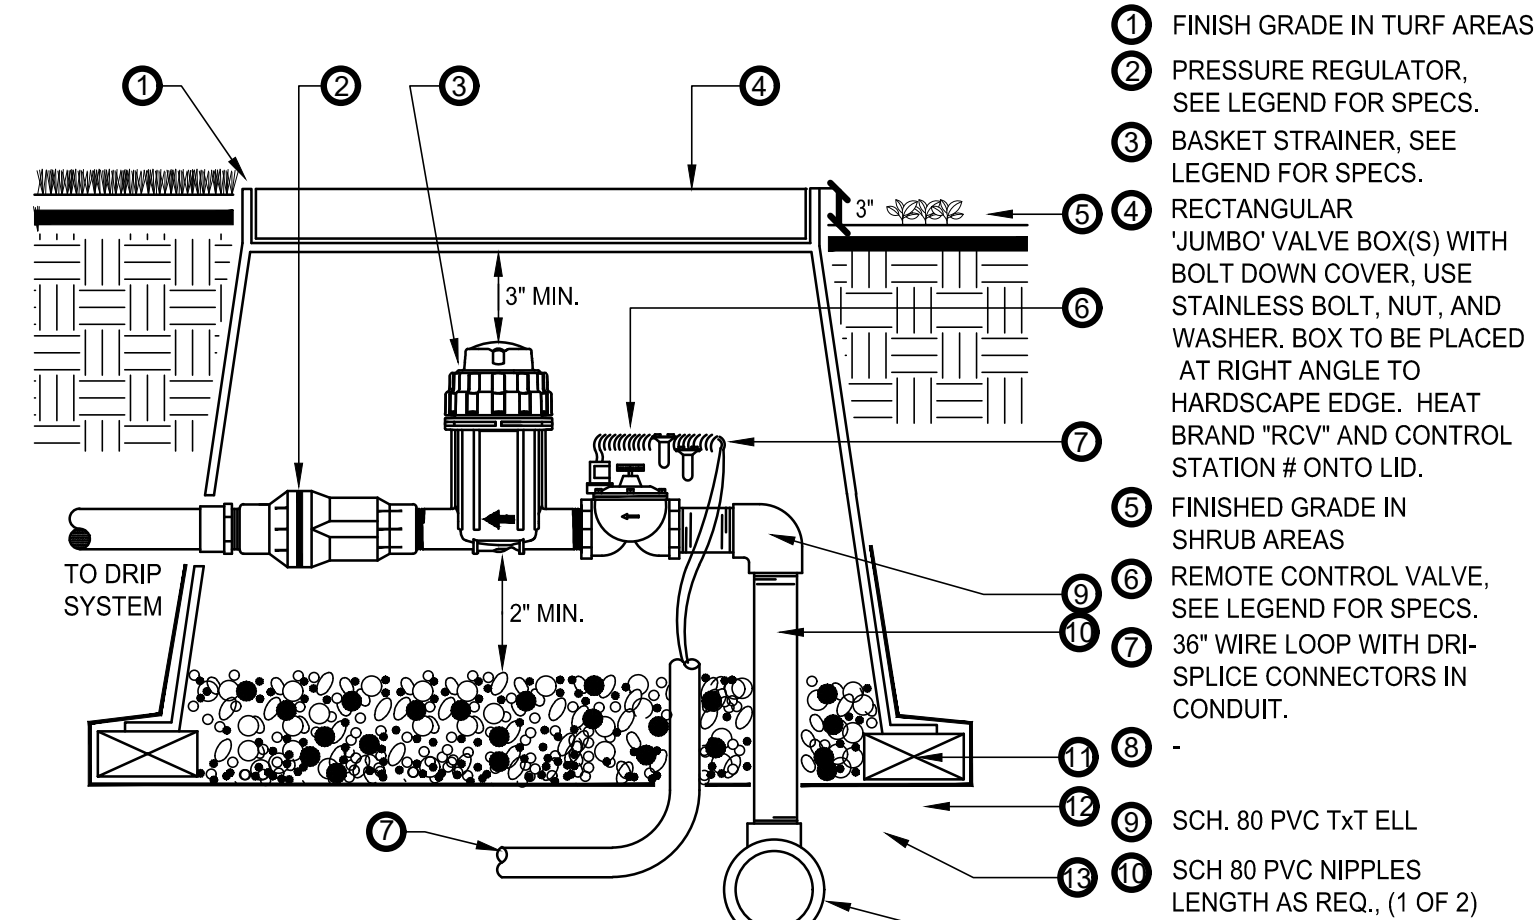

- NOTE:
INSTALL VALVE BOX EXTENSIONS AS REQUIRED TO ACHIEVE PROPER VALVE INSTALLATION AT MAIN LINE DEPTH. ALL THREADED CONNECTIONS TO HAVE TEFLON TAPE OR PASTE.

C DRIP CONTROL ZONE KIT
SCALE: N.T.S.

1. FINISH GRADE IN TURF AREAS
2. PRESSURE REGULATOR, SEE LEGEND FOR SPECS.
3. BASKET STRAINER, SEE LEGEND FOR SPECS.
4. RECTANGULAR 'JUMBO' VALVE BOX(S) WITH BOLT DOWN COVER, USE STAINLESS BOLT, NUT, AND WASHER. BOX TO BE PLACED AT RIGHT ANGLE TO HARDSCAPE EDGE. HEAT BRAND 'RCV' AND CONTROL STATION # ONTO LID.
5. FINISHED GRADE IN SHRUB AREAS
6. REMOTE CONTROL VALVE, SEE LEGEND FOR SPECS.
7. 36" WIRE LOOP WITH DRI-SPLICE CONNECTORS IN CONDUIT.
8. SCH. 80 PVC TXT ELL
9. SCH 80 PVC NIPPLES LENGTH AS REQ., (1 OF 2)
10. (4) BRICK SUPPORTS
11. 3/4" ROCK, 2 CUBIC FEET
12. LANDSCAPE FABRIC w/ 1/4" GALV. MESH TYP.
13. IRRIGATION MAINLINE OR MANIFOLD SUPPLY

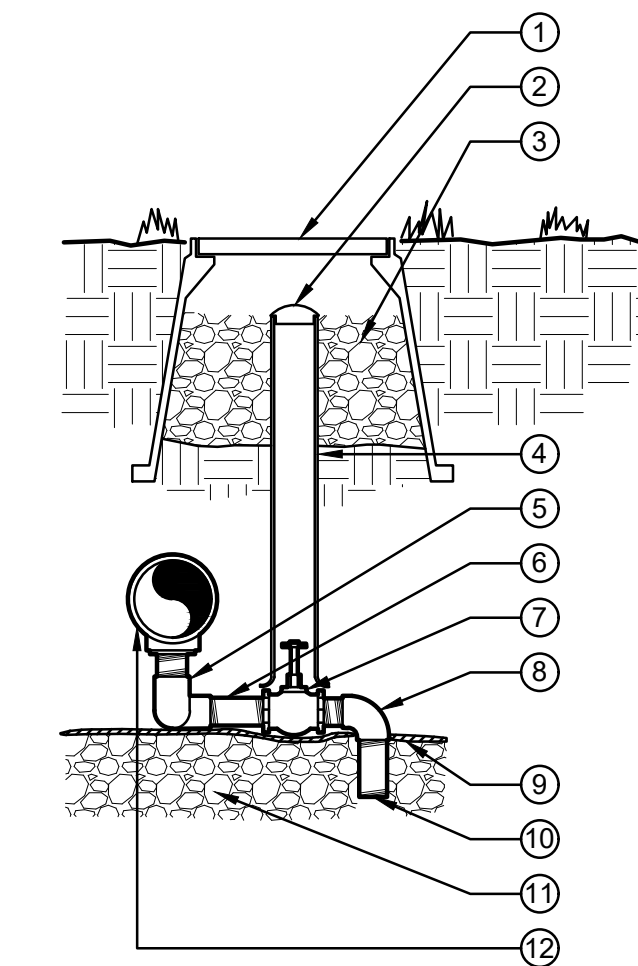

1. 10" ROUND VALVE BOX - BRAND THE LETTER 'D' ON LID. SEE SPECS.
 2. 2" VALVE MARKER
 3. 3/4" CRUSHED GRAVEL SUMP 1 CU. FT.
 4. 2" CL 180 PVC ACCESS SLEEVE - LENGTH AS REQUIRED.
 5. 1/2" Fx F SCH. 80 PVC 90 ELL (2)
 6. 1/2" xCL PVC NIPPLE SCH. 80 (2)
 7. 1/2" x 6" SCH. 80 GALV. STEEL NIPPLE
 8. 1/2" BRASS GLOBE VALVE
 9. 1/2" Mx F SCH. 40 PVC 90 ELL
 10. SOIL BLANKET COVERING SUMP
 11. 1/2" x 4" PVC NIPPLE SCH. 80
 12. 1/2" CRUSHED GRAVEL SUMP. SEE SPECIFICATIONS FOR SUMP SIZE.
 13. PVC PRESSURE MAINLINE
- NOTE: APPLY TEFLON TAPE TO ALL MALE THREADED PVC FITTINGS AND ALL NIPPLES.

D MANUAL DRAIN VALVE
SCALE: N.T.S.

NO.	BY	DATE	REVISION

SEAL:

8678 CONCORD CENTER DR, UNIT 200
ENGLEWOOD, CO 80112
303.537.8020
rickengineering.com

PROJECT NO: 2243 | DRAWN/DESIGNED BY: KN/TM
DATE: 9/5/2023 | CHECKED BY: KN

RICK ENGINEERING COMPANY
San Diego - Riverside - San Luis Obispo - Sacramento - Orange - Tucson - Phoenix - Las Vegas - Denver

SITE PLAN PREPARED FOR:
**DOUGLAS 234, FILING NO. 6,
AMENDMENT 1, LOT 4**
DOUGLAS COUNTY, COLORADO

LANDSCAPE IRRIGATION & DETAILS

811
Know what's below.
Call before you dig.

DRAWING NO. 11

2ND SUBMITTAL

Ensure that the color elevations are included in the next Site Plan Document.


RICK RESPONSE: ACKNOWLEDGED.

SITE PLAN FOR DUNKIN' DONUTS DOUGLAS 234, FILING NO. 6, AMENDMENT 1, LOT 4

A PORTION OF THE SOUTHWEST QUARTER OF THE SOUTHEAST QUARTER OF SECTION 29,
TOWNSHIP 6 SOUTH, RANGE 66 WEST, 6TH PRINCIPAL MERIDIAN,
TOWN OF PARKER, COUNTY OF DOUGLAS, STATE OF COLORADO
0.901 ACRES, 1 COMMERCIAL LOT

PER DISCUSSION WITH TOWN OF PARKER STAFF
ON AUGUST 30TH, 2023, BUILDING ELEVATIONS
ARE IN PROCESS AND WILL BE SUBMITTED FOR
TOWN REVIEW ONCE COMPLETED.

SEAL:




**8678 CONCORD CENTER DR, UNIT 200
ENGLEWOOD, CO 80112
303.537.8020**
rickengineering.com

San Diego - Riverside - San Luis Obispo - Sacramento - Orange - Tucson - Phoenix - Las Vegas - Denver

PROJECT NO: 2243 | DRAWN/DESIGNED BY: KA/JS
DATE: 8/31/2023 | CHECKED BY: JS

SITE PLAN PREPARED FOR:
**DOUGLAS 234, FILING NO. 6,
AMENDMENT 1, LOT 4**
DOUGLAS COUNTY, COLORADO

BUILDING ELEVATIONS



Know what's below.
Call before you dig.

DRAWING NO.
14

NO.	BY	DATE	REVISION

2ND SUBMITTAL

**SITE PLAN FOR
DUNKIN' DONUTS
DOUGLAS 234, FILING NO. 6,
AMENDMENT 1, LOT 4**

A PORTION OF THE SOUTHWEST QUARTER OF THE SOUTHEAST QUARTER OF SECTION 29,
TOWNSHIP 6 SOUTH, RANGE 66 WEST, 6TH PRINCIPAL MERIDIAN,
TOWN OF PARKER, COUNTY OF DOUGLAS, STATE OF COLORADO
0.901 ACRES, 1 COMMERCIAL LOT

PER DISCUSSION WITH TOWN OF PARKER STAFF
ON AUGUST 30TH, 2023, BUILDING ELEVATIONS
ARE IN PROCESS AND WILL BE SUBMITTED FOR
TOWN REVIEW ONCE COMPLETED.



DRAWING NO.
15

SITE PLAN PREPARED FOR:
**DOUGLAS 234, FILING NO. 6,
AMENDMENT 1, LOT 4**
DOUGLAS COUNTY, COLORADO
BUILDING ELEVATIONS



**8678 CONCORD CENTER DR, UNIT 200
ENGLEWOOD, CO 80112
303.537.8020**
rickengineering.com
San Diego - Riverside - San Luis Obispo - Sacramento - Orange - Tucson - Phoenix - Las Vegas - Denver

PROJECT NO: _____ DRAWN/DESIGNED BY: **KA/JS**
DATE: **8/31/2023** CHECKED BY: **JS**

SEAL:

NO.	BY	DATE	REVISION



Project Reviews Town of Parker

Project Number: SP22-041

Description: **Douglas 234 F6 AMD 1 L4 - Dunkin Donuts**

Applied: **4/4/2022**

Approved:

Site Address:

Closed:

Expired:

City, State Zip Code: ,

Status: **UNDER REVIEW 2**

Applicant: **Brynhildr Halsten**

Parent Project: **SUB21-022**

Owner: **bert hayenga**

Contractor: **Bert Hayenga**

Details:

The applicant, Ethos Architecture, is proposing a 2,108 sq. ft. drive through donut store. The site is located northeast of Hess Road and Chambers Road.

LIST OF REVIEWS						
SENT DATE	RETURNED DATE	DUE DATE	TYPE	CONTACT	STATUS	REMARKS



PARKER
COLORADO

Project Reviews Town of Parker



Review Group: ALL

4/22/2022	5/10/2022	5/2/2022	COMPLETENESS REVIEW	Carson Byerhof	REVISIONS REQUIRED	Notes
-----------	-----------	----------	---------------------	----------------	--------------------	-------

Notes:

MISSING

- Exhibit A – Legal Description – please make sure this document reflects the location information as portrayed with the County Assessor’s Office (example attached)
- Exhibit B – Title (must be current to 30 days)
- Exhibit E – Vicinity Map – showing the relationship of the site to the surrounding area within a ½-mile radius
- Executed Charge Back Agreement (attached)
- Public Notice Requirements – momentarily, I will start a new email thread connecting you to our third-party vendor requesting the public sign installations
- Project narrative – a brief description of what is being proposed to send out to all agencies. Include the following:
 - o Applicant’s name and contact information
 - o Description of the general proposal
 - o Present zoning
 - o General development schedule and phasing plan
- Fees have been added to TRACKIT
- Please send a physical materials board to Town Hall addressed to Carson Byerhof

REQUIRED REVISIONS

- Application
 - o Property Information
 - ? Revise information for name, general location, PLSS, and plat information to match the County Assessor’s Office
 - o Property Owner of Record
 - ? This information needs to match the name given in the title (note, exhibits C & D also need to match the name given in the title)
 - o Utility Providers
 - ? Water – Parker Water and Sanitation District
 - ? Sanitary Sewer – Parker Water and Sanitation District
 - ? Fire – South Metro Fire Rescue
 - o Current Property and Zoning Use
 - ? Zoning – PD – Douglas 234
 - ? Specify – Commercial
 - ? Current Use – Vacant
 - ? Subdivision – Douglas 234
 - Site Plan Exhibits
 - o Missing colored elevations and perspectives
 - o Include a sheet with digital materials board

6/1/2022	6/14/2022	6/3/2022	COMPLETENESS REVIEW	Carson Byerhof	REVISIONS REQUIRED	02 review notes
----------	-----------	----------	---------------------	----------------	--------------------	-------------------

Notes:

need following items before comments can be returned

- rough perspective
- physical materials board
- updated charge back, resigned

6/14/2022	7/22/2022	7/13/2022	COMPLETENESS REVIEW	Carson Byerhof	REVISIONS REQUIRED	03 review notes
-----------	-----------	-----------	---------------------	----------------	--------------------	-------------------

Notes:

need following items before comments can be returned

- rough perspective
- physical materials board
- updated charge back, resigned

Still missing physical materials board and updated charge back agreement



PARKER
COLORADO

Project Reviews Town of Parker



Review Group: AUTO

4/4/2022			ENGINEERING ADMINISTRATIVE	Tom Williams		
----------	--	--	-------------------------------	--------------	--	--

Notes:

4/4/2022	4/27/2022	4/18/2022	LAND USE COMPLETENESS REVIEW	Alex Mestdagh	COMPLETED	
----------	-----------	-----------	---------------------------------	---------------	-----------	--

Notes:

Review Group: SP 1ST 20

6/13/2022	7/8/2022	7/13/2022	BUILDING 20	Randy Sale	APPROVED	01 review
-----------	----------	-----------	-------------	------------	----------	-----------

Notes:

We highly encourage a Building pre-application meeting before applying for the permit to discuss construction type, occupancy, allowable areas, MEP's, energy, structural, fire, etc... Please visit our website for all plan submittal requirements: Plan Review | Town of Parker - Official Website (parkeronline.org), and our most current code adoptions.

Building and/or Fire Life Safety permit application will not be accepted/reviewed until the associated site plan is approved or otherwise discussed. All plans submitted for Building's review must meet the 2021 I-Codes, ICC A117.1-2017 for accessibility, the 2020 NEC, and the referenced NFPA editions noted in the applicable codes (i.e., 2021 IFC references the 2019 edition of NFPA 72) if received by December 31, 2024. NFRC certificates, interior/exterior lighting along with the mechanical and envelope compliance path must be included with the original submittal. All Fire Permit applications and inspections will be handled through the Parker Building Division. All land use applications and the associated Grading Permit must be approved/issued per Planning and Public Works prior to the Building Permit being approved/issued.

Retaining walls greater than 4' from base of footing or bottom course requires separate building permits and plans must be stamped by qualified professional. Tiered/staggered/stepped back retaining walls all require permits no matter the height of individual wall.

Please know the Town's Charge Back Agreement may be required for this project, specific to the building permit application. The form will be emailed to the applicant prior to the Building Pre-App meeting or upon receiving the permit application submittal. Once all required documents have been accepted and the charge back agreement form has been returned signed to the Building Division, then full plan review process may be able to begin.

Please contact us with any questions, 303.841.1970.



PARKER
COLORADO

Project Reviews Town of Parker



6/13/2022	7/4/2022	7/13/2022	CENTURYLINK COMMUNICATIONS 20	CenturyLink	NO COMMENT	01 review
-----------	----------	-----------	-------------------------------	-------------	------------	-----------

Notes:

From: PlatReview <PlatReview@lumen.com>
 Sent: Monday, July 4, 2022 9:41 AM
 To: Byerhof, Carson <cbyerhof@parkeronline.org>
 Cc: Benson, William <William.Benson2@lumen.com>
 Subject: RE: Referral Agency Response Request

Requester,

Our engineer has reviewed this plat and their comments are: "I have reviewed this project and have no objections or comments."
 If you require signatures, you can contact the engineer CC'd on this email and if you have any further questions, please don't hesitate to reach out.

Thank you!
 Lumen Plat Review

-----Original Message-----
 From: cbyerhof@parkeronline.org <cbyerhof@parkeronline.org>
 Sent: Monday, June 13, 2022 5:29 PM
 To: PlatReview <PlatReview@lumen.com>
 Subject: Referral Agency Response Request

CAUTION: This email originated outside of Lumen Technologies. Do not click links or open attachments unless you recognize the sender and know the content is safe.

6/13/2022	6/24/2022	7/13/2022	CHERRY CREEK BASIN WATER QUALITY AUTHORITY 20	Rich Borchardt	ADVISORY COMMENTS	See Comments
-----------	-----------	-----------	---	----------------	-------------------	--------------

Notes:

1. The Authority's Control Regulation 72 requires construction and post-construction Best Management Practices (BMPs).
2. No exceptions taken with the construction BMP plan
3. Provide description of post construction BMPs (permanent water quality) for the site.
4. The Authority reserves the right to review and comment on future referrals for the project.

6/13/2022		7/13/2022	COMCAST 20	Butch Buster		01 review
-----------	--	-----------	------------	--------------	--	-----------

Notes:

6/13/2022	7/15/2022	7/13/2022	CONST PLANS - ENVIRONMENTAL	Michael Walton	REVISIONS REQUIRED	See Stormwater Memo
-----------	-----------	-----------	-----------------------------	----------------	--------------------	---------------------

Notes:

6/13/2022	7/15/2022	7/13/2022	CONST PLANS - STORMWATER	Michael Walton	REVISIONS REQUIRED	See Stormwater Memo
-----------	-----------	-----------	--------------------------	----------------	--------------------	---------------------

Notes:



PARKER
COLORADO

Project Reviews Town of Parker



6/13/2022	8/8/2022	7/13/2022	CONSTRUCTION PLANS - CIVIL	Michael Walton	ADVISORY COMMENTS	See Notes
<p>Notes:</p> <p>Please consider routing Inlet SDI-02 directly to SDI-01. As proposed, SDMH-02 will require closure of the drive thru for any maintenance activities which could have a significant impact on business during maintenance activities. This configuration would also eliminate the need for the additional manhole structure potentially providing some savings in construction costs.</p>						
6/13/2022	7/6/2022	7/13/2022	DOUGLAS COUNTY ASSESSORS OFFICE 20	Marian Woodward	NO COMMENT	01 review
<p>Notes:</p>						
6/13/2022		7/13/2022	DOUGLAS COUNTY ENGINEERING DIVISION 20	DC Referrals		01 review
<p>Notes:</p>						
6/13/2022	7/12/2022	7/13/2022	DOUGLAS COUNTY PLANNING SERVICES DIVISION 20	DC Referrals	ADVISORY COMMENTS	01 review
<p>Notes:</p> <p>Addressing Comments: The proposed address is 12211 SLICEROO DRIVE. This address is not to be used for any purpose other than for plan review until after this project is approved. Proposed addresses are subject to changes as necessary for 911 dispatch and life safety purposes.</p> <p>Addresses are recorded by Douglas County following all necessary approvals. Send confirmation of project approval to this office by email. Contact DCAddressing@douglas.co.us or 303.660.7411 with questions.</p>						
6/13/2022		7/13/2022	DOUGLAS COUNTY SCHOOL DISTRICT RE1 20	Shavon Caldwell		01 review
<p>Notes:</p>						
6/13/2022	7/29/2022	7/13/2022	DRAINAGE REPORT - CIVIL	Alex Mestdagh	NO COMMENT	01 review
<p>Notes:</p>						
6/13/2022	7/15/2022	7/13/2022	DRAINAGE REPORT - STORMWATER	Michael Walton	REVISIONS REQUIRED	See Stormwater Memo
<p>Notes:</p> <p>Provide a drainage conformance letter specific to this site plan application.</p>						
6/13/2022		7/13/2022	ECONOMIC DEVELOPMENT 20	Bo Martinez		01 review
<p>Notes:</p>						



PARKER
COLORADO

Project Reviews Town of Parker



6/13/2022	6/27/2022	7/13/2022	FIRE LIFE SAFETY 20	Randy Capra	REVISIONS REQUIRED	See Notes
<p>Notes:</p> <p>The site plan does not work with regard to emergency access; the long dead end... at approximately 260 feet must be addressed. See response letter named "SP22-041 Douglas 234 F6 AMD1 L4 Dunkin Donuts Fire Life Safety Response Ltr [1] Submittal 062722" for comments.</p>						
6/13/2022	7/29/2022	7/13/2022	FLOODPLAIN DEVELOPMENT PLAN	Alex Mestdagh	NOT APPLICABLE	01 review
<p>Notes:</p>						
6/13/2022	7/13/2022	7/13/2022	IREA 20	Brooks Kaufman	REVISIONS REQUIRED	01 review
<p>Notes:</p> <p>The applicant will be required to provide transformer and EUSERC Cabinet locations. The applicant will be required to meet clearance requirements per the attached CORE Builder Handbook.</p>						
6/13/2022	7/29/2022	7/13/2022	PLAT - CIVIL	Alex Mestdagh	NOT APPLICABLE	01 review
<p>Notes:</p>						
6/13/2022	7/11/2022	7/13/2022	POLICE 20	Greg Epp	NO COMMENT	01 review
<p>Notes:</p>						
6/13/2022	7/12/2022	7/13/2022	PUBLIC SERVICE COMPANY OF COLORADO 20	Donna George	ADVISORY COMMENTS	see New Notes
<p>Notes:</p> <p>The property owner/developer/contractor must complete the application process for any new natural gas service via xcelenergy.com/InstallAndConnect. It is then the responsibility of the developer to contact the Designer assigned to the project for approval of design details</p>						
6/13/2022	8/8/2022	7/13/2022	SITE PLAN - CIVIL	Michael Walton	APPROVED	01 review
<p>Notes:</p>						
6/13/2022	7/15/2022	7/13/2022	SITE PLAN - STORMWATER	Michael Walton	APPROVED	01 review
<p>Notes:</p>						
6/13/2022	7/28/2022	7/28/2022	SITE PLAN 20	Carson Byerhof	REVISIONS REQUIRED	01 review
<p>Notes:</p> <p>Cannot return comments until outstanding items from completeness review have been submitted.</p> <p>Pushing review out until July 28th</p> <p>See attached, "STAFFcomments...Review01"</p>						



PARKER
COLORADO

Project Reviews Town of Parker



6/13/2022		7/13/2022	SOUTH METRO FIRE 20	South Metro Fire		01 review
-----------	--	-----------	---------------------	------------------	--	-----------

Notes:

6/13/2022	8/8/2022	7/13/2022	TRAFFIC IMPACT STUDY - CIVIL	Michael Walton	REVISIONS REQUIRED	See Notes
-----------	----------	-----------	------------------------------	----------------	--------------------	-----------

Notes:
Please note that traffic from the proposed development cannot queue on to the adjacent shared access road or impact adjacent properties. Should traffic issues arise the developer will be required to re-analyze and make any necessary improvements to mitigate the issue. Please add text in the narrative acknowledging this within the TIS.

6/13/2022	7/13/2022	7/13/2022	URBAN DRAINAGE AND FLOOD CONTROL 20	UDFCD	NO COMMENT	01 review
-----------	-----------	-----------	-------------------------------------	-------	------------	-----------

Notes:
Good Morning,

We have no comment on Referral Response Request: Douglas 234 F6 AMD 1 L4 - Dunkin Donuts (SP22-041). We appreciate the opportunity to review. Please let me know if you have any questions or concerns.

Thank you,
Pieter van Leeuwen

Pieter Van Leeuwen
Student Intern | (He, Him, His)
MILE HIGH FLOOD DISTRICT
2480 W. 26th Ave. Suite 156-B | Denver, Colorado 80211
Office: 303-455-6277 | | www.udfcd.org
Comment letter attached

Review Group: SP 1ST 20 ADD

6/13/2022	7/12/2022	7/13/2022	PARKER WATER AND SANITATION DISTRICT 20	Robert Ramsey	REVISIONS REQUIRED	01 review
-----------	-----------	-----------	---	---------------	--------------------	-----------

Notes:
Please see the uploaded documents.
Please note PWSD requires all documents to have original signatures.
Please feel free to contact me with any questions.
Robert

6/13/2022		7/13/2022	DOUG 234 HORSE CREEK HOA 20	Lauren Hill		01 review
-----------	--	-----------	-----------------------------	-------------	--	-----------

Notes:



PARKER
COLORADO

Project Reviews Town of Parker



Review Group: SP 2ND 15

9/20/2023	10/12/2023	10/11/2023	BUILDING 15	Randy Sale	APPROVED	No response required, See notes
-----------	------------	------------	-------------	------------	----------	------------------------------------

Notes: **RICK RESPONSE: NOTED.**

We highly encourage a Building pre-application meeting before applying for the permit to discuss access requirements during construction, construction type, occupancy, allowable areas, MEP's, energy, structural, fire, etc... Please visit our website for all plan submittal requirements: Plan Review | Town of Parker - Official Website (parkeronline.org), and our most current code adoptions.

Please know the Town's Charge Back Agreement may be required for this project, specific to the building permit application. The form will be emailed to the applicant prior to the Building Pre-App meeting or upon receiving the permit application submittal. Once all required documents have been accepted and the charge back agreement form has been returned signed to the Building Division, then the full plan review process will begin.

General Comments to be aware of: **RICK RESPONSE: NOTED.**

Building and/or Fire Life Safety permit application will not be accepted/reviewed until the associated site plan is approved or otherwise discussed. All plans submitted for Building's review must meet the 2021 I-Codes, ICC A117.1-2017 for accessibility, the 2020 NEC, and the referenced NFPA editions noted in the applicable codes (i.e., 2021 IFC references the 2019 edition of NFPA 72) if received by December 31, 2024. NFRC certificates, interior/exterior lighting along with the mechanical and envelope compliance path must be included with the original submittal. All Fire Permit applications and inspections will be handled through the Parker Building Division. All land use applications and the associated Grading Permit must be approved/issued per Planning and Public Works prior to the Building Permit being approved/issued.

Retaining walls greater than 4' from base of footing or bottom course requires separate building permits and plans must be stamped by a qualified professional. Tiered, staggered, stepped back retaining walls all require permits no matter the height of individual wall.

9/20/2023	9/22/2023	10/11/2023	CHERRY CREEK BASIN WATER QUALITY AUTHORITY 15	Val Endyk	ADVISORY COMMENTS	See Notes
-----------	-----------	------------	---	-----------	----------------------	-----------

Notes: **RICK RESPONSE: NOTED.**

The Cherry Creek Basin Water Quality Authority (Authority) acknowledges notification from the Town of Parker that the proposed development plans for SP22-041, Douglas 234 F6 AMD 1 L4 - Dunkin Donuts have been or will be reviewed by the Town of Parker for compliance with the applicable Regulation 72 construction and post-construction requirements. Based on the Authority's current policy, the Authority will no longer routinely conduct a technical review and instead the Authority will defer to the Town of Parker's review and ultimate determination that the proposed development plans comply with Regulation 72.

If a technical review of the proposed development plan is needed, please contact LandUseReferral@ccbwwqa.org. The review may include consultation with the Authority's Technical Manager to address specific questions or to conduct a more detailed Land Use Review, if warranted.



PARKER
COLORADO

Project Reviews Town of Parker



9/20/2023	10/11/2023	10/11/2023	CONST PLANS - ENVIRONMENTAL 15	Robert Seacat	REVISIONS REQUIRED	See Engineering Memo and Comments
-----------	------------	------------	--------------------------------	---------------	--------------------	-----------------------------------

Notes:

SP22-041 – Douglas 234 F6 AMD 1 L4 - Dunkin Donuts, 2nd, 10-11-23

RICK RESPONSE: PLEASE SEE PROVIDED RESPONSE LETTER AND REVISED PLANS IN THE RESUBMITTAL PACKAGE FOR THE ADDRESSED REDLINES.

GENERAL COMMENTS for ALL Erosion Control Plan Sheets

Please note that a CBMP Estimate will be required and reviewed with the Grading Permit after all CBMP comments have been addressed and the final site plan is near approval.

1. Please add a note stating – “THE TRUE LOCATION OF THE VTC, CWA, and PTs MAY BE DETERMINED BY THE TOWN AND THE ECS”.
2. Please add a note stating – “MASONRY WORK PROTECTION IS REQUIRED FOR CONSTRUCTION OF BUILDINGS”.
3. Please add a note stating – “ANY ONSITE BULK FUEL STORAGE REQUIRES A FIRE LIFE SAFETY PERMIT FROM THE TOWN OF PARKER PRIOR TO INSTALLATION”. Contact Randy Capra at 303-805-3136 or rcapra@parkeronline.org for FLS Permit questions.
4. Please show multiple Portable Toilet Protections (PTP), a site this size must have at least 2 at initial phase. Addition PTPs may be needed in the interim and final phases.
5. Please provide and identify in curb line rock sock protection (4) on Slicero Drive to the southeast, down gradient of site. Follow the Inlet Protection Curb on Grade detail for installation.

INITIAL CBMP PLANS

6. Please consider moving the Vehicle Tracking Control (VTC) to the north end of Slicero Drive. This configuration helps limit the amount of Stormwater Sheet Flow washing over the VTC and flowing off-site during a rain event. Please provide and identify construction fence along the sides of the VTC to assure use of the entire 50-foot pad.

INTERIM/FINAL CBMP PLANS

7. Provide and identify Masonry Work Protection (MWP) on the plans in two locations for Construction of the building.
8. Please remove ALL Traffic Striping Arrows from the CBMP Drawings to avoid confusion with the stormwater flow arrows.

9/20/2023	10/11/2023	10/11/2023	CONSTRUCTION PLANS - CIVIL 15	Michael Walton	REVISIONS REQUIRED	See Engineering Memo
-----------	------------	------------	-------------------------------	----------------	--------------------	----------------------

Notes:

9/20/2023	10/11/2023	10/11/2023	DRAINAGE REPORT - CIVIL 15	Michael Walton	REVISIONS REQUIRED	See Engineering Memo
-----------	------------	------------	----------------------------	----------------	--------------------	----------------------

Notes:

9/20/2023	9/26/2023	10/11/2023	FIRE LIFE SAFETY 15	Randy Capra	REVISIONS REQUIRED	See latest response letter and provide a written response
-----------	-----------	------------	---------------------	-------------	--------------------	---

Notes:

9/20/2023	10/3/2023	10/11/2023	IREA 15	Brooks Kaufman	REVISIONS REQUIRED	Provide transformer and EUSERC Cabinet locations
-----------	-----------	------------	---------	----------------	--------------------	--

Notes: **RICK RESPONSE: PLEASE SEE PROVIDED RESPONSE LETTER AND REVISED PLANS IN THE RESUBMITTAL PACKAGE FOR THE ADDRESSED REDLINES.**

The applicant will be required to provide transformer and EUSERC Cabinet locations and meet CORE’s requirements per the attached builder handbook. In addition, the proposed trash enclosure and sign may not encroach into the 15-foot utility easement.



PARKER
COLORADO

Project Reviews Town of Parker



9/20/2023	10/11/2023	10/11/2023	SITE PLAN - CIVIL 15	Michael Walton	APPROVED	
Notes:						
9/20/2023	10/16/2023	10/11/2023	SITE PLAN 15	Ashley Chasez	REVISIONS REQUIRED	See notes
Notes: RICK RESPONSE: PLEASE SEE PROVIDED RESPONSE LETTER AND REVISED PLANS IN THE RESUBMITTAL PACKAGE FOR THE ADDRESSED REDLINES. Only one minor change, all rock has to be 2" or larger. Will need to review again changes are made to address other reviewer's comments and once the color elevations are submitted.						
9/20/2023	10/11/2023	10/11/2023	TRAFFIC IMPACT STUDY - CIVIL 15	Michael Walton	REVISIONS REQUIRED	See Engineering Memo
Notes:						
Review Group: SP 2ND 15 ADD						
9/20/2023	10/11/2023	10/11/2023	PARKER WATER AND SANITATION DISTRICT 15	Robert Ramsey	REVISIONS REQUIRED	See Notes
Notes: RICK RESPONSE: PLEASE SEE PROVIDED RESPONSE LETTER AND REVISED PLANS IN THE RESUBMITTAL PACKAGE FOR THE ADDRESSED REDLINES. Please see uploaded red lined plans and comment letter.						