
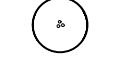
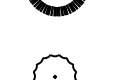
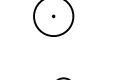
 








SITE DEVELOPMENT PLAN HORSE CREEK OFFICE BUILDING

LOT 10B, DOUGLAS 234 FILING NO. 6, AMENDMENT 2
A PORTION OF THE SW 1/4, SE 1/4, SECTION 29, T6S, R66W, 6TH P.M.
TOWN OF PARKER, COUNTY OF DOUGLAS, STATE OF COLORADO

PLANT LEGEND

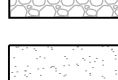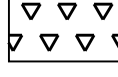
-  DECIDUOUS CANOPY TREES
-  ORNAMENTAL TREES
-  EVERGREEN TREES
-  EVERGREEN SHRUBS
-  DECIDUOUS SHRUBS
-  PERENNIALS
-  NATIVE GRASS
-  3/4" - 2" RIVER ROCK MULCH
-  BLUEGRASS TURF
-  WOOD MULCH
-  6" Fence

NATIVE GRASS:

PBSI Foothills Native Mix
 Ingredients: Switchgrass, Rocky Mountain Fescue, Big Bluestem, Sandberg Bluegrass, Slender Wheatgrass, Thickspike/Streambank/Western Wheatgrass, Yellow Indiangrass, Blue Grama, Beardless Wheatgrass, Indian Ricegrass, Little Bluestem, Sand Dropseed, Sideoats Grama
 Seeding Rate: 25 lbs/Acre to be used between October 15th and March 30th
 Pawnee Buttes Seed, Inc.
 605 25th St.
 Greeley, Colorado
 (970) 356-7002

PROPOSED PLANT LIST


PLANTING SCHEDULE								
TYPE	KEY	QTY	BOTANICAL NAME	COMMON NAME	PLANTING SIZE	SIZE AT MATURITY	NOTES	WATER USE
Trees								
Deciduous	AGL	2	Aesculus glabra	Ohio Buckeye	2.5" Cal	20'-40'	B & B	M
	CO	3	Celtis Occidentalis	Western Hackberry	2.5" Cal	50'	B & B	M
	GD	3	Gumnocladus Dioicus	Kentucky Coffeetree	2.5" Cal	50'	B & B	L
	TCG	5	Tilia Cordata 'Greenspire'	Greenspire Linden	2.5" Cal	50'	B & B	M
	QM	3	Quercus macrocarpa	Bur Oak	2.5" Cal	60'	B & B	M
Ornamental	CCI	6	Crataegus crus-galli inermis	Thornless Cockspur Hawthorn	2" Cal	15'-20'	B & B	M
	CC	4	Cercis canadensis	Eastern Redbud	2" Cal	20'-30'	B & B	M
	MSS	3	Malus 'Spring Snow'	Spring Snow Crabapple	2" Cal	15'-20'	B & B	M
Evergreen	JV	10	Juniperus scopulorum	Rocky Mountain Juniper	6" Ht	15'-20'	B & B	L-M
	PN	6	Pinus Nigra 'Arnold's Sentinel'	Austrian Pine	6" Ht	40'-60'	B & B	M
Shrubs								
Deciduous	AxC	6	Arctostaphylos X Coloradoensis	Panchito Manzanita	5 Gal	3'	5' OC	L
	CxC	4	Arctostaphylos x coloradoensis	Panchito Manzanita	5 Gal	4'	4' OC	L
	BTC	37	Berberis thunbergii 'Crimson Pygmy'	Crimson Pygmy Japanese Barberry	5 Gal	2'-3'	5' OC	L
	EAC	9	Euonymus alatus 'Compactus'	Dwarf Burning Bush	5 Gal	6'-8'	3' OC	L
	SNS	33	Spiraea nipponica 'Snowmound'	Snowmound Spiraea	5 Gal	3'-4'	3' OC	L
	SPK	7	Syringa patula 'Miss Kim'	Miss Kim Lilac	5 Gal	6'-8'	5' OC	L
	LX	11	Ligustrum x vicaryi	Golden Vicary Privet	5 Gal	6'-8'	4' OC	L
Evergreen	PG	6	Picea pungens 'Globosa'	Globe Spruce	5 Gal	3'-5'	5' OC	L
	JSBR	7	Juniperus sabina 'Broadmoor'	Broadmoor Juniper	5 Gal	1'-2'	5' OC	L
Perennials & Ornamental Grasses								
Perennials	MSG	34	Miscanthus Sinensis 'Gracillimus'	Maiden Grass	5 Gal		4' OC	L
	PAH	75	Pennisetum alopecuroides 'Homeln'	Dwarf Fountain Grass	2 Gal		18" OC	L
	HHR	8	Hermerocallis 'Happy Returns'	Dwarf Yellow Daylily	1 Gal		18" OC	L
	KA	31	Calamagrostis X Acutiflora 'Karl Forester'	Karl Forester Grass	1 Gal		4' OC	L

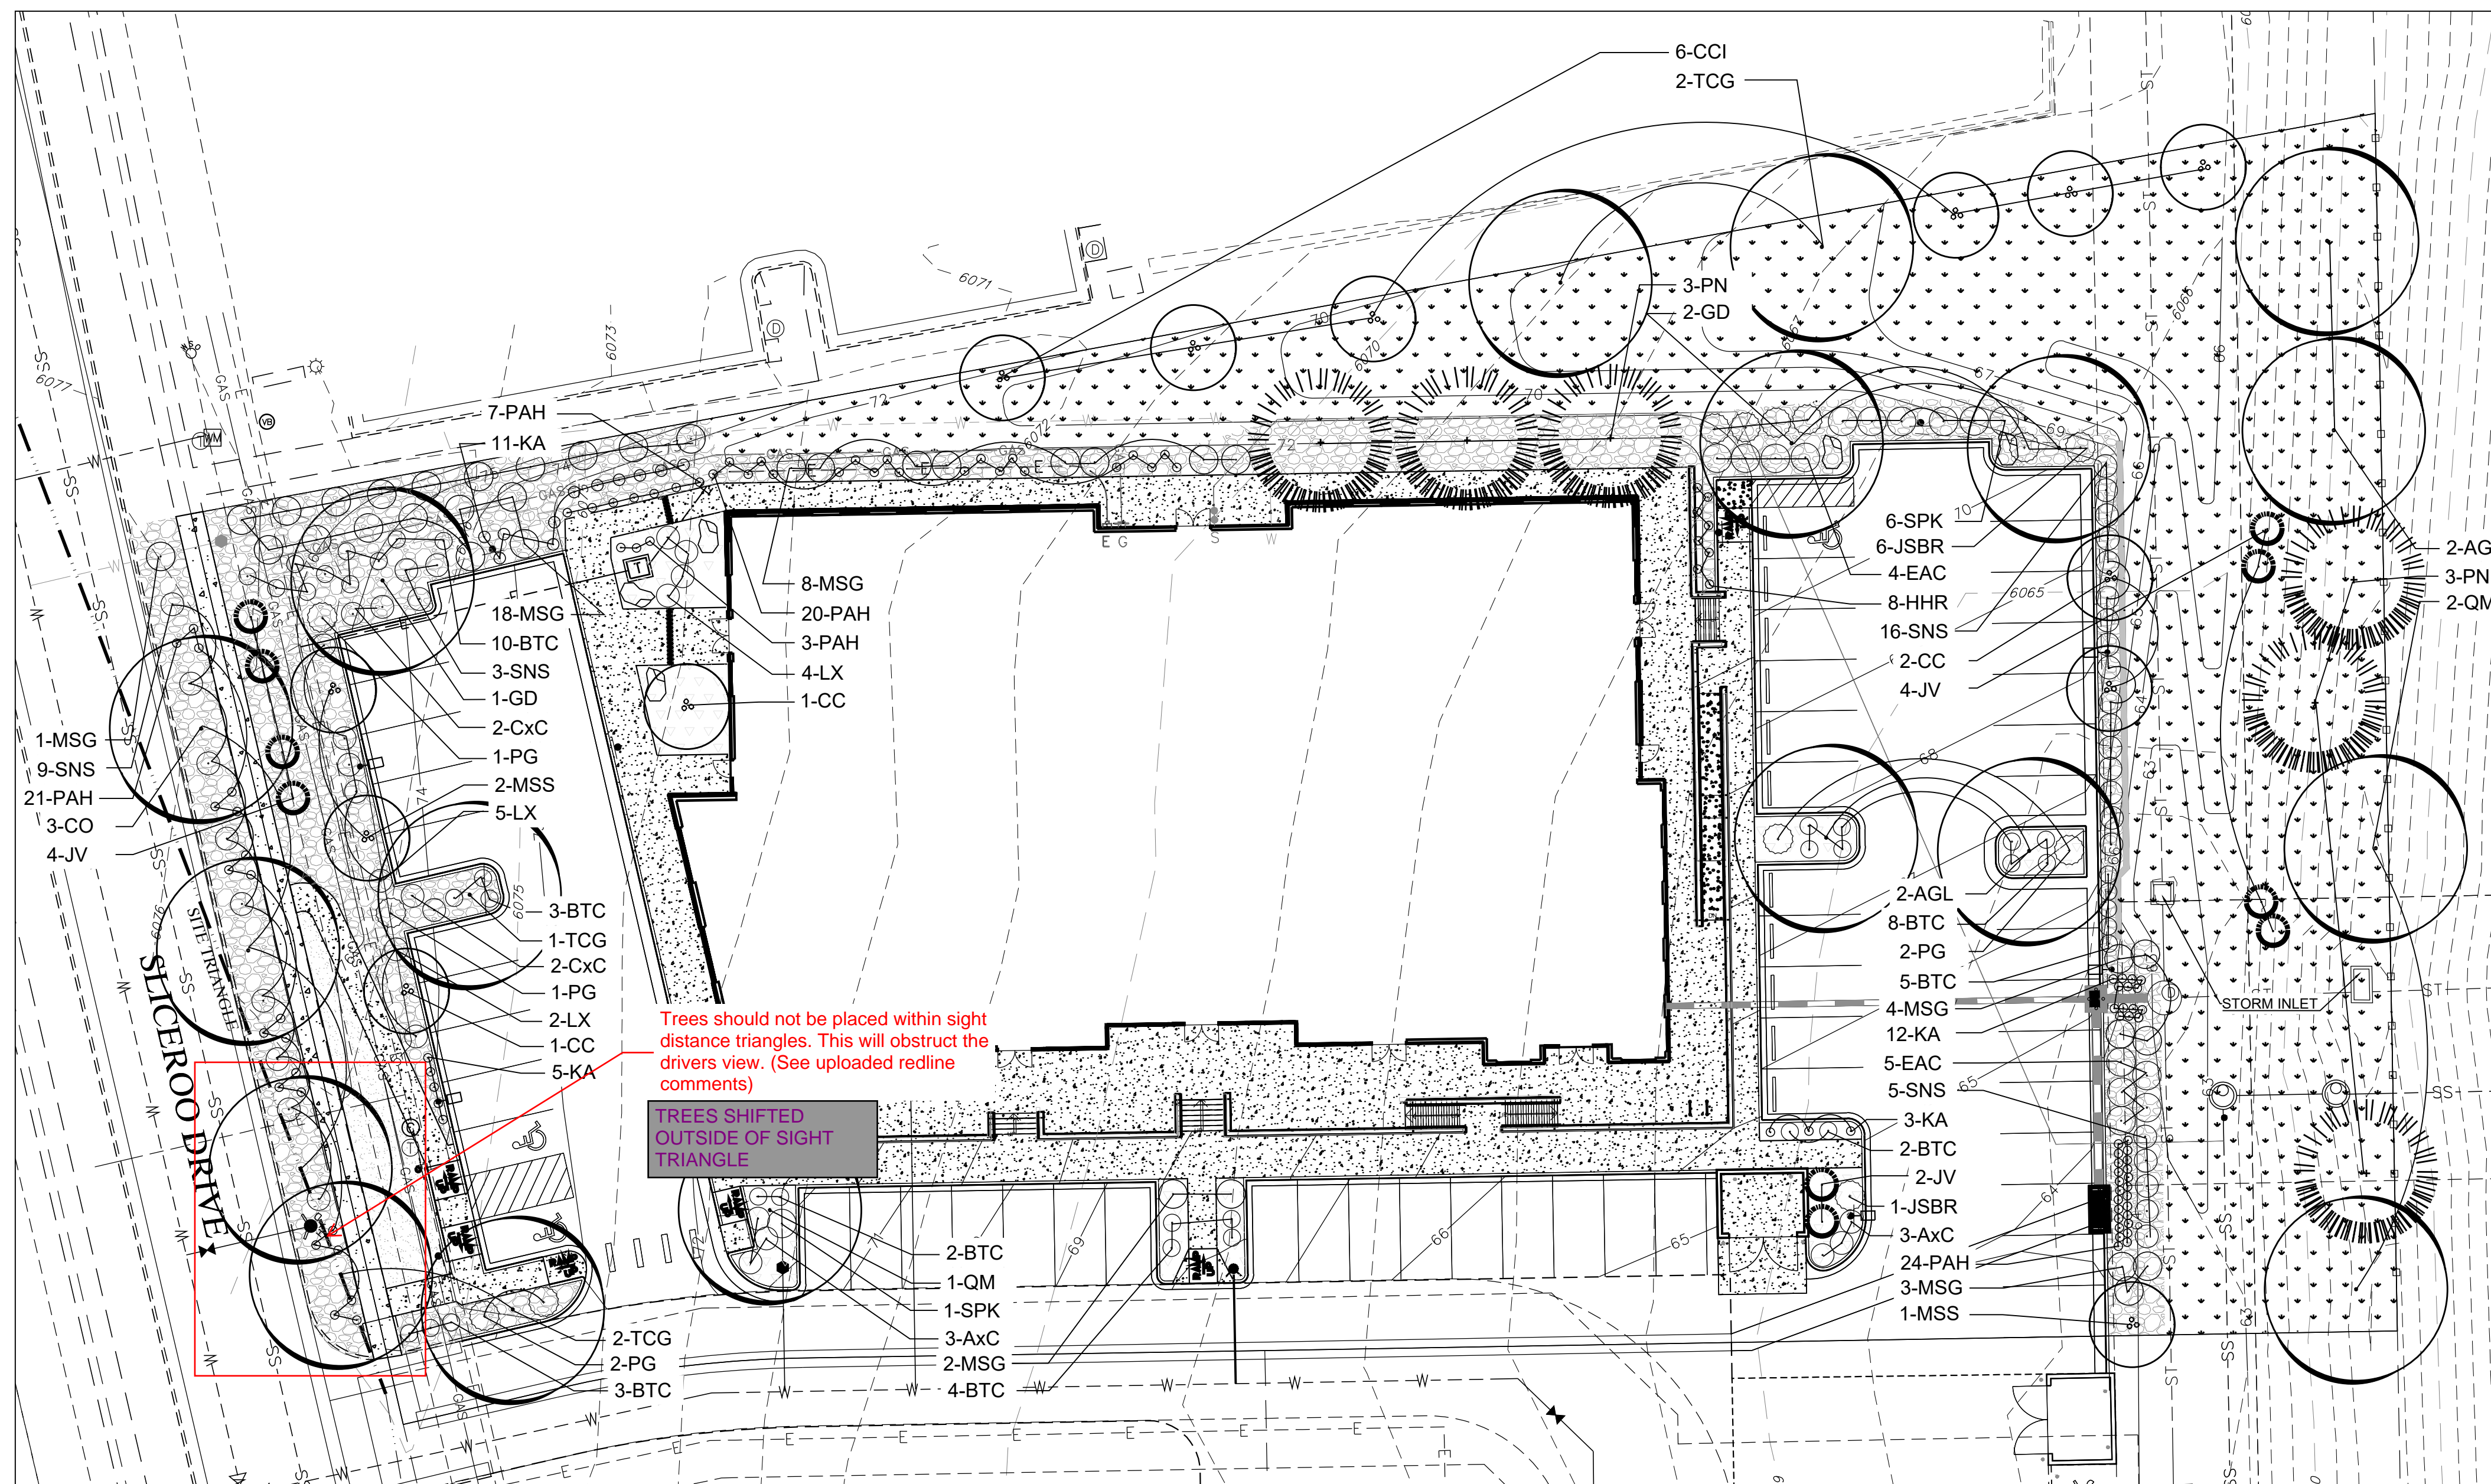

Trees should not be placed within sight distance triangles. This will obstruct the drivers view. (See uploaded redline comments)

TREES SHIFTED OUTSIDE OF SIGHT TRIANGLE

Scale: 1"=20'

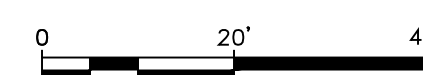

LANDSCAPE PLAN
DOUGAS 234 FILING NO. 6, AMD. 2
DATE: OCTOBER 2, 2025
SHEET _ OF _

