

### GENERAL PHASING NOTES

- PHASE 1 (PRE-CONSTRUCTION)
- INSTALLATION OF EROSION CONTROL SILT FENCE.
  - DEMOLITION OF EXISTING SITE IMPROVEMENTS.
  - REMOVAL OF EXISTING PAVEMENT ON THE SITE.
    - SILT FENCE
    - CONSTRUCTION VEHICLE TRACKING CONTROL
    - STABILIZED STAGING AREA
    - SANITARY FACILITIES
    - ROCK SOCKS
- PHASE 2 (DURING GRADING, AND PAVING)
- INSTALLATION OF ALL STORM WATER DRAINAGE IMPROVEMENTS.
  - ROUGH GRADING.
  - CONSTRUCTION OF NEW SITE IMPROVEMENTS.
  - FINAL GRADING.
    - CONCRETE WASHOUT AREA
    - PRIOR TO ANY CONCRETE WORK
    - SEEDING AND MULCHING
    - STOCKPILES OVER 7-DAYS IDLE
    - INLET PROTECTION FOR PROPOSED ONCE INSTALLED
- PHASE 3 (POST PAVING)
- PLACEMENT OF FINAL LANDSCAPING ITEMS AND SOD.
  - REMOVAL OF EROSION CONTROL FENCE.
    - FINAL LANDSCAPE INSTALLATION PER LANDSCAPE PLANS
    - REMOVE REMAINING EROSION CONTROL BMP'S ONCE STABILIZED

### CONSTRUCTION EGRESS NOTES

- ALL GEOTECHNICAL ANALYSIS HAS BEEN PERFORMED ON THIS SITE. REFER TO PROJECT MANUAL FOR GEOTECHNICAL ANALYSIS REQUIREMENTS.
- FOLLOW GEOTECHNICAL ANALYSIS RECOMMENDATIONS FOR SITE EXCAVATION REQUIREMENTS.
- REFER TO STRUCTURAL DRAWINGS FOR BUILDING EXCAVATION REQUIREMENTS.

### EROSION CONTROL & MAINTENANCE PLAN NOTES

- RETAIN FLOATABLE WIND BLOWN MATERIALS ON SITE BY STORING ALL TRASH AND BUILDING MATERIAL WASTE IN ENCLOSURES UNTIL PROPER DISPOSAL AT OFF-SITE FACILITIES. CHECK ADJACENT AREAS DAILY AND PICK UP CONSTRUCTION WASTE MATERIALS AND DEBRIS THAT HAVE BLOWN OR WASHED OFF SITE.
- PERMANENTLY STABILIZE ALL SURFACE AREA WITHIN AND ADJACENT TO THIS SITE THAT IS DISTURBED BY VEHICLES, GRADING AND OTHER CONSTRUCTION FOR THE PROPOSED FACILITY. STABILIZATION IS OBTAINED WHEN THE DISTURBED SURFACE IS COVERED WITH STRUCTURES, PAVING AND OR PERENNIAL VEGETATION HAVING A UNIFORM COVERAGE DENSITY OF AT LEAST 70%. STABILIZATION OF ALL DISTURBED AREA IS REQUIRED BEFORE TERMINATING MAINTENANCE AND REMOVAL OF EROSION CONTROL MEASURES.
- CONTRACTORS SHALL INSPECT POLLUTION CONTROL MEASURES AT LEAST ONCE EVERY 24 HOURS AND WITHIN 24 HOURS AFTER A STORM EVENT OF 2 INCH OR GREATER. DAMAGE MEASURES THAT REQUIRE BEING REPAIRED SHALL BE REPLACED WITH MORE EFFECTIVE MEASURES OR ADDITIONAL MEASURES WITHIN SEVEN DAYS. REPEATED FAILURE OF A CONTROL MEASURE REQUIRES INSTALLATION OF A MORE SUITABLE DEVICE TO PREVENT DISCHARGE OF POLLUTANTS FROM THE CONSTRUCTION SITE.
- INSTALLATION OF ADDITIONAL EROSION CONTROL MEASURES MAY BE REQUIRED BY THE CITY CODE. CONTRACTOR TO VERIFY REQUIREMENTS PRIOR TO BEGINNING ANY WORK ON PROJECT SITE.
- CARE SHALL BE TAKEN TO MINIMIZE THE ENCROACHMENT OF SEDIMENT INTO ALL STORM DRAIN APPURTENANCES, PUBLIC STREET AND ONTO PRIVATE PROPERTY UNTIL IMPROVED MATERIAL (ROAD/PARKING AREA SURFACE) IS APPLIED OR UNTIL PROPOSED LANDSCAPE HAS BEEN ESTABLISHED.
- REFER TO SITE DETAILS FOR SILT FENCE CONSTRUCTION.
- ALL GRASS SLOPES WHICH EXCEED 3:1 (H:V) SHALL UTILIZE CONTECH CONSTRUCTION PRODUCTS PERMANENT TURF REINFORCEMENT MATS C35 OR APPROVED EQUAL. MATS SHALL BE INSTALLED PER MANUFACTURER'S SPECIFICATIONS AND STANDARDS. CONTRACTOR SHALL COORDINATE INSTALLATION INSPECTION WITH MANUFACTURER.

### SITE EXCAVATION REQUIREMENTS

- CONSTRUCTION EGRESS SHALL BE 25' MINIMUM WIDTH AND 30' MINIMUM LENGTH AND 6" MIN THICKNESS OF STONE (1.5'-3.5') COARSE AGGREGATE WITH GEOTEXTILE UNDERLINER. REFER TO CITY OR STATE FOR ANY ADDITIONAL REQUIREMENTS.
- THE EXIT SHALL BE MAINTAINED IN A CONDITION WHICH WILL PREVENT TRACKING OF MUD ON TO ADJACENT PUBLIC RIGHT-OF-WAY. THIS SHALL BE REQUIRED PERIODIC TOP DRESSING WITH 1.5-3.5 INCH STONE, AS CONDITIONS DEMAND, AND REPAIR AND/OR CLEAN OUT OF ANY STRUCTURE USED TO TRAP SEDIMENT. ALL MATERIALS SPILLED, DROPPED, WASHED, OR TRACKED FROM VEHICLES OR SITE ONTO ROADWAYS OR INTO STORM DRAINS MUST BE REMOVED IMMEDIATELY.
- WHEELS MUST BE CLEANED TO REMOVE MUD PRIOR TO ENTRANCE ONTO PUBLIC RIGHT-OF-WAY. WHEN WASHING IS REQUIRED, IT SHALL BE DONE ON AN AREA WITH CRUSHED STONE WHICH DRAINS INTO AN APPROVED SEDIMENT TRAP OR SEDIMENT BASIN LOCATED PER CITY OR STATE REQUIREMENTS.

### EROSION CONTROL LEGEND

TITLE	KEY	SYMBOL
CONCRETE WASHOUT AREA	WTA	
PORTABLE TOILET	PT	
VEHICLE TRACKING CONTROL	VT	
ROCK SOCK	RS	
STABILIZED SOIL	SS	
SILT FENCE	SF	
RIPRAP	RR	
DRAIN INLET PROTECTION	DIP	
SEEDING, MULCHING, AND CRIMPING	SMC	
EROSION CONTROL BLANKET ON SLOPES GREATER THAN 3:1 OR WHERE SPECIFIED ON PLAN	ECB	


Add Erosion Control General Notes

Civil Plans must include multiple Erosion Control Plan Sheets referencing the Initial, Interim and Final phases of the project. You can use two plan sheets, Initial and Interim/Final; or three plan sheets, Initial, Interim, and Final. Each Erosion Control Plan must be on a separate Civil Plan sheet, enlarged to provide more detail.

Using three plan sheets is preferred but not required.

## 1 SITE EROSION CONTROL PLAN

C1.2 SCALE: 1" = 20'-0"

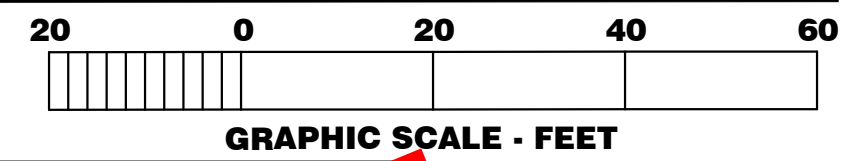

**CAUTION:** INFORMATION ON THIS DRAWING CONCERNING TYPE AND LOCATION OF UNDERGROUND AND OTHER UTILITIES IS NOT GUARANTEED TO BE ACCURATE OR ALL INCLUSIVE. THE CONTRACTOR IS RESPONSIBLE FOR MAKING HIS OWN DETERMINATION AS TO THE TYPE AND LOCATION OF UNDERGROUND AND OTHER UTILITIES AS MAY BE NECESSARY TO AVOID DAMAGE THERETO.

### BENCHMARK

DOUGLAS COUNTY BENCHMARK 1600032, EL=5,903.17 FEET (NAVD88) - 3 1/4" INCH ALUMINUM CAP (DOUGLAS COUNTY GIS SECONDARY CONTROL MONUMENT 1.060032) AT THE SOUTHEAST CORNER OF THE PARKING LOT OF STROH RANCH SUCCKER FIELDS, ON THE NORTH SIDE OF STROH RD, EAST OF THE INTERSECTION OF STROH ROAD AND N. MOTSENBOCKER ROAD, CITY OF PARKER, COLORADO.

### BASIS OF BEARING

BEARINGS SHOWN HEREON ARE BASED ON THE NORTHERLY LINE OF THE NORTHEAST QUARTER OF SECTION 3, TOWNSHIP 7 SOUTH, RANGE 66 WEST OF THE 6TH P.M., MONUMENTED AS SHOWN ON THIS SURVEY PLAT AS BEARING NORTH 89°33'14" EAST, WITH ALL BEARINGS CONTAINED HEREIN RELATIVE THERETO.

Add Parker's COMPLETE List of Keys/Symbols (1st), General Notes (2nd), and Erosion Control Details in ALPHABETICAL Order (3rd), Immediately Following the Final Erosion Control Plan Sheet.



### UNAUTHORIZED CHANGES & USES

THE ENGINEER PREPARING THESE PLANS WILL NOT BE RESPONSIBLE FOR, OR LIABLE FOR, UNAUTHORIZED CHANGES TO OR USES OF THESE PLANS. ALL CHANGES OF THESE PLANS MUST BE IN WRITING AND MUST BE APPROVED BY THE PREPARER OF THESE PLANS PRIOR TO CONSTRUCTION. CONSTRUCTION CONTRACTOR AGREES THAT IN ACCORDANCE WITH GENERALLY ACCEPTED CONSTRUCTION PRACTICES, CONSTRUCTION CONTRACTOR WILL BE REQUIRED TO ASSUME SOLE AND COMPLETE RESPONSIBILITY FOR JOB SITE CONDITIONS DURING THE COURSE OF CONSTRUCTION OF THE PROJECT, INCLUDING SAFETY OF ALL PERSONS AND PROPERTY, THAT THIS REQUIREMENT SHALL BE MADE TO APPLY CONTINUOUSLY AND NOT BE LIMITED TO NORMAL WORKING HOURS, AND CONSTRUCTION CONTRACTOR FURTHER AGREES TO DEFEND, INDEMNIFY AND HOLD DESIGN PROFESSIONAL HARMLESS FROM ANY AND ALL LIABILITY, REAL OR ALLEGED, IN CONNECTION WITH THE PERFORMANCE OF WORK ON THIS PROJECT, EXCEPTING LIABILITY ARISING FROM THE GROSS NEGLIGENCE OF DESIGN PROFESSIONAL.

### NOTE TO CONTRACTOR

THE EXISTENCE AND LOCATION OF ANY UNDERGROUND UTILITIES, PIPES, AND/OR STRUCTURES SHOWN ON THESE PLANS WERE OBTAINED BY A SEARCH OF AVAILABLE RECORDS. THERE MAY BE EXISTING UTILITIES NOT SHOWN ON THESE PLANS. THE CONTRACTOR SHALL ASCERTAIN THE TRUE VERTICAL AND HORIZONTAL LOCATION OF THOSE UNDERGROUND UTILITIES TO BE USED PRIOR TO CONSTRUCTION AND SHALL BE RESPONSIBLE FOR ANY DAMAGE TO ANY PUBLIC OR PRIVATE UTILITIES, SHOWN OR NOT SHOWN HEREON.

THE TOWN OF PARKER REVIEW CONSTITUTES GENERAL COMPLIANCE WITH THE TOWN'S STANDARDS AND APPROVED VARIANCES. SUBJECT TO THESE PLANS BEING STAMPED, SIGNED AND DATED BY THE PROFESSIONAL ENGINEER OF RECORD. REVIEW BY THE TOWN DOES NOT CONSTITUTE APPROVAL OF THE PLAN DESIGN OR ACCURACY OR CORRECTNESS OF ENGINEERING CALCULATIONS. ERRORS IN THE DESIGN OR CALCULATIONS REMAIN THE RESPONSIBILITY OF THE REGISTERED PROFESSIONAL ENGINEER WHOSE STAMP AND SIGNATURE ARE AFFIXED TO THIS DOCUMENT.

THIS REVIEW DOES NOT CONSTITUTE APPROVAL OF ANY PRIVATE ON-SITE IMPROVEMENTS WHICH MAY BE SHOWN. CONSTRUCTION CANNOT COMMENCE UNTIL ALL REQUIRED DRAINAGE/TRAFFIC REPORT(S), FINAL DEVELOPMENT PLAN(S), SPECIAL REVIEW(S), GRADING PERMIT, AND/OR OTHER PERMITS ARE COMPLETE, APPROVED AND ON FILE WITH THE TOWN OF PARKER.

TOWN OF PARKER, DIRECTOR OF ENGINEERING/PUBLIC WORK DATE

PREPARED UNDER THE SUPERVISION OF TAIT & ASSOCIATES, INC.

320 North Lincoln Avenue  
Loveland, CO 80537  
p: 970.613.1447  
www.tait.com  
ENGINEERING ENVIRONMENTAL BUILDING LAND  
Santa Ana Sacramento Denver  
San Luis Obispo Riverside Boise  
Dabas  
Since 1914

**TAIT**  
& ASSOCIATES

STEVEN F. BURCH, PE  
65717  
PROFESSIONAL ENGINEER  
CIVIL  
COLORADO LICENSED

LOT 1 PARKER POINTE SUBDIVISION FILING 1

PROJECT:  
**NEW O'REILLY AUTO PARTS STORE**  
STROH RD  
PARKER, CO #2

**TIMOTHY M. GUILLOT**  
ARCHITECT

1736 East Sunshine, Suite 417  
Springfield, Missouri 65804

417.862.0558  
Fax: 417.862.3265  
e-mail: architect@esterfyschneider.com

**O'Reilly AUTO PARTS**

233 SOUTH PATTERSON  
SPRINGFIELD, MISSOURI 65802  
(417) 862-2674 TELEPHONE

COMM # 4884  
DATE: 02/14/2025  
REVISION  
DATE:

**O'Reilly AUTO PARTS**

C1.2